

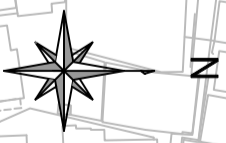
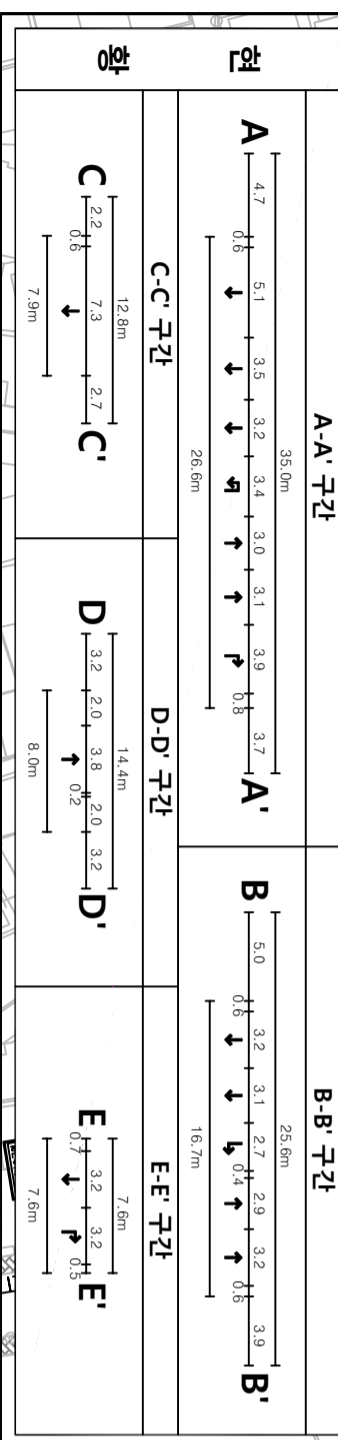


대신시정교차로(개선)

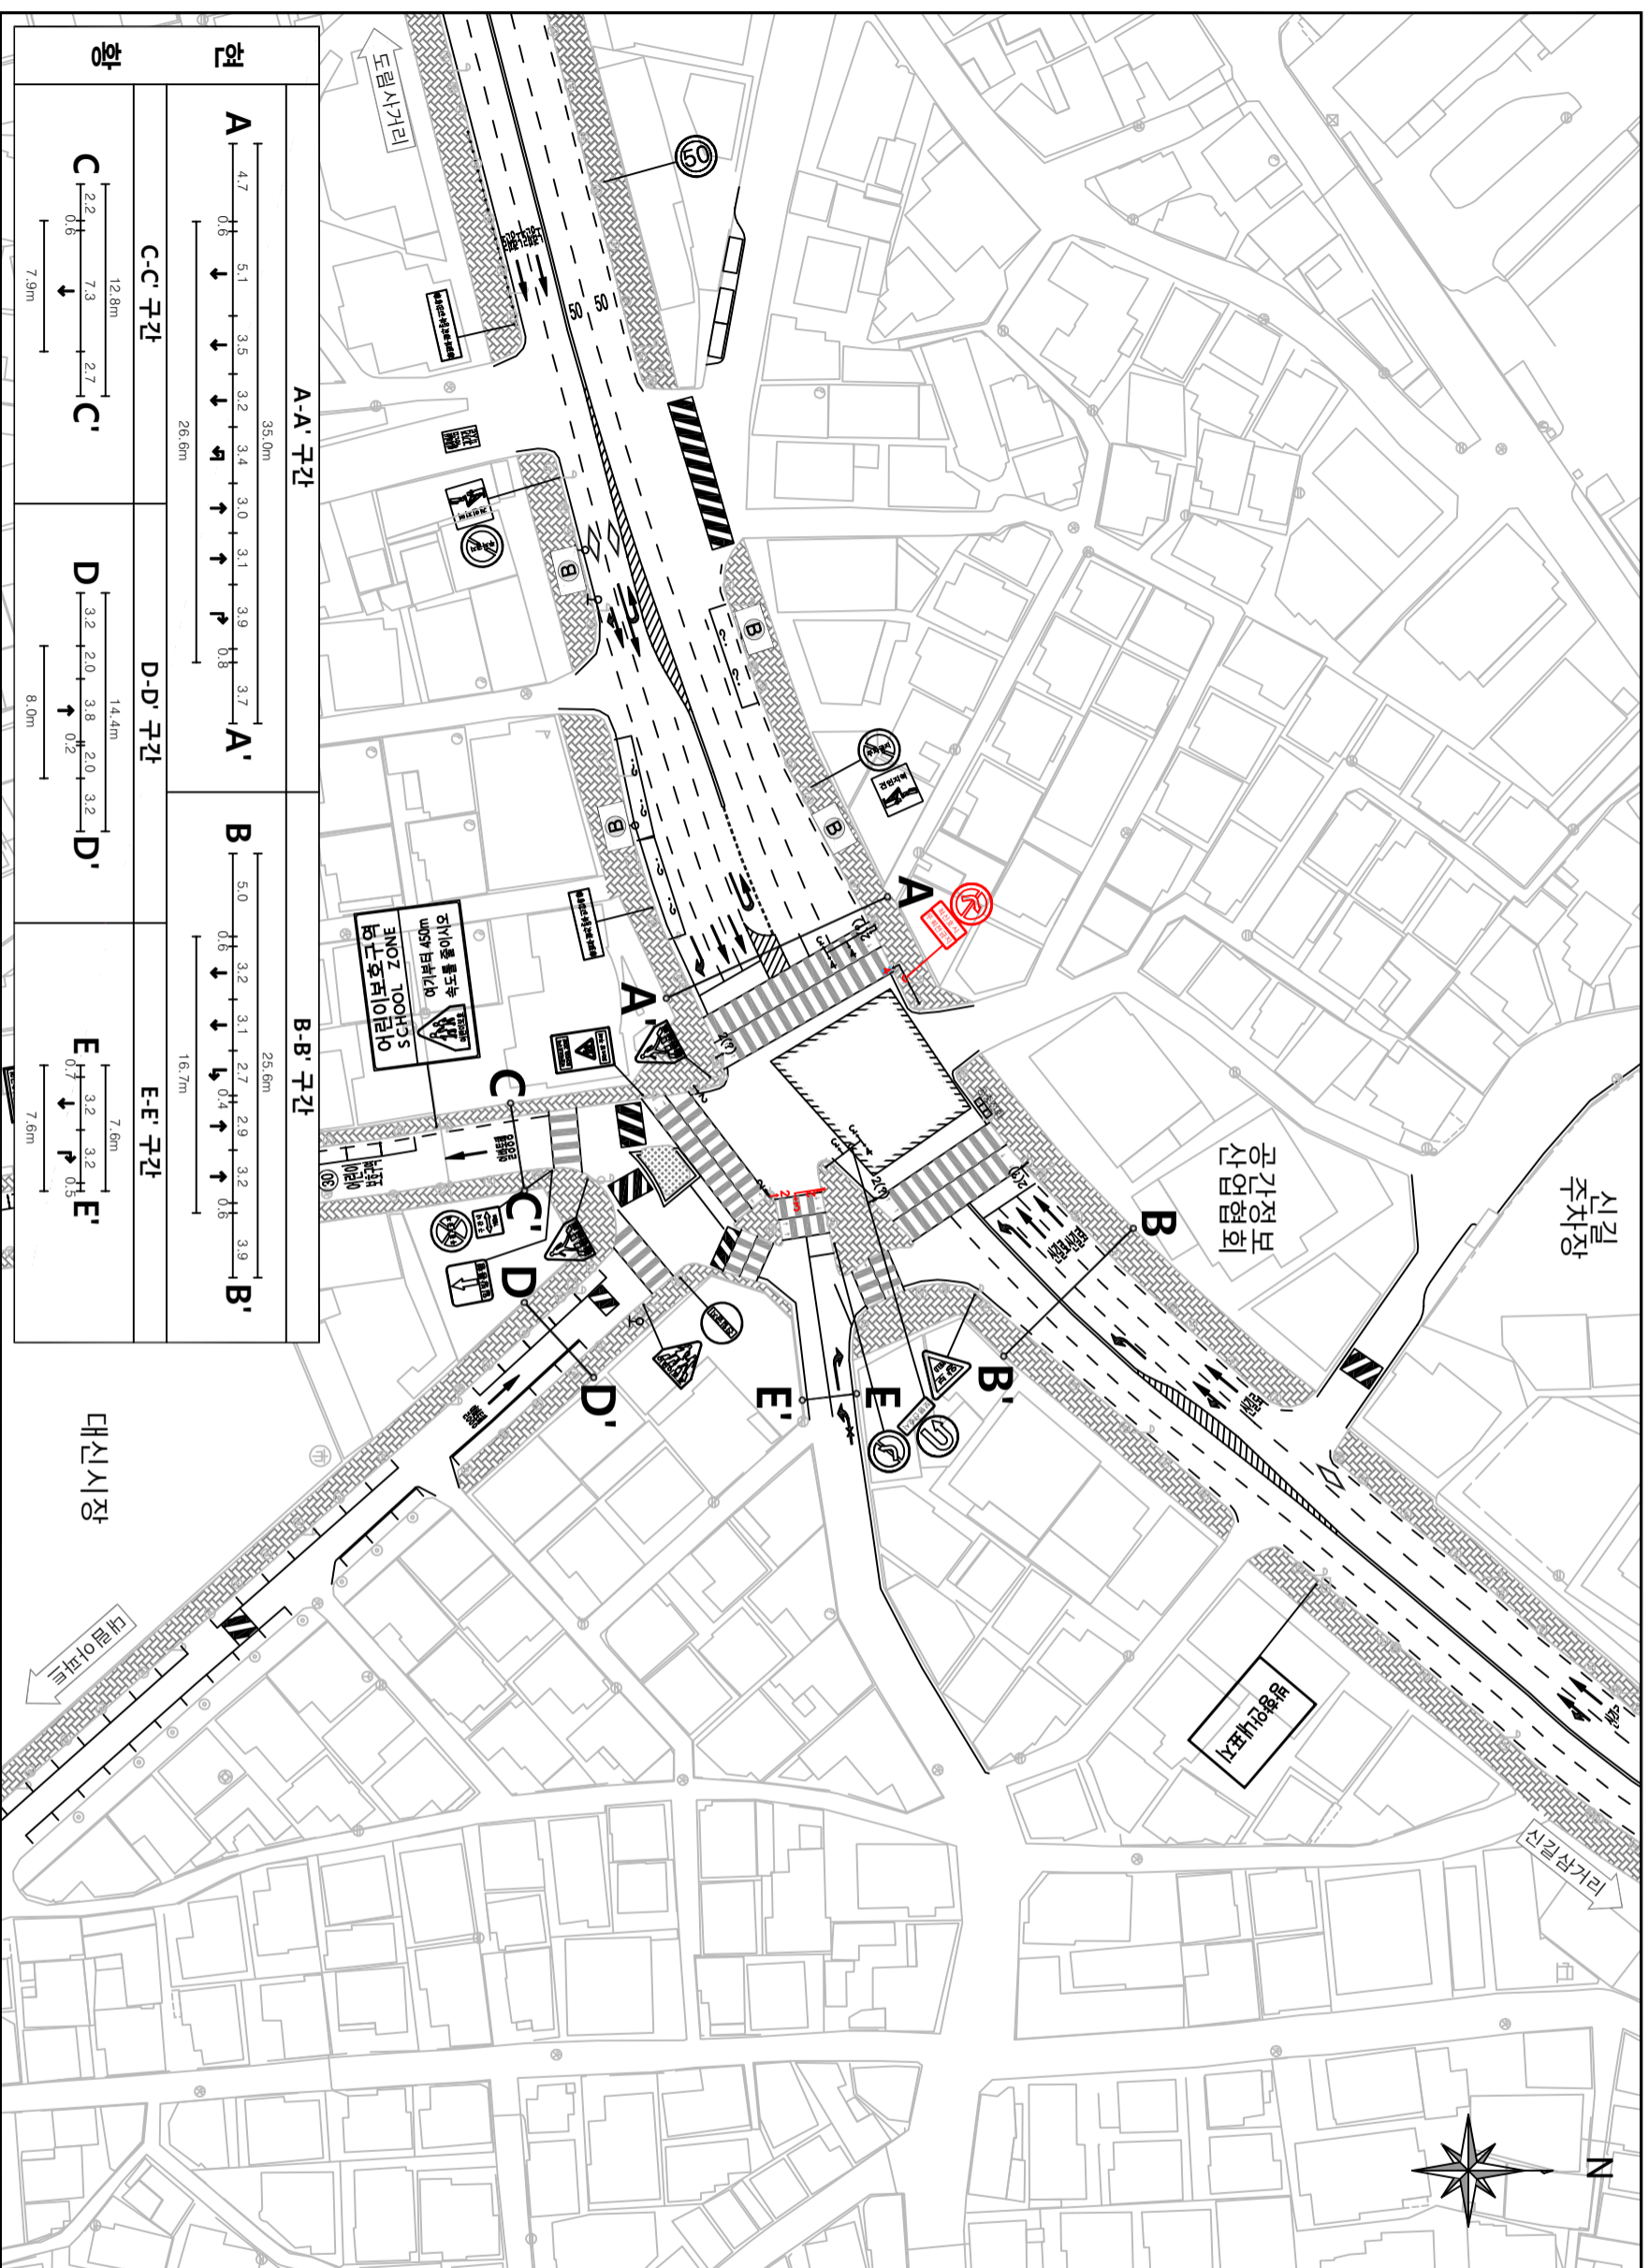

[교통량(차량)]

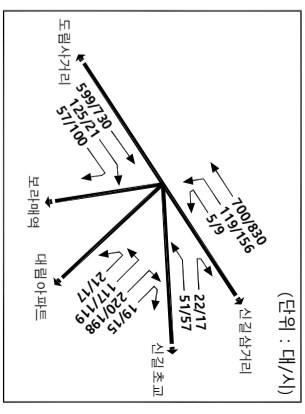

* 오전(08-09시) / 오후(18-19시)

구분	Φ1	Φ2	Φ3	Φ4	Φ5	주기
원형	7(3)	38(3)	29(3)			150초
개선	42(3)	18(3)	25(3)	12(3)	38(3)	150초


* 오후첨두시(18:00-19:00시)기준

구분	평균여객차(호/대)	서비스수준
원형	32.1	C
개선	58.4	D
증감	▲ 26.3	-

범례	현황
(Black line)	현신설계
(Red line)	신설
(Blue line)	제거
(Green line)	이전



발주처	서울특별시	용역명	2018년 도로교통수통개선 기본 및 실시설계	용역사	(주)동일기술공사	설계일자	2018.07	설계참여자	책임자 안정현 02-444-8200	도면번호	대신시정교차로(개선)
-----	-------	-----	--------------------------	-----	-----------	------	---------	-------	---------------------------	------	-------------

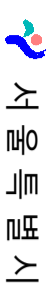

2018년 도로교통수통개선 기본 및 실시설계



2018.07

대신시정교차로(개선)