



월계3차 삼호아파트 31동앞(개선)

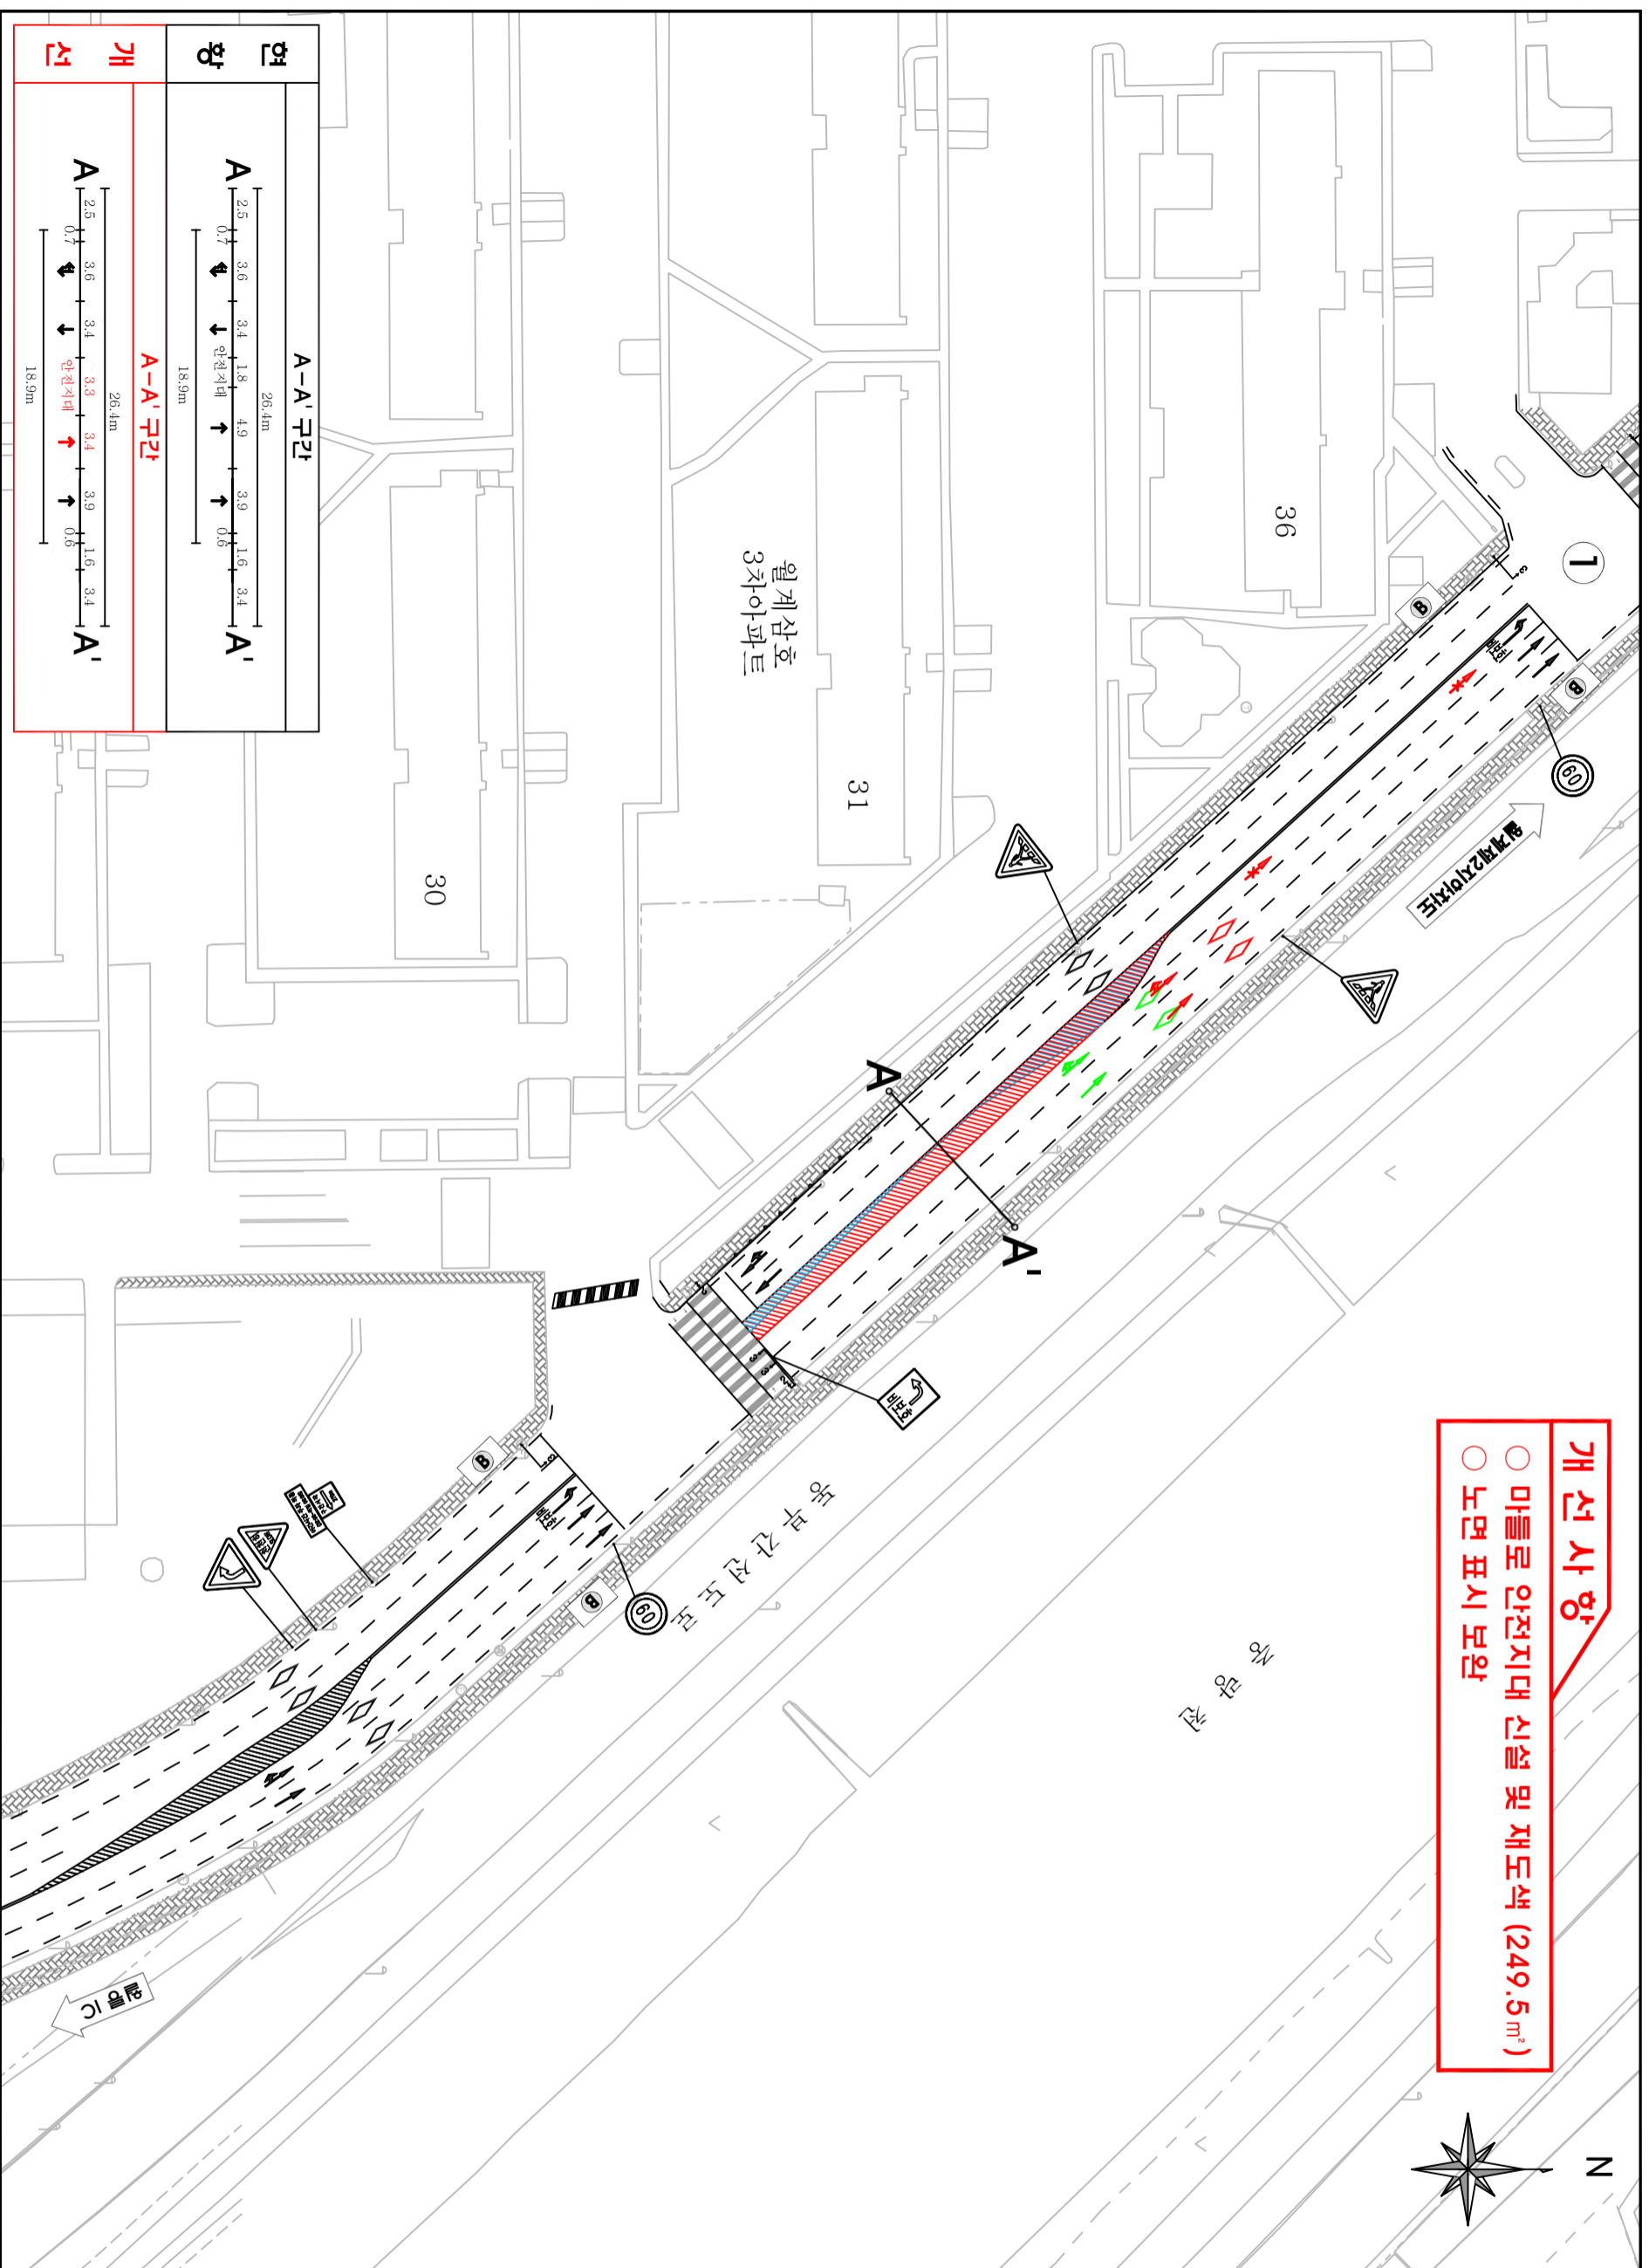


개선 사항

- 마블로 안전지대 신설 및 재도색 (249.5 m²)
- 노면 표시 보완

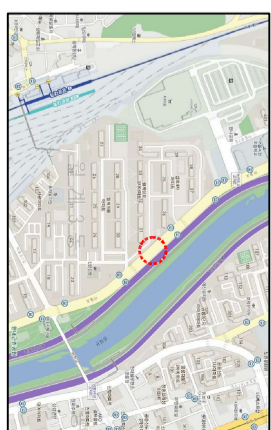

[교통량(차량)]

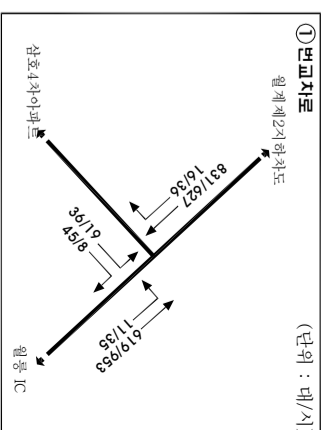

구분	φ1	φ2	-	주기
원형	97(3)	27(3)		130초
개선	99(3)	25(3)		130초

※ 오후월동차(18:00~19:00시)기준

구분	평균제거차(초/대)	서비스수준
원형	6.7	A
개선	6.0	A
증감	-0.7	-

범례

색상	의미
Black line	현황
Red line	신설
Blue line	제거
Green line	이전

