
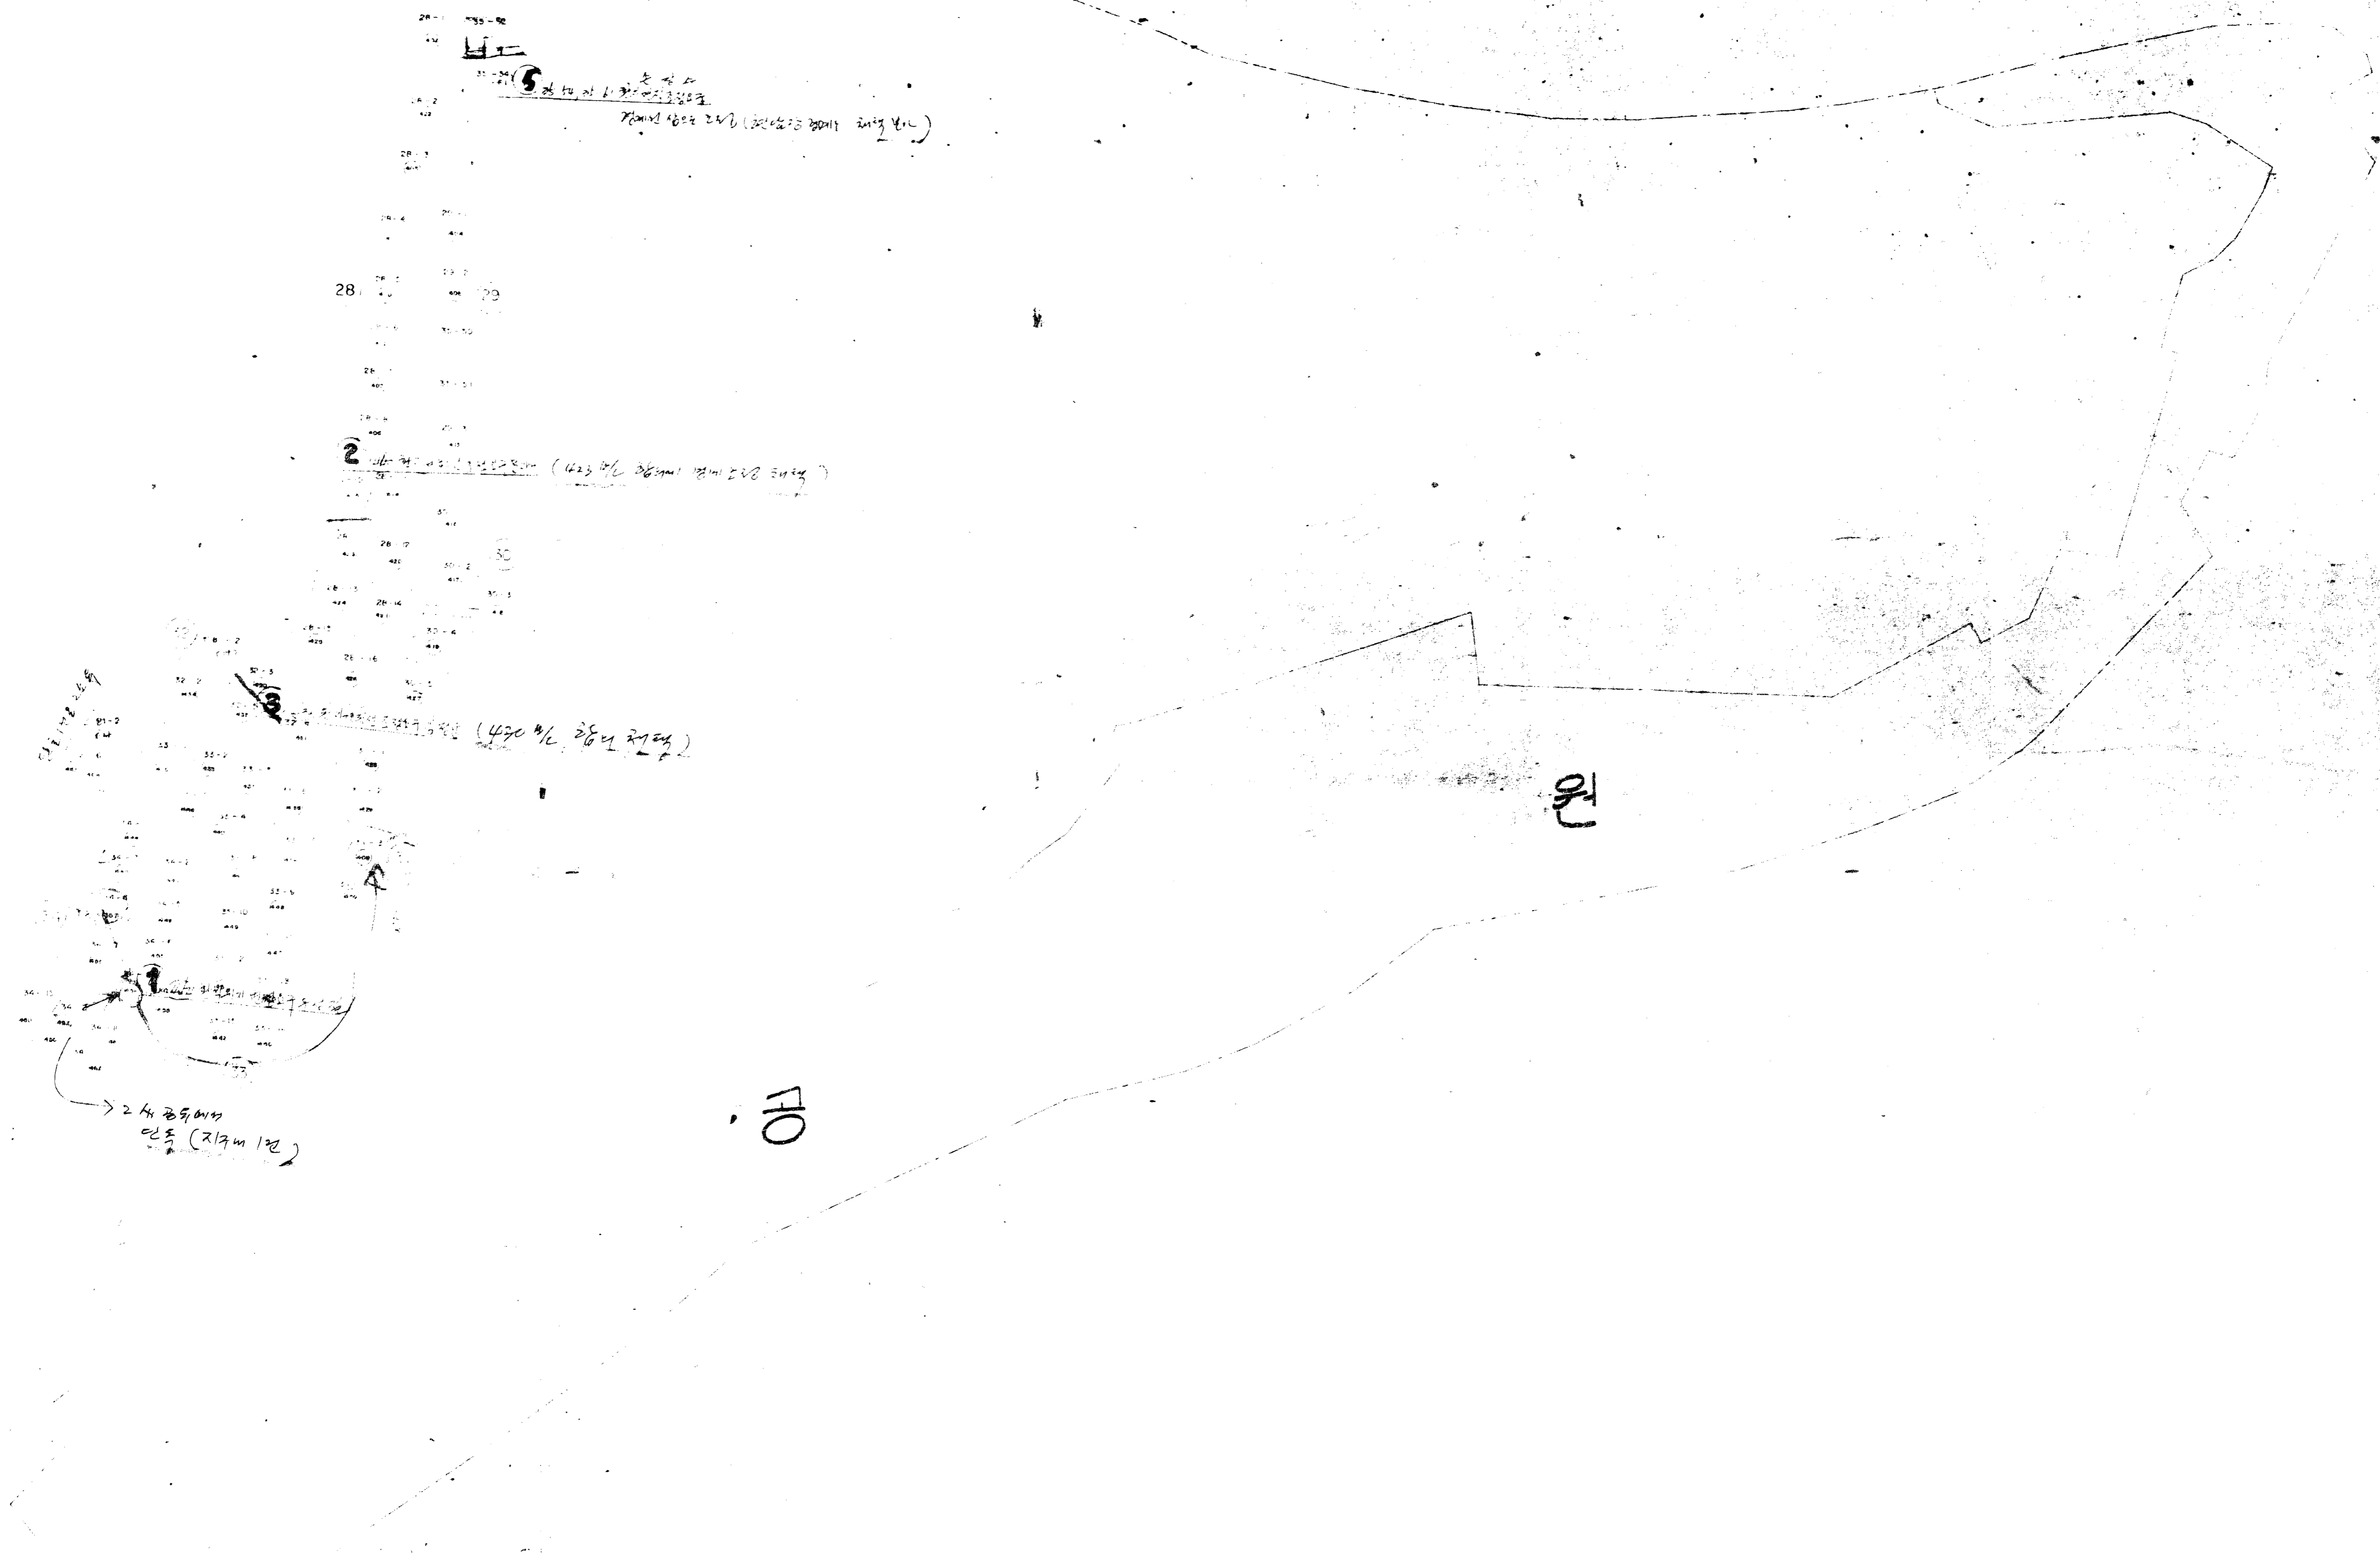



# 흑석 제2구역관리처분계획일부변경공람도

S = 1:600

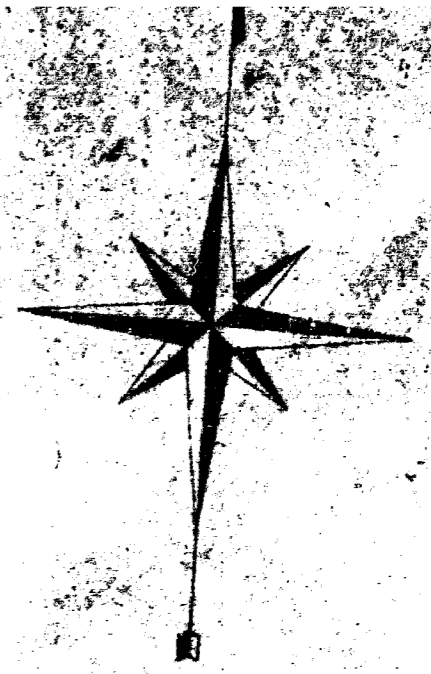

# 흑석 제2구역관리처분계획인가도

S=1:600

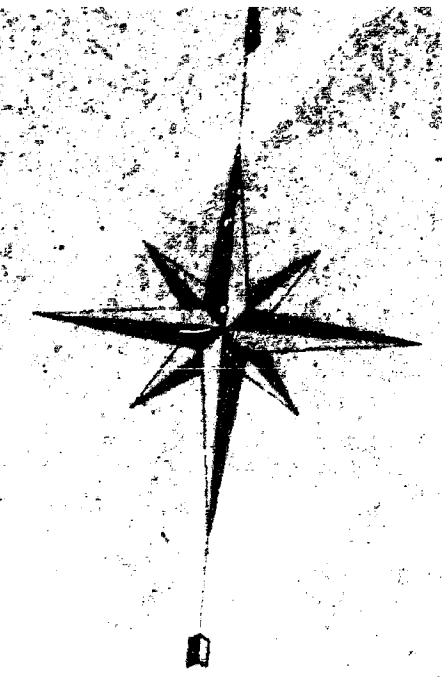

28-1	35-52
28-2	35-54
28-3	35-56
28-4	29-1
28-5	29-2
28-6	31-10
28-7	31-12
28-8	30-2
28-9	30-3
28-10	30-4
28-11	30-5
28-12	30-6
28-13	30-7
28-14	30-8
28-15	30-9
28-16	30-10

F10

F11