
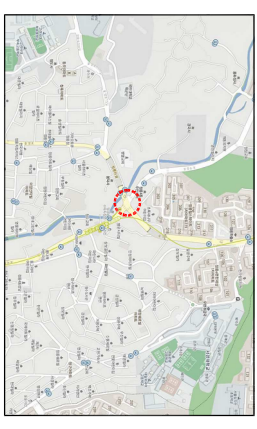
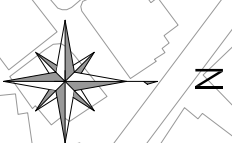


☐ 슬램사거리(개선2차)


개선 사항

- 보호좌회전 신설
- 노면표시 변경
- 표지판 삭제(2개소)
- 보도기각부 정리(L=12.0m, B=1.4m)

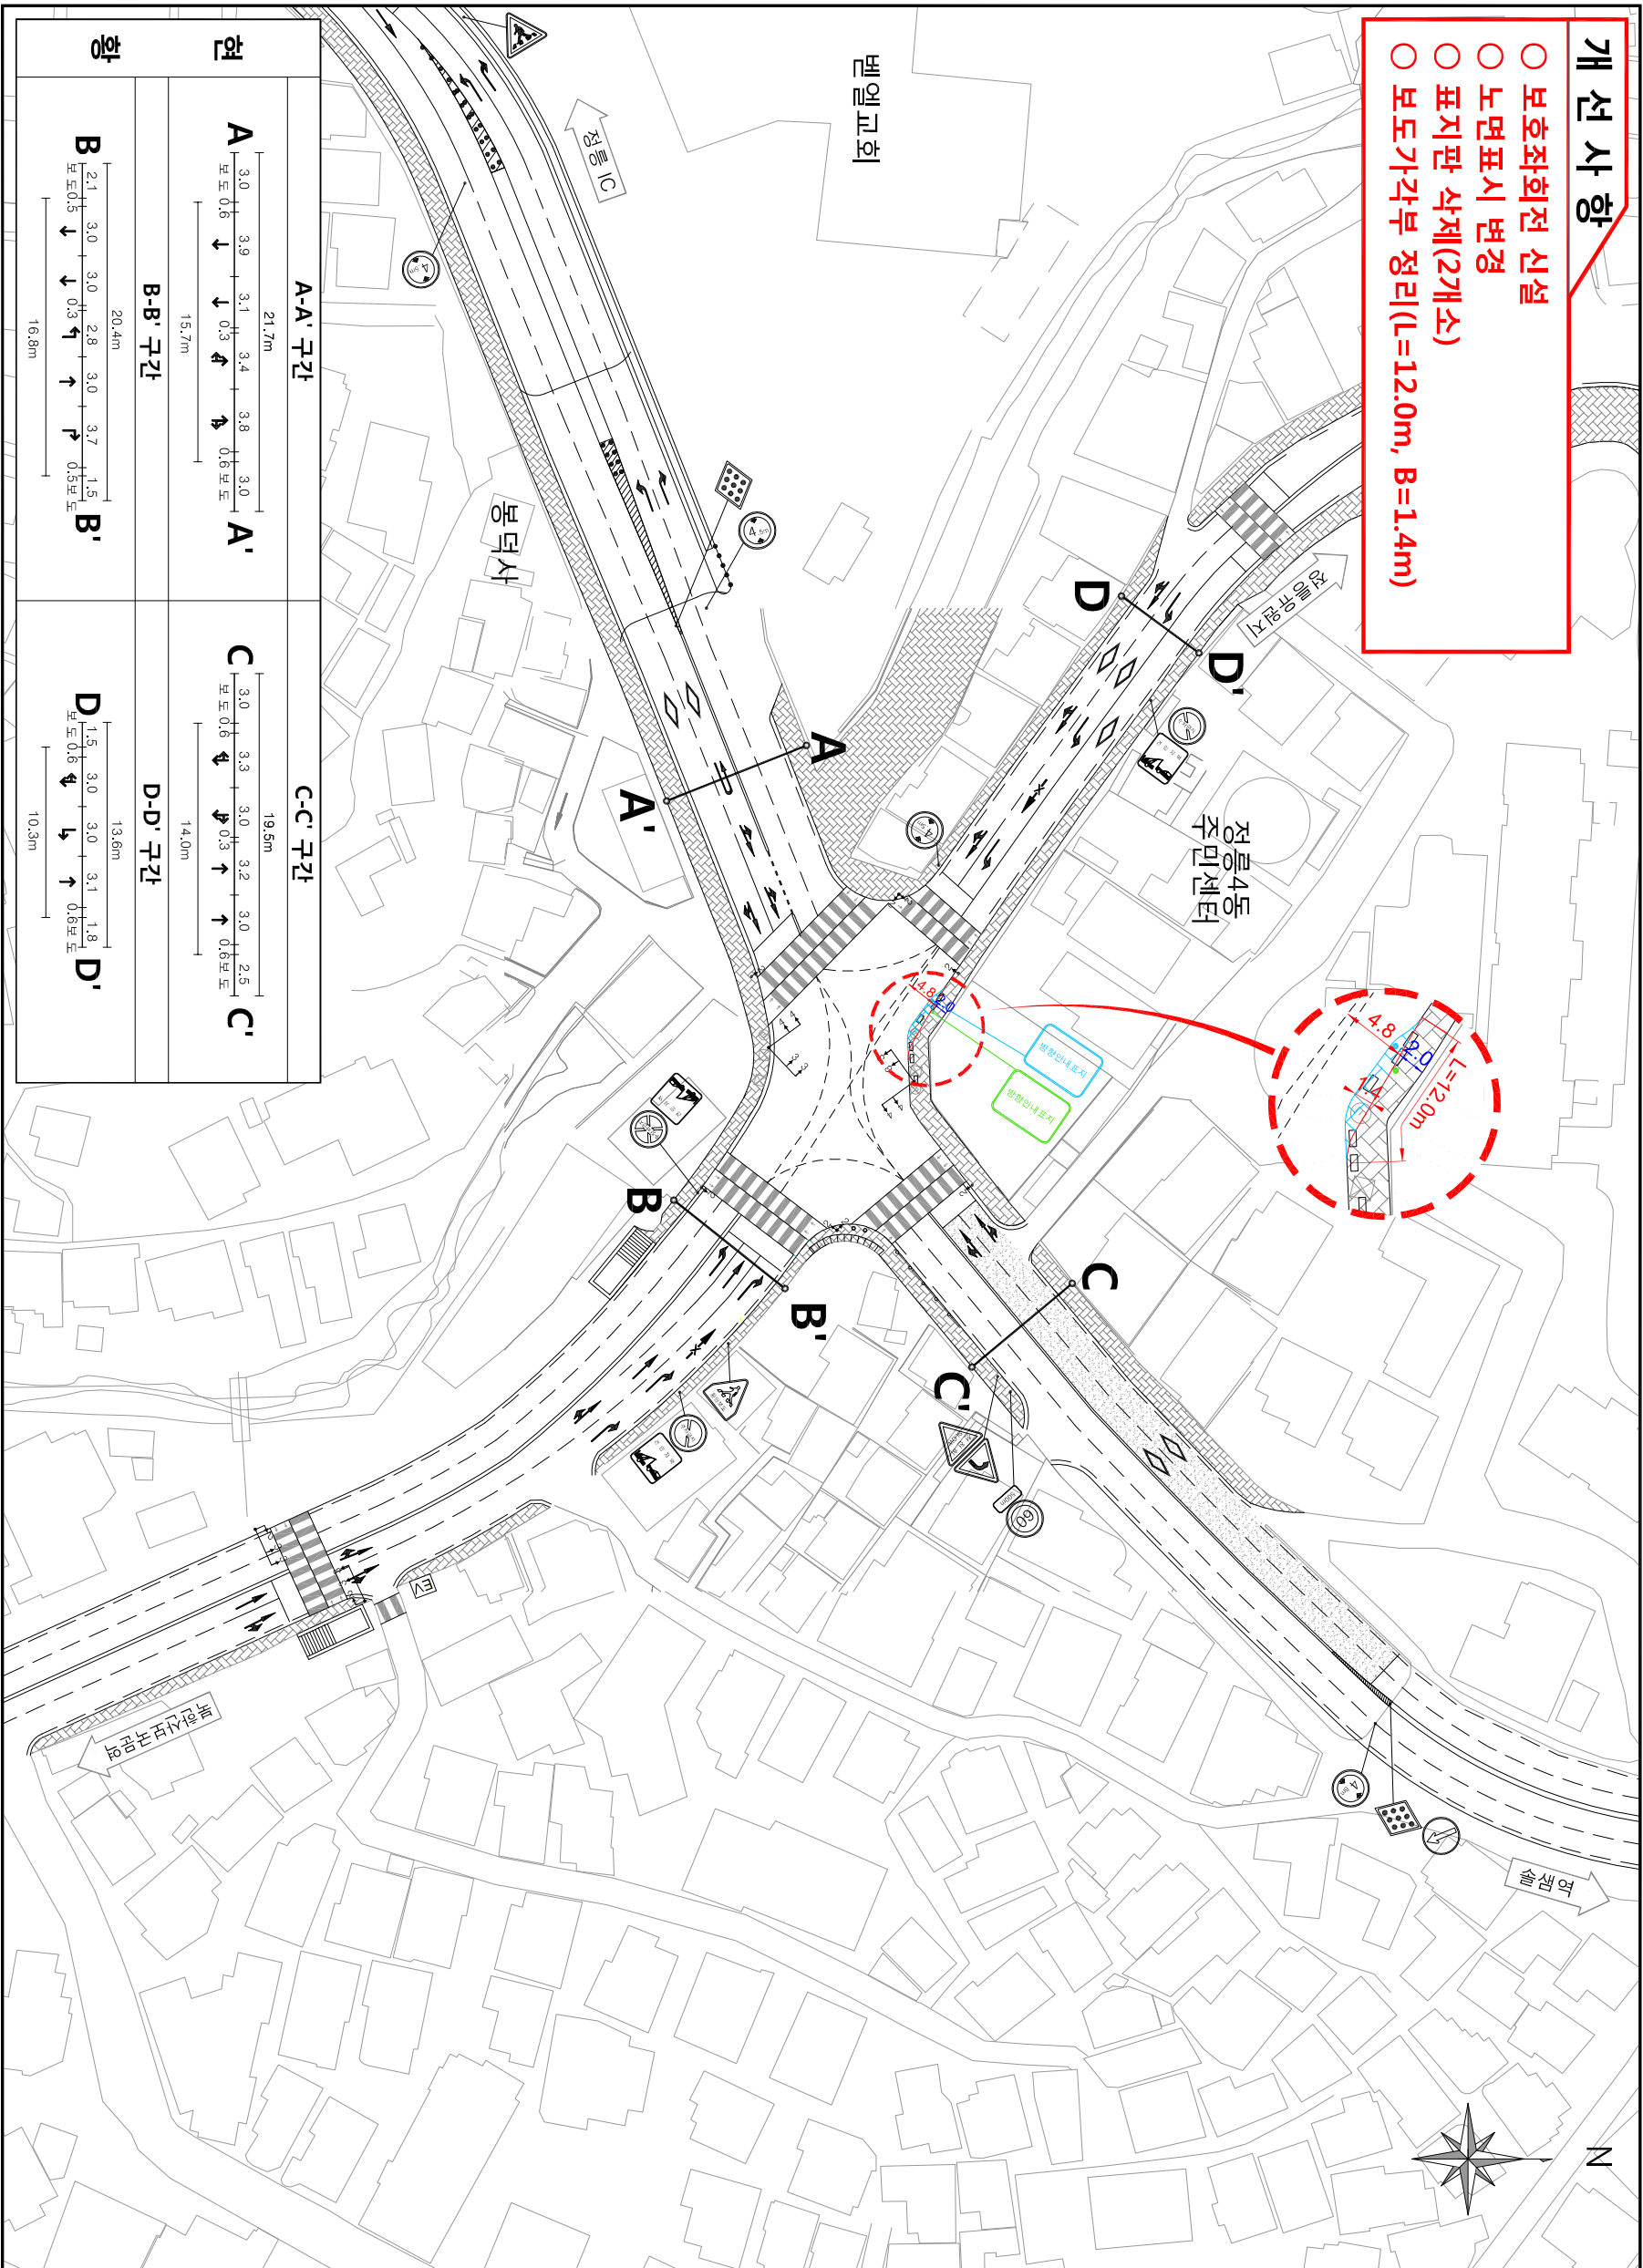

[교통량(차량)]


(단위 : 대/시)

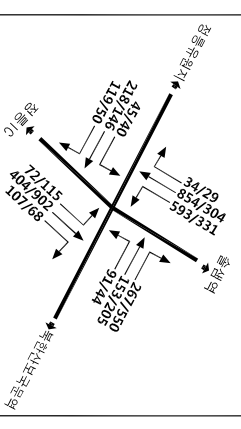

\* 조사일자 : 2018.03.09, 원두사 : 오전(07-08시), 오후(17-18시)

[교통량(보행)]

(단위 : 명/시)

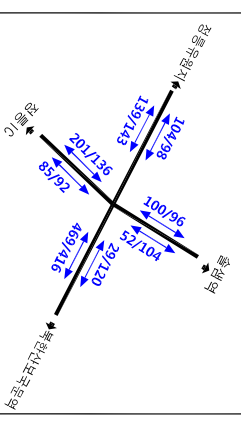

\* 조사일자 : 2018.03.09, 원두사 : 오전(07-08시), 오후(17-18시)

구분	Φ1	Φ2	Φ3	Φ4	주기
현황	↔↔↔↔	↔↔↔↔	↔↔↔↔	↔↔↔↔	140초
※ 오면원두사(07-08시)기준	31(3)	12(3)	25(3)	60(3)	

구분	평균체여지체(초/대)	서비스수준
현황	53.2	D

