

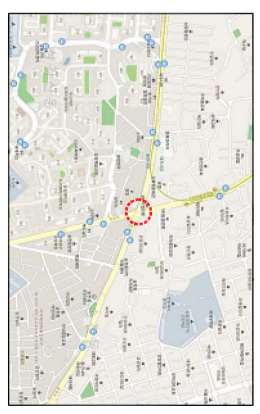


▣ 삼양동사거리(개선)

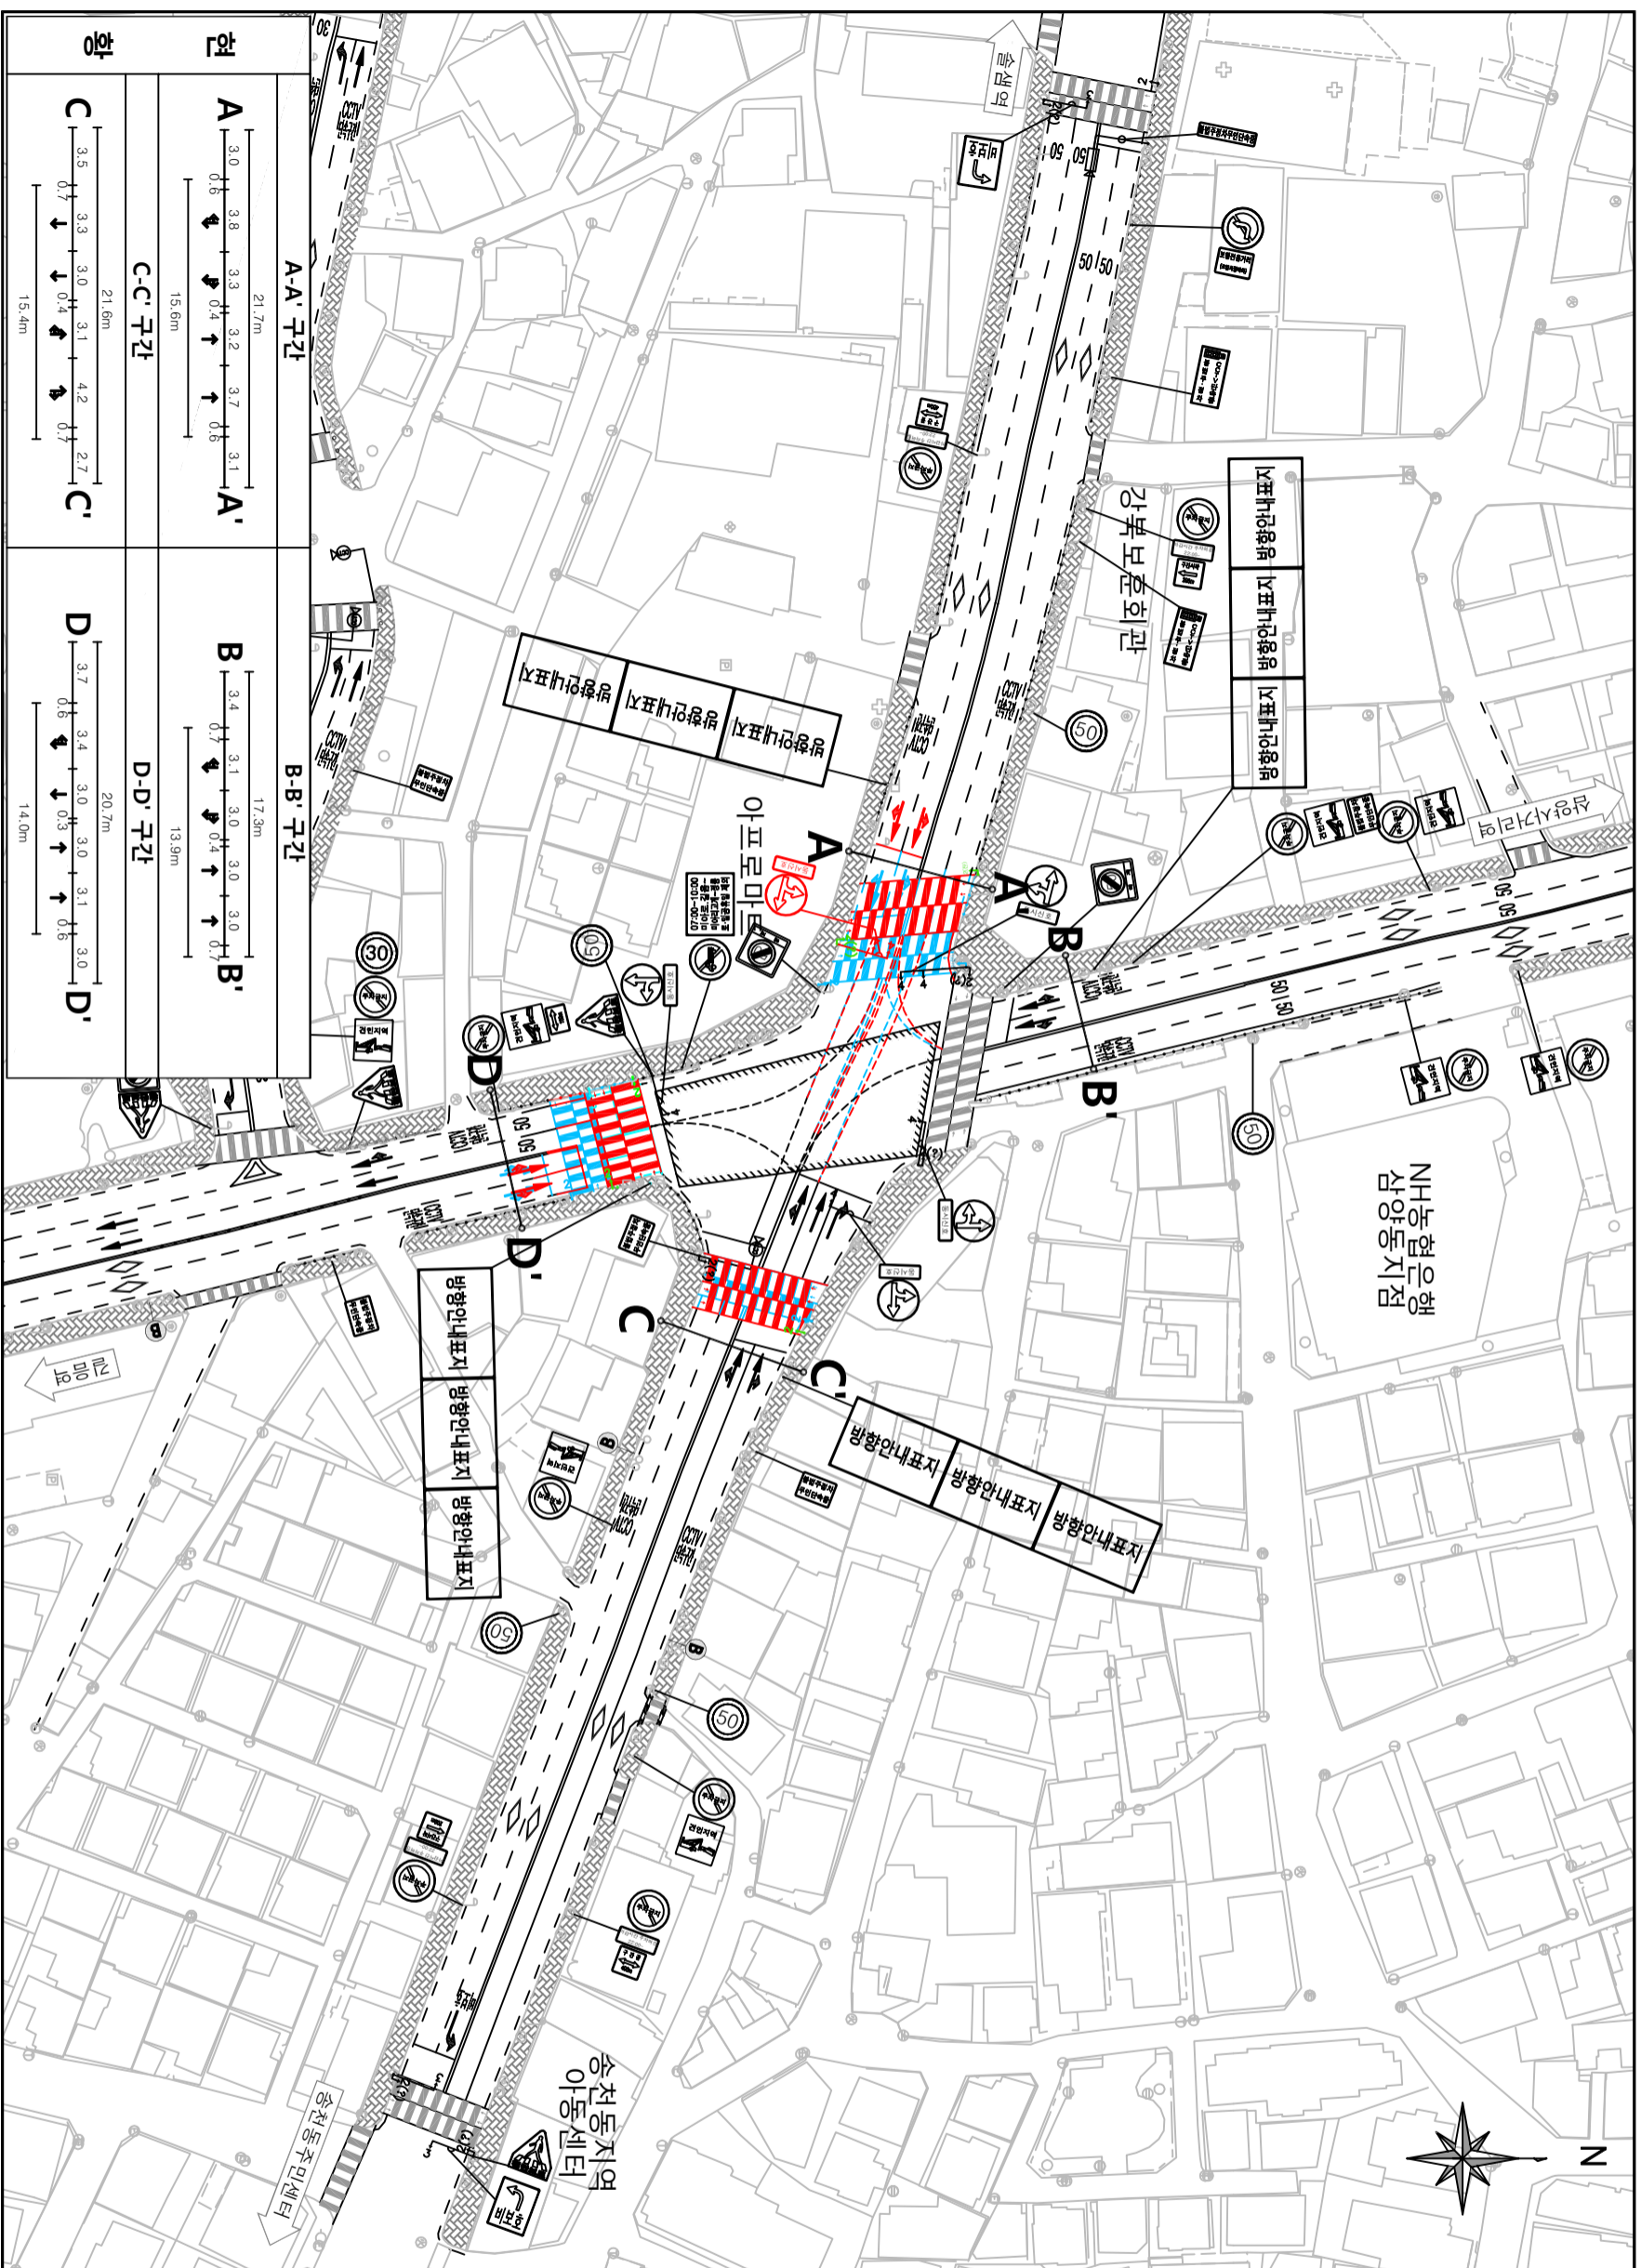

[교통량(차량)]
삼양사거리역 (단위 : 대/시)

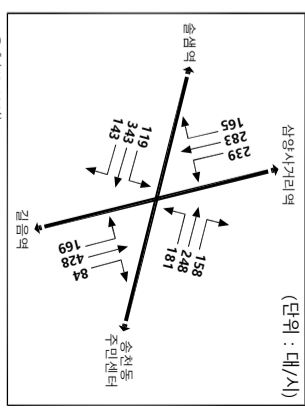

구분	평균제어체(호/대)	서비스수준
현황	58.1	D
개선	57.6	D
증감	▲ 0.5	-

구분	평균제어체(호/대)	서비스수준
현황	58.1	D
개선	57.6	D
증감	▲ 0.5	-

범	례	현	황
—	—	—	—
—	—	—	—
—	—	—	—
—	—	—	—

