

# 살곶이길 (1)



# 살곶이길 (2)

케이블교체  
(16-1~16-9)



살곶이길 (3)

케이블교체  
(3-2~3-14)  
(15-1~15-6)





살곶이길 (5)

케이블교체  
(5-15~5-18)  
(13-1~13-3)



13-14

13-13

13-12

5-20

13-11

5-1(6m)

13-10

5-2(5m)

5-3(5m)

13-9

5-4(5m)

13-8

5-5(5m)

5-6(6m)

13-7

5-7(9m)

5-8

13-6

5-9

13-5

5-10

5-11

13-4

5-12

13-3

5-13

13-2

5-14

5-15

5-16

5-17

5-18

5-19

분전함 13번

13-1

하이츠아파트

홍익교회

남양연립

서울사근초등학교

정일빌라

성민교회

영아트빌라

영

영

창계천

2  
1

104

사근

살곶이길 (6)




케이블교체  
(6-2~6-10)  
(7-1~7-10)  
(12-5~12-20)

보도등 미설치  
(12-1~12-6)  
(12-11~12-20)

살곶이길 (7)

케이블교체  
(8-8~8-11)  
(11-1~11-5)

보도등 미설치  
(8-17~8-18)  
(11-1~11-17)

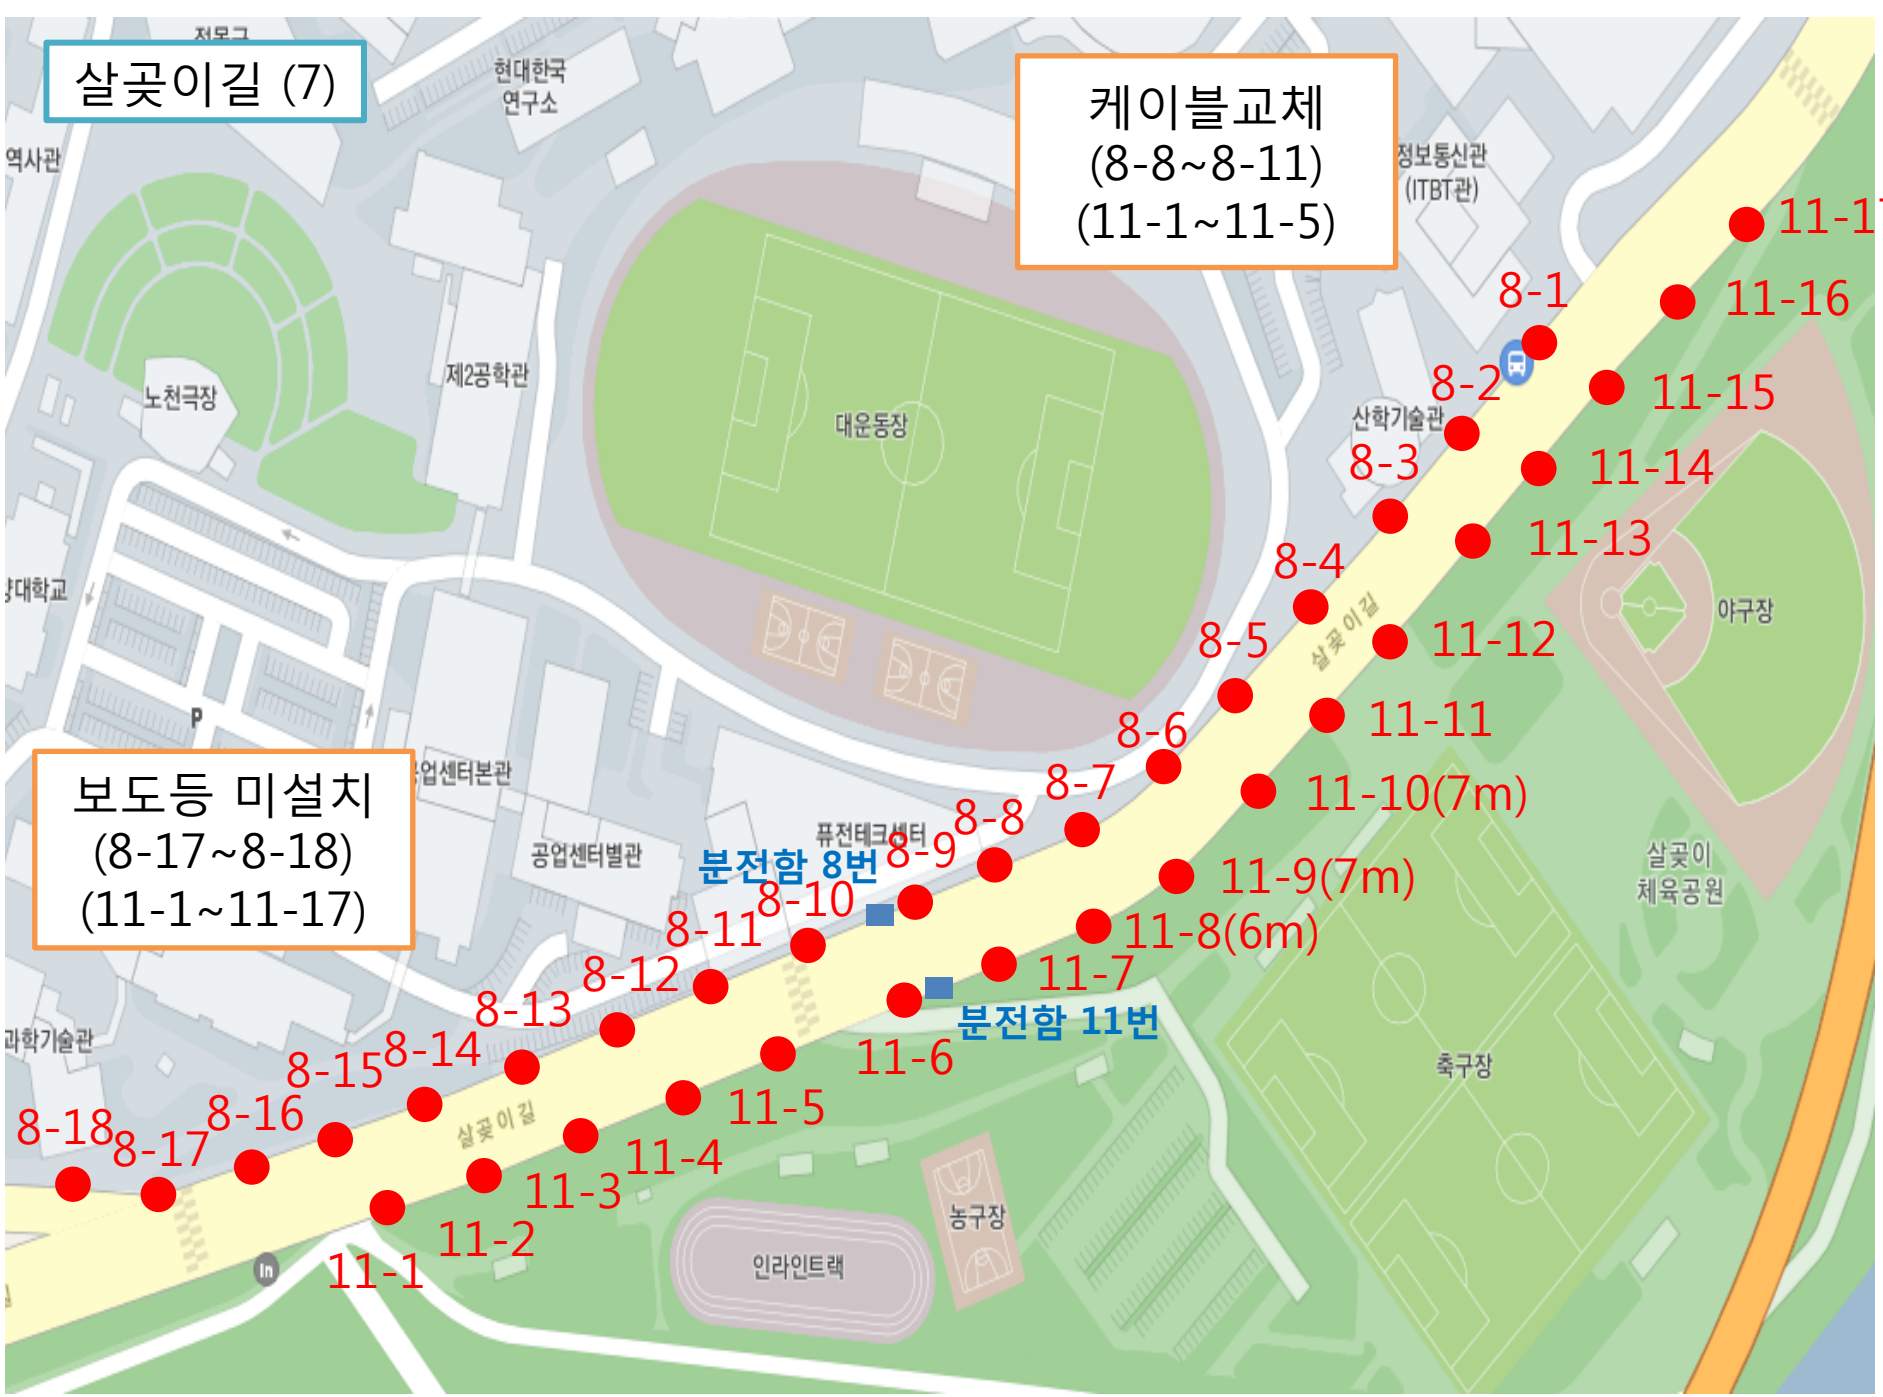

살곶이길 (8)

보도등 미설치  
(9-1)  
(10-1~10-4)  
(10-6~10-10)

