



노선도

변경 전

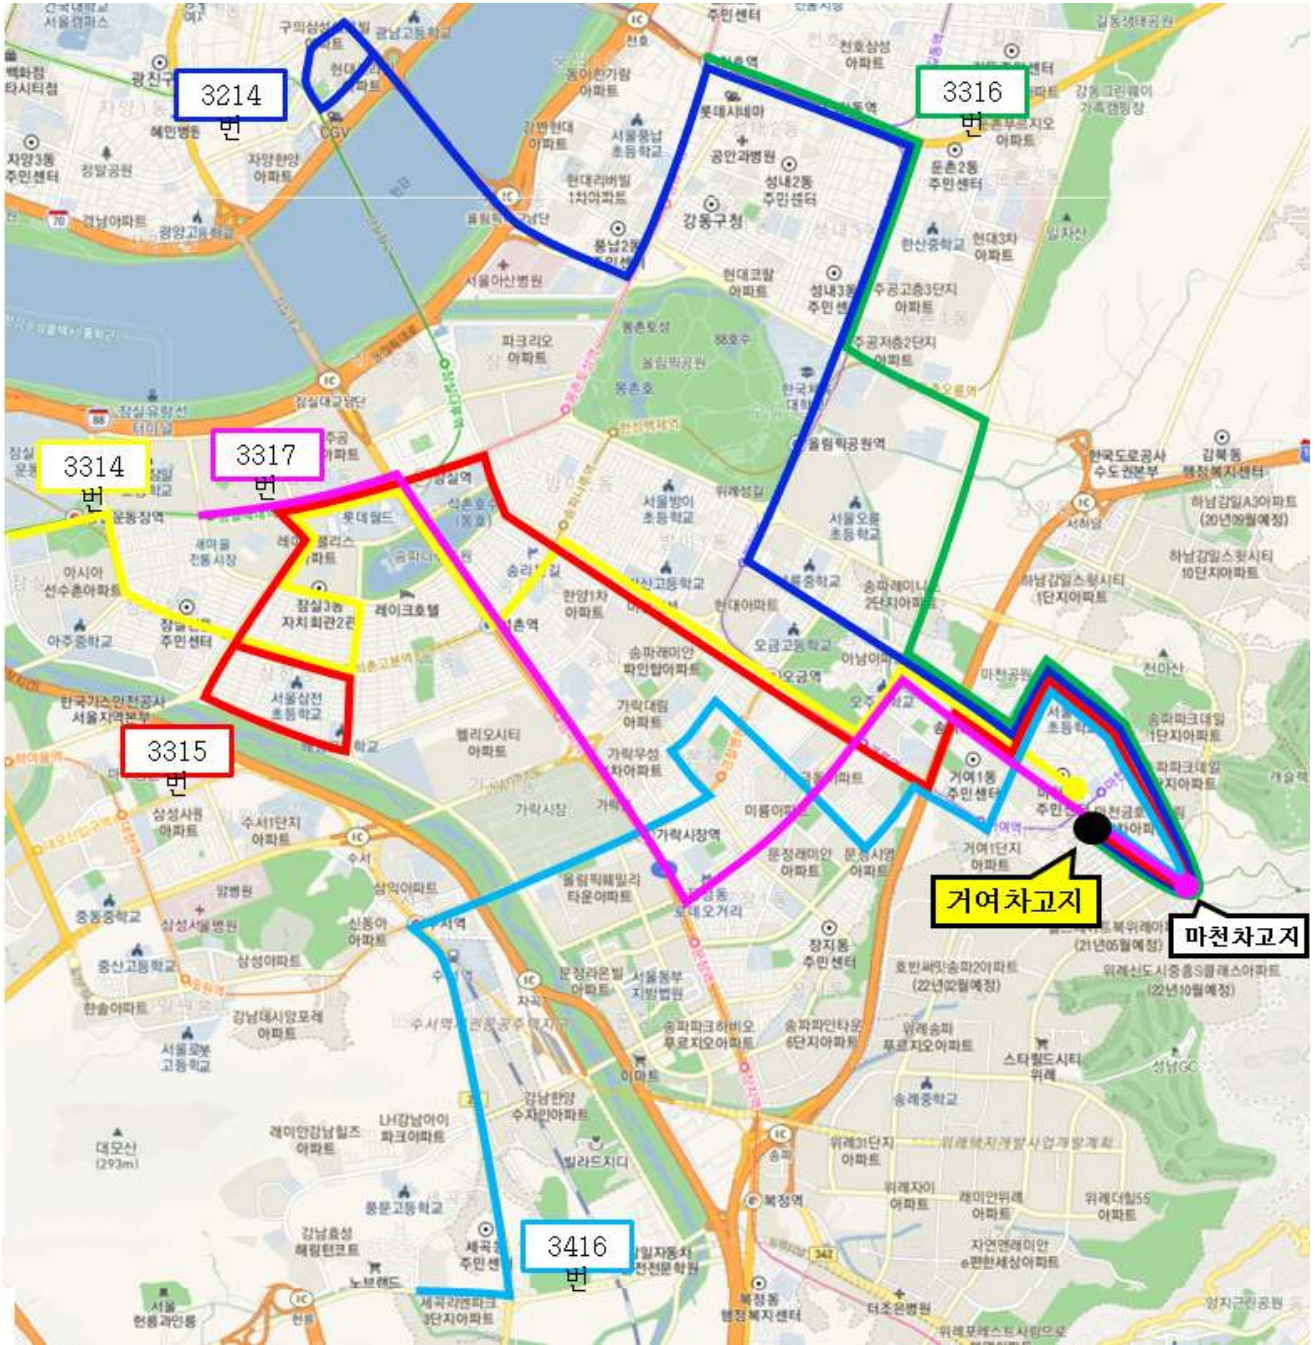

변경 후

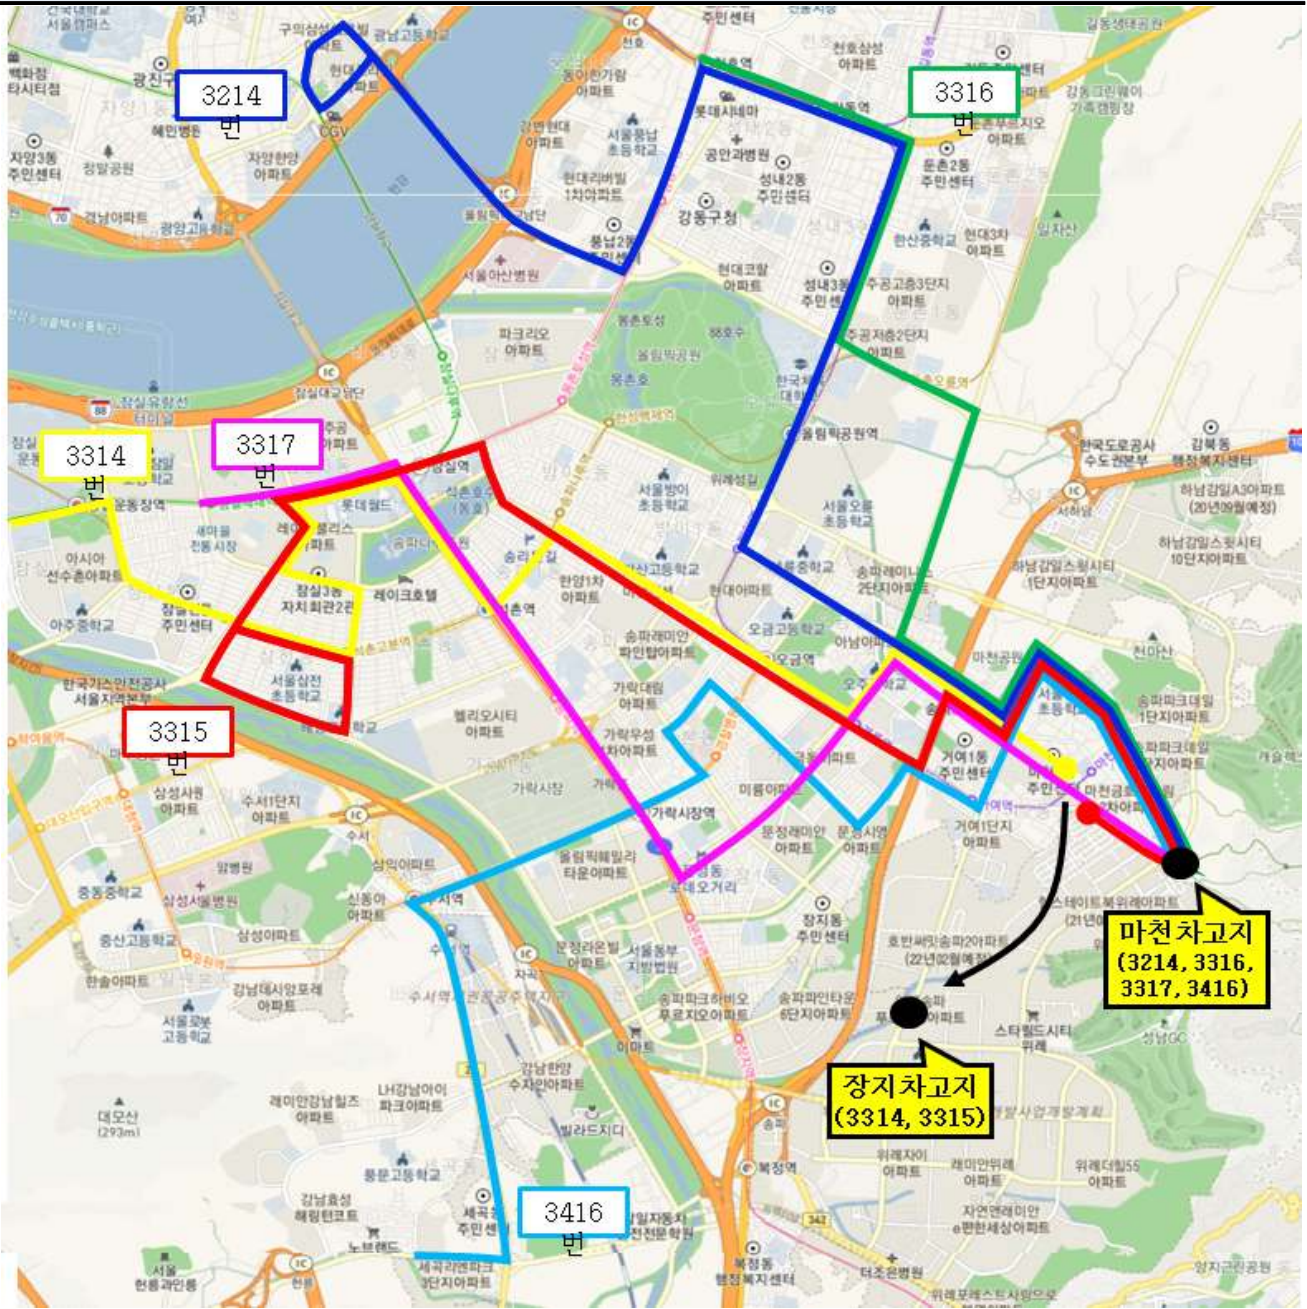

단축구간(3214, 3316, 3416번)

