



변경후 S=1:1,200

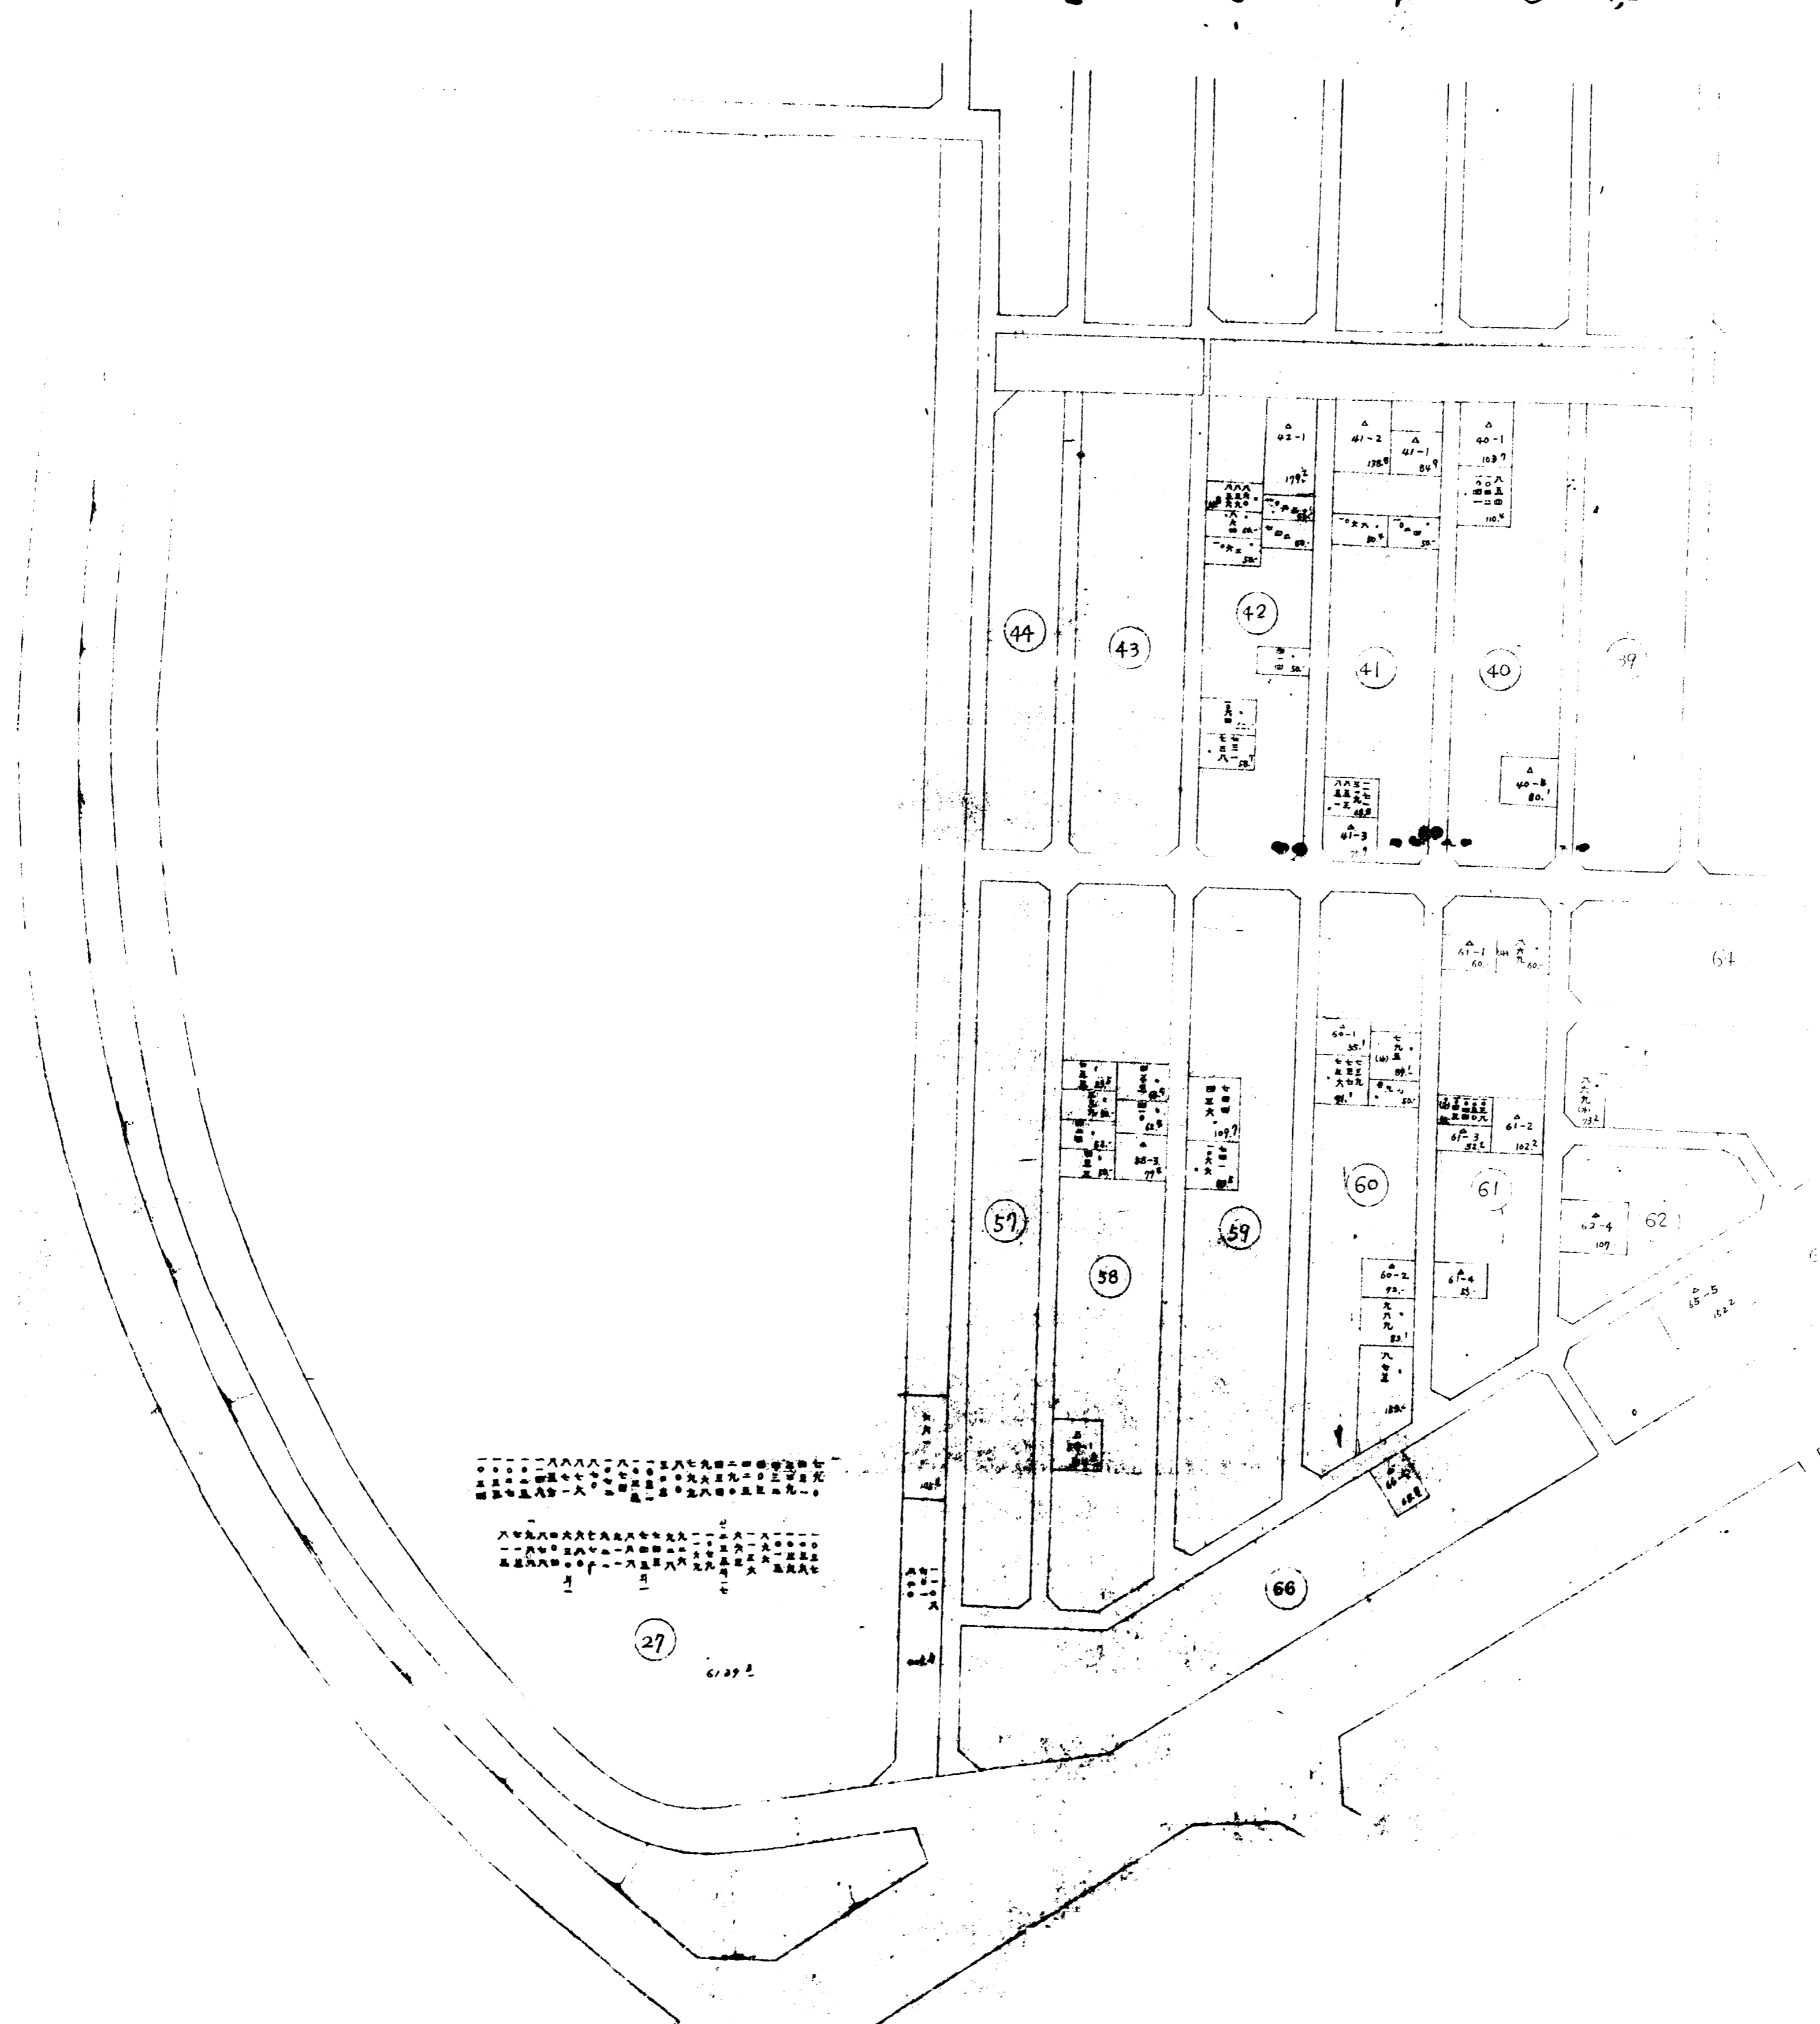

241

1:1200

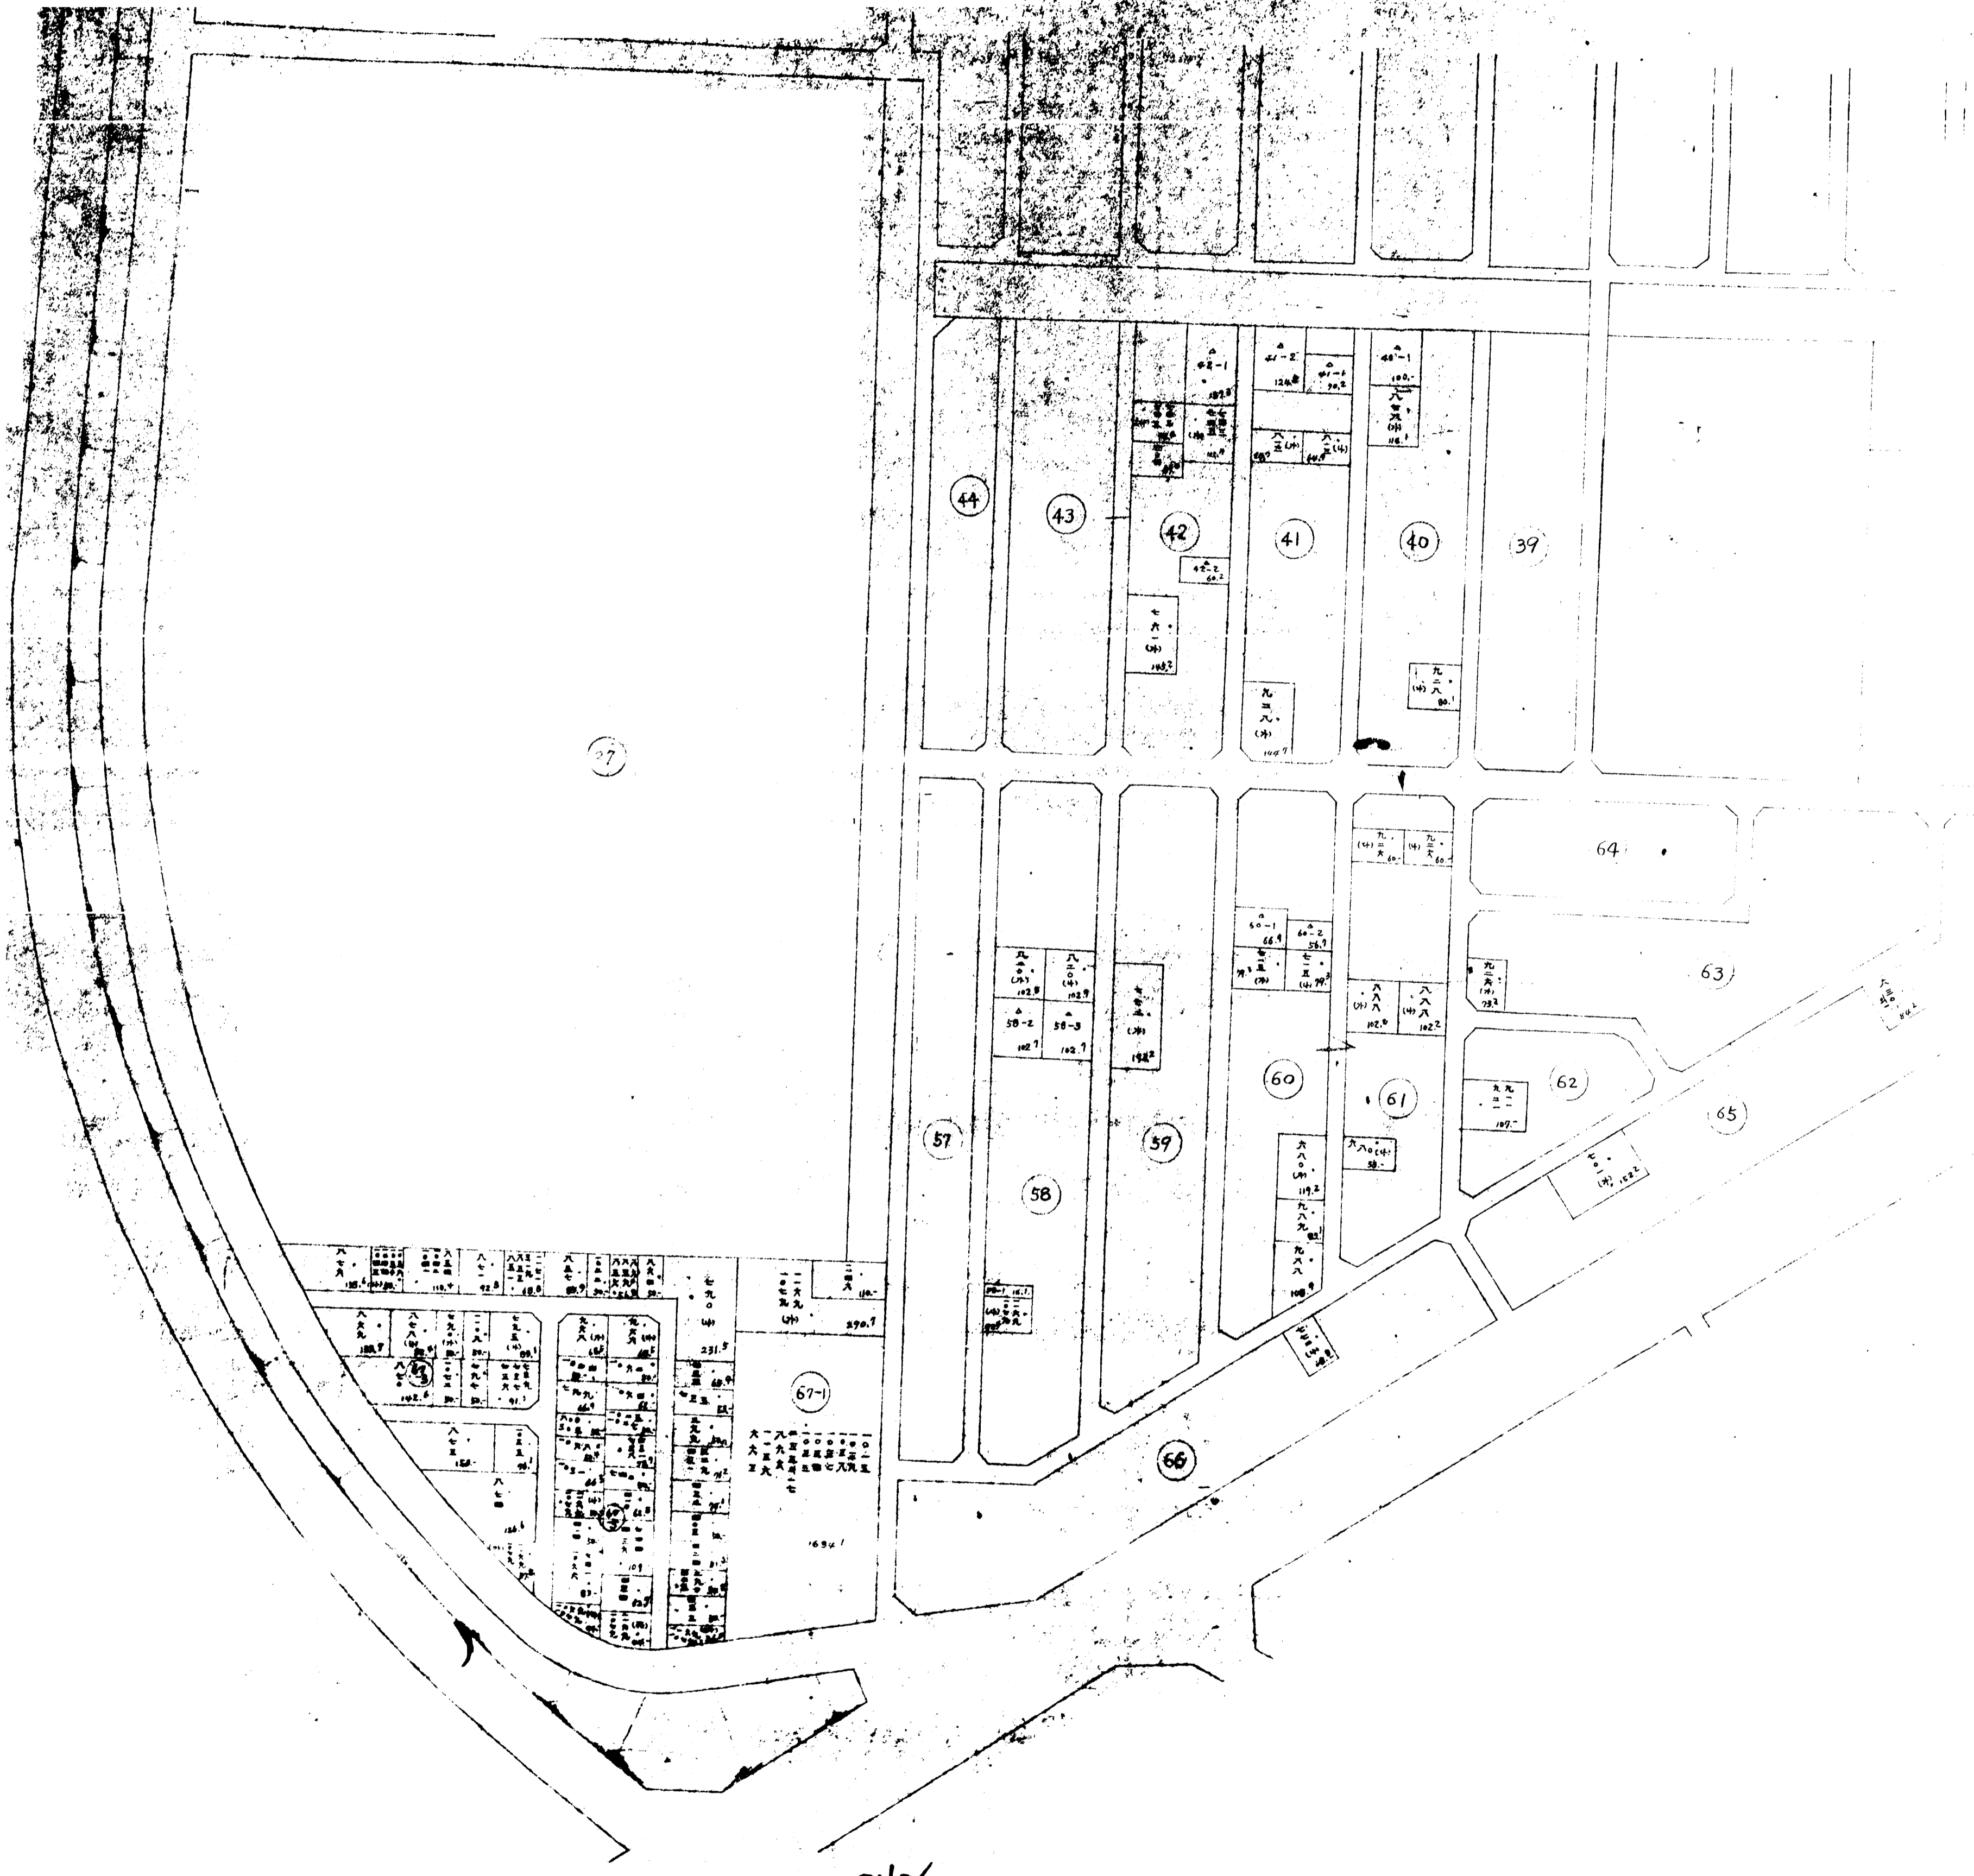

Handwritten mark or signature.

변경전

S = 1:1,200



변경후

S=1:1,200

