



첨부3

재정비(변경, 폐지) 위치 및 현황 사진

1. 도로 변경 (미아동 791-1712 ~ 791-1572) : 청암공영주차장 주변

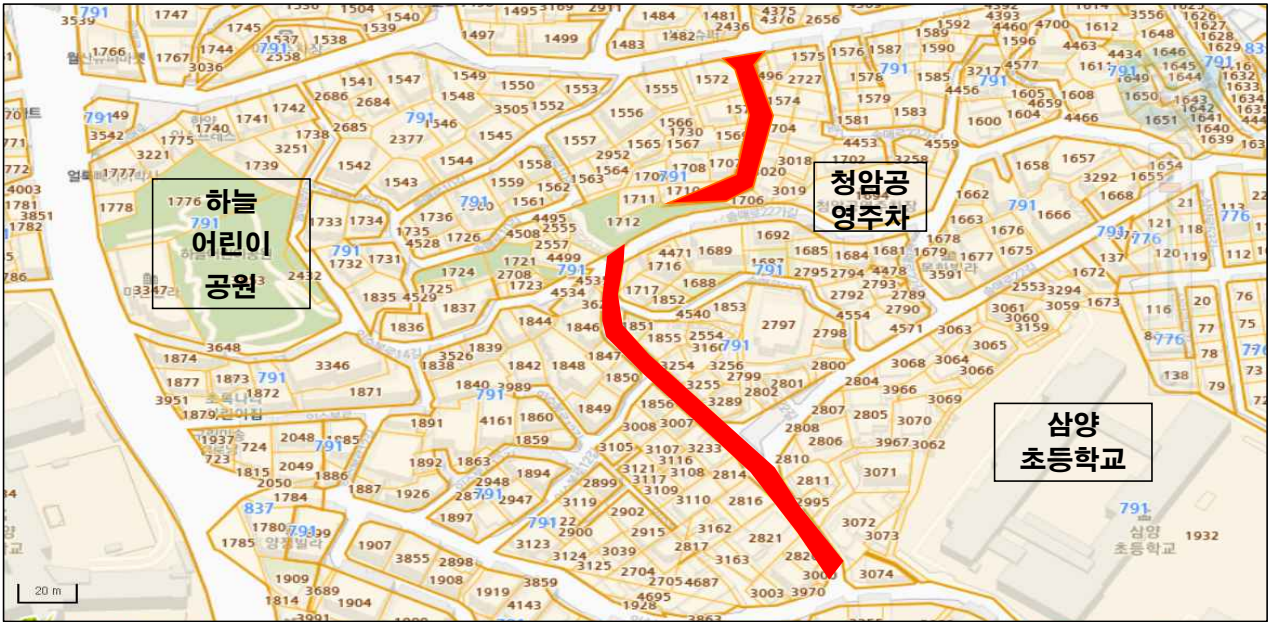

□ 현황사진

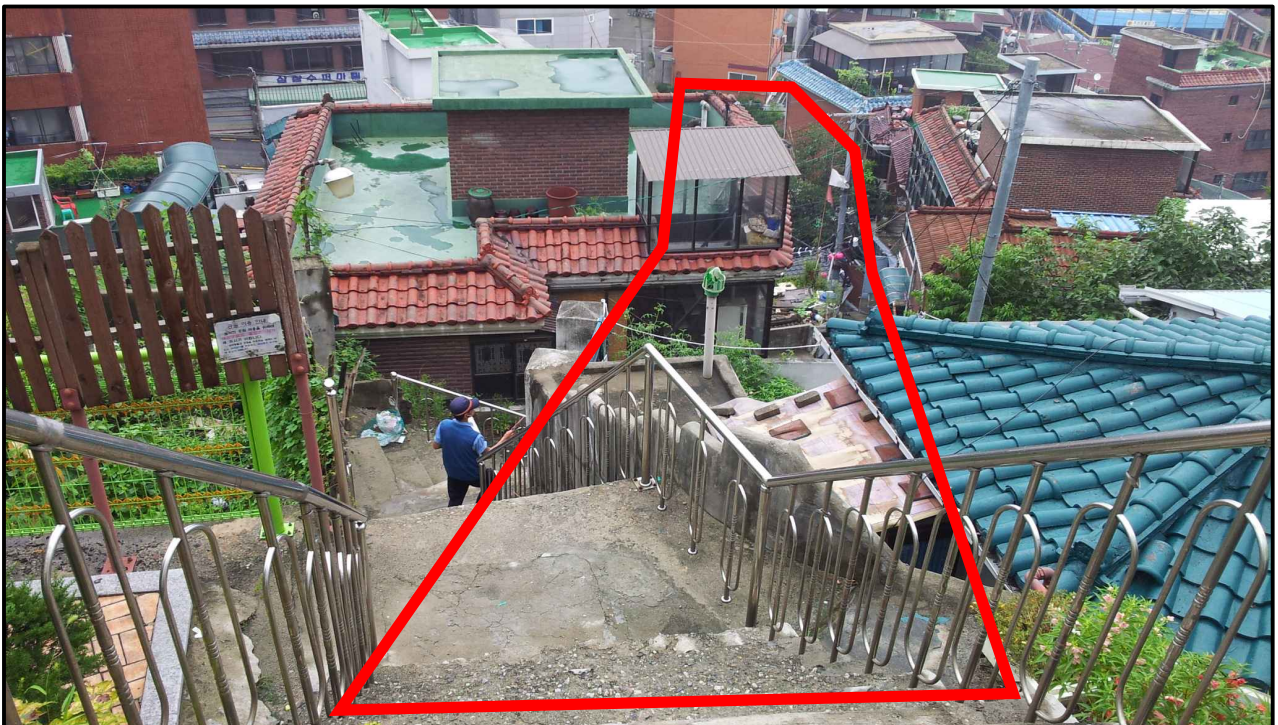

2. 도로 폐지 (미아동 791-2092 ~ 791-2103) : 주일빌라 주변



□ 현황사진



3. 공원 폐지 (미아동 128 - 8) : 화계초등학교 주변



현황사진

