

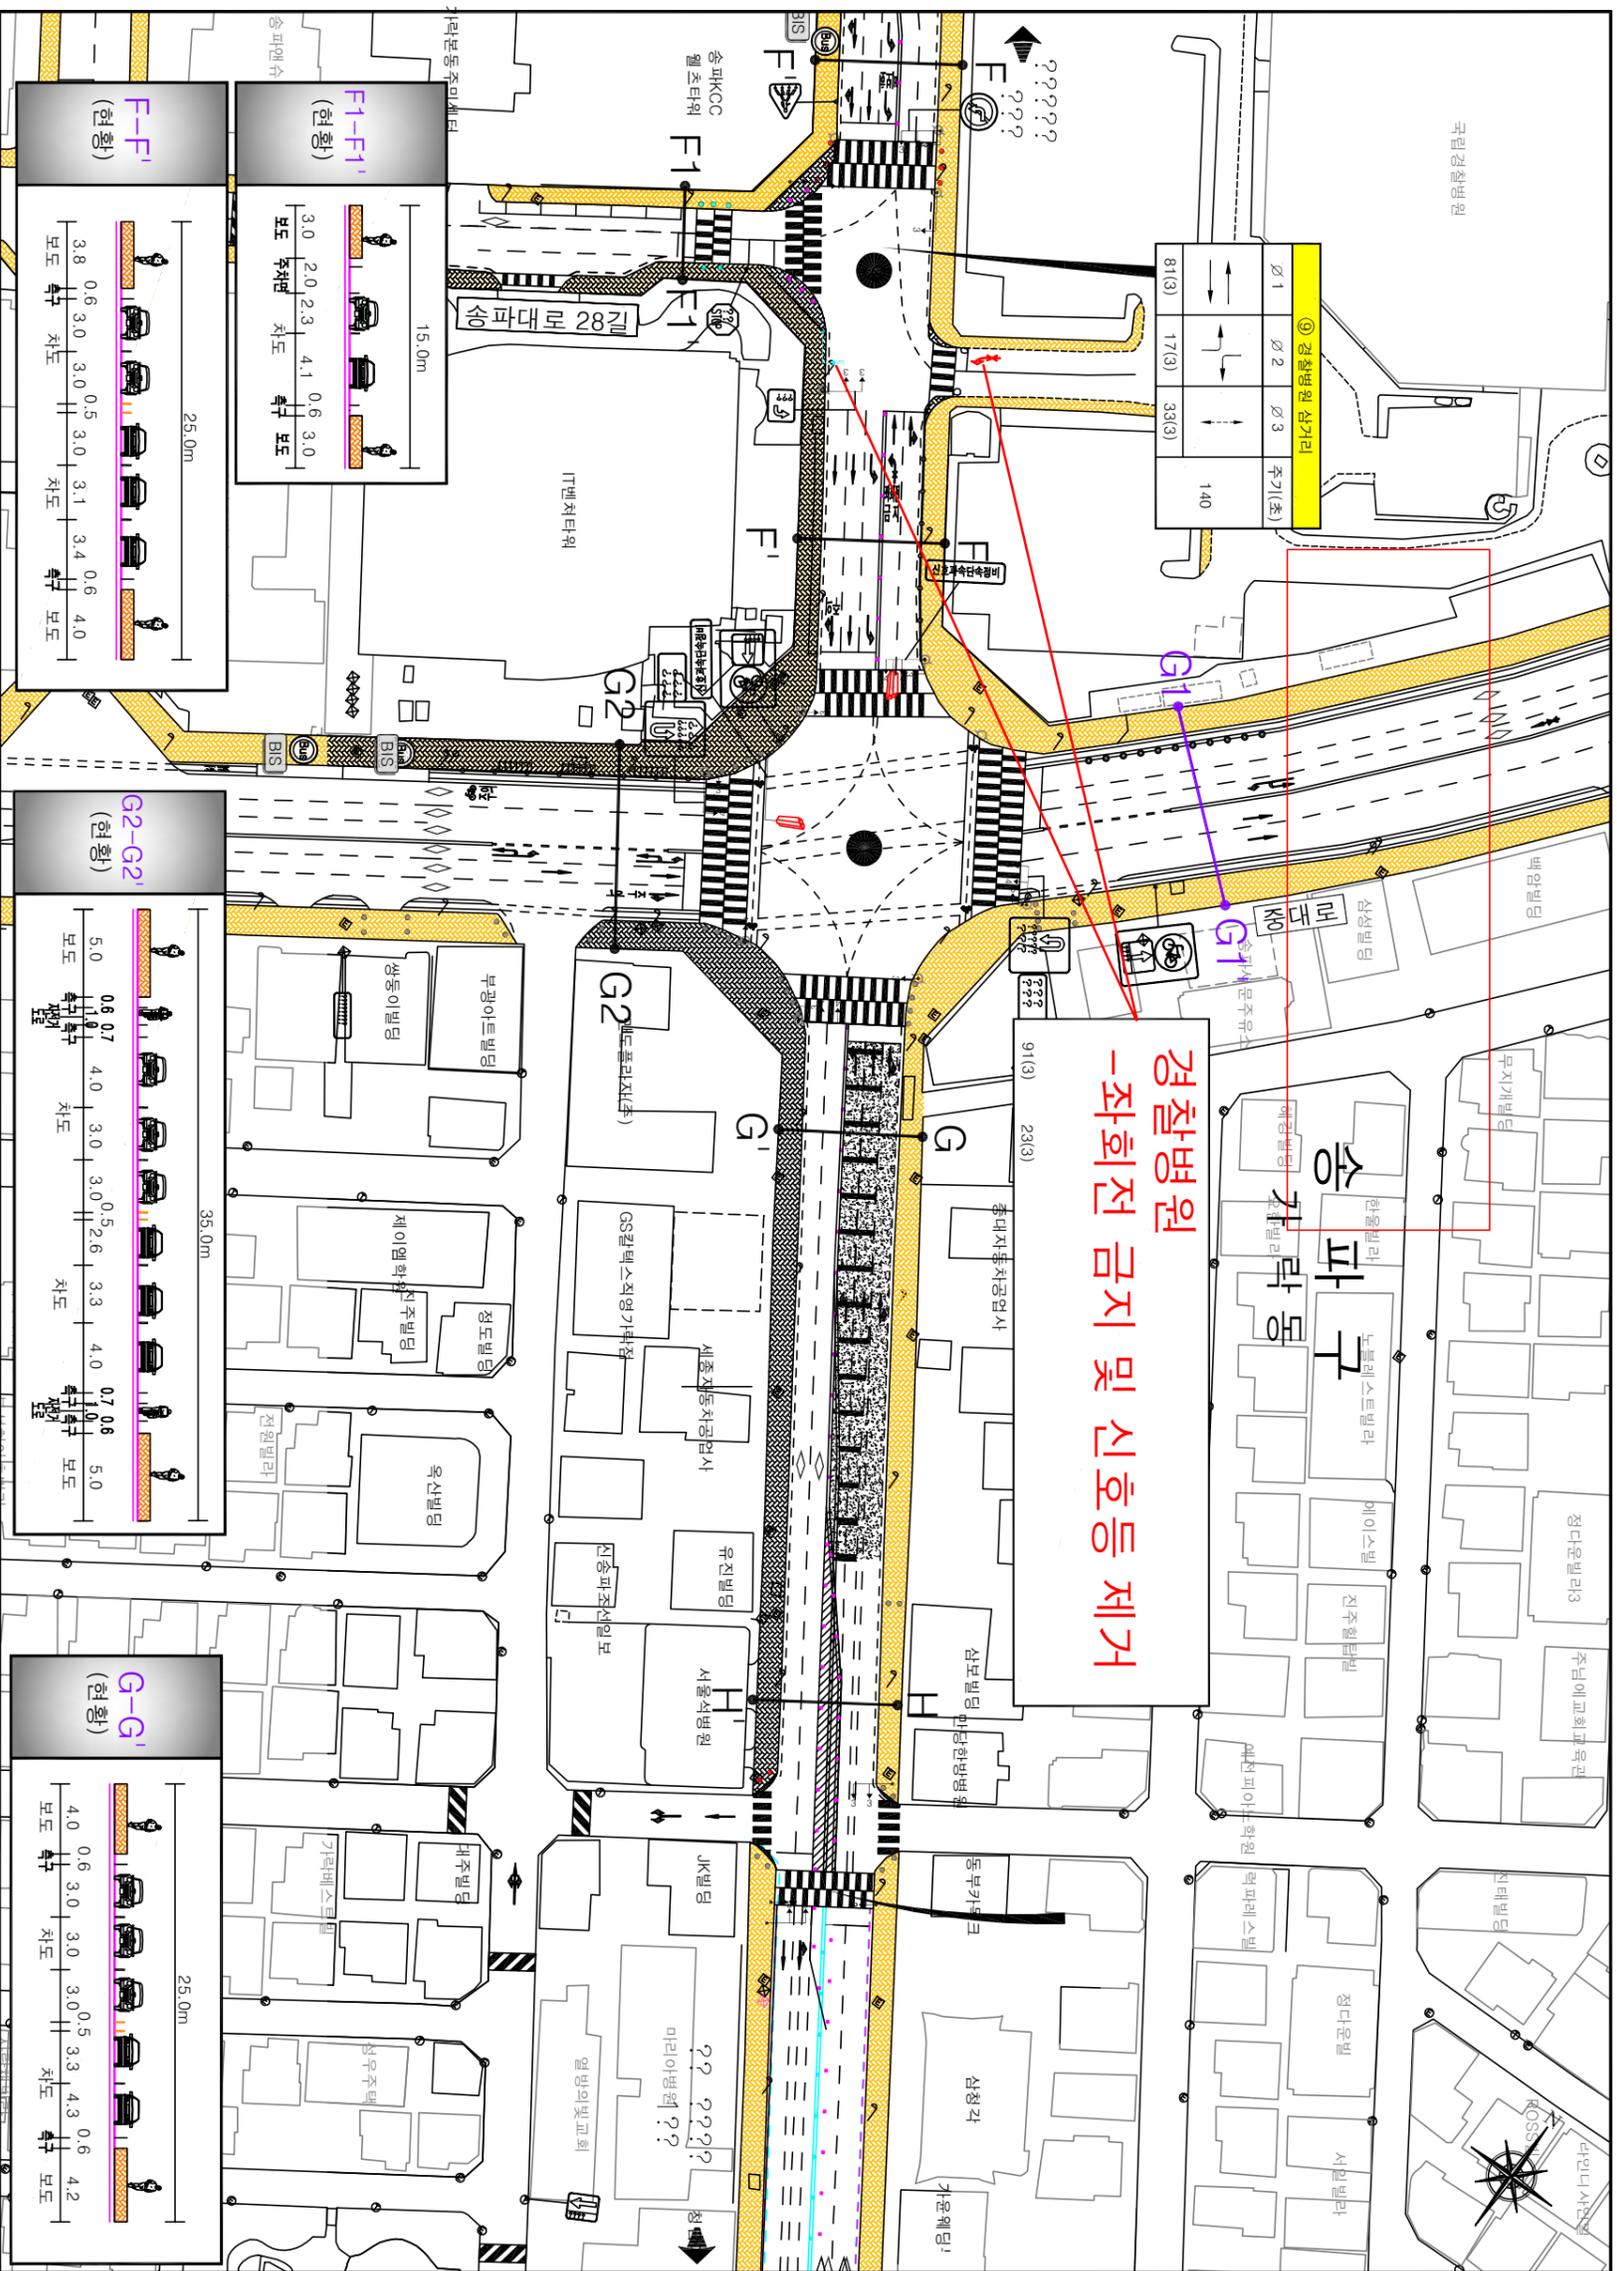


5구간(9) 경찰병원삼거리 ~ 서울석병원 앞) - 변경('19.11.18)

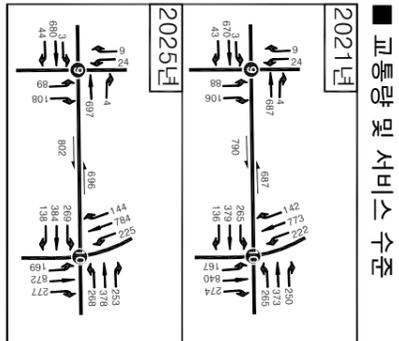

경찰병원
-좌회전 금지 및 신호등 제거

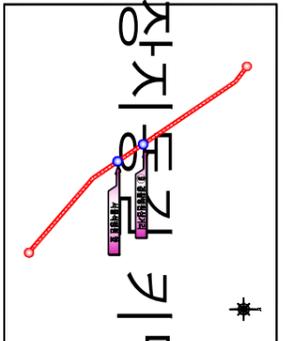

| 범례 | 설명 |
|----|---------|
| | 표지판 |
| | 신호등 |
| | 카드웬스 |
| | 과속방지턱 |
| | 노면표시 |
| | 블라드 |
| | 규제봉 |
| | 버스정류장 |
| | 자전거보관소 |
| | 반사경 |
| | 횡단보도 |
| | 점프식횡단보도 |
| | 표지범 |
| | 카메라 |
| | 연석 |
| | 버스정모안대기 |
| | 신호제어기 |

서울시: ? ? ? ? ?

에이스톤엔지니어링(주)
ASTONE ENGINEERING CO., LTD.



