

수량 총괄 표 (변경)


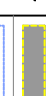
공동 271번지 일대

☑ 철거 수량표
























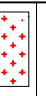


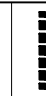
구분	기호	품명	규격	단위	수량	비고
시설물		블럭철거	H600	식	1	
		무근콘크리트A철거	T200	식	1	
		무근콘크리트B철거	T200	식	1	
		콘크리트철탄	T200	M	20.9	

공동 산1-63번지 일대


☑ 철거 수량표

구분	기호	품명	규격	단위	수량	비고
시설물		THP 주름관 철거	Ø600	M	20.7	
		홀관 철거	Ø600	M	5.0	

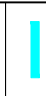





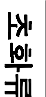





☑ 시설물 계획수량표(변경)

구분	기호	품명	규격	단위	수량	비고
시설물		석축(2면)	H1,300xW1,200	M	62	
		석축(1면)	H1,300xW1,200		136	
		석축(1면)	H1,900xW1,200	M	32	
		응벽	H=1,900	M	18	
		응벽	H=2,100	M	32	
		응벽	H=1,300	M	18	
		석축널개벽	H1,300	식	0	
		집수정 인화	1,800x1,500	개소	1	
		침사지	2,000x2,000	개소	0	
		침사지	2,000x2,000	개소	1	
		침사지	2,000x2,000	개소	1	
		도로경계석	200x250x1,000	M	1	
		콘크리트 포장	T150	M2	0.0	
		스크린	H950	개소	36.6	
		스크린	H950	개소	16.6	
		골막이	H200	개소	1	
		골막이	H200	개소	2	석축포함
		건널목	2.0*2.5	개소	3	
		이종벽관	Φ300	M	0	
		이종벽관	Φ300	M	13	
	메쉬웬스	H=1.5,L=2.0	경간	0		
	벤치플름관	400C	본	12		
	벤치플름관	400C	본	13		
	전석쌓기	0.5㎡	㎡	0		
	전석쌓기	0.5㎡	㎡	18.2		
	회양목및철죽	0.3*0.3	주	0		
	회양목및철죽	0.3*0.3	주	200		


☑ 수목 계획수량표


성상	기호	수목명	규격	단위	수량	비고
초화류		식생매트	100x100xT2	M2	0.0	
					240.0	

☑ 시설물 계획수량표


구분	기호	품명	규격	단위	수량	비고
시설물		석축	H1,300xW1,200	M	150	
		침사지	2,000x2,000	개소	166	
		스크린	H950	개소	4	
		스크린	H950	개소	4	
		홀관	Ø800	본	1	
		홀관	Ø800	본	5	
		홀관	Ø800	본	5	
	석축	H1,500	M	8		
	건널목	2.0*2.5	개소	0		
	이종벽관	Φ300	m	2		
	이종벽관	Φ300	m	0		
	이종벽관	Φ300	m	10		

☑ 수목 계획수량표

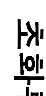성상	기호	수목명	규격	단위	수량	비고
초화류		식생매트	100x100xT2	M2	0.0	
					300.8	

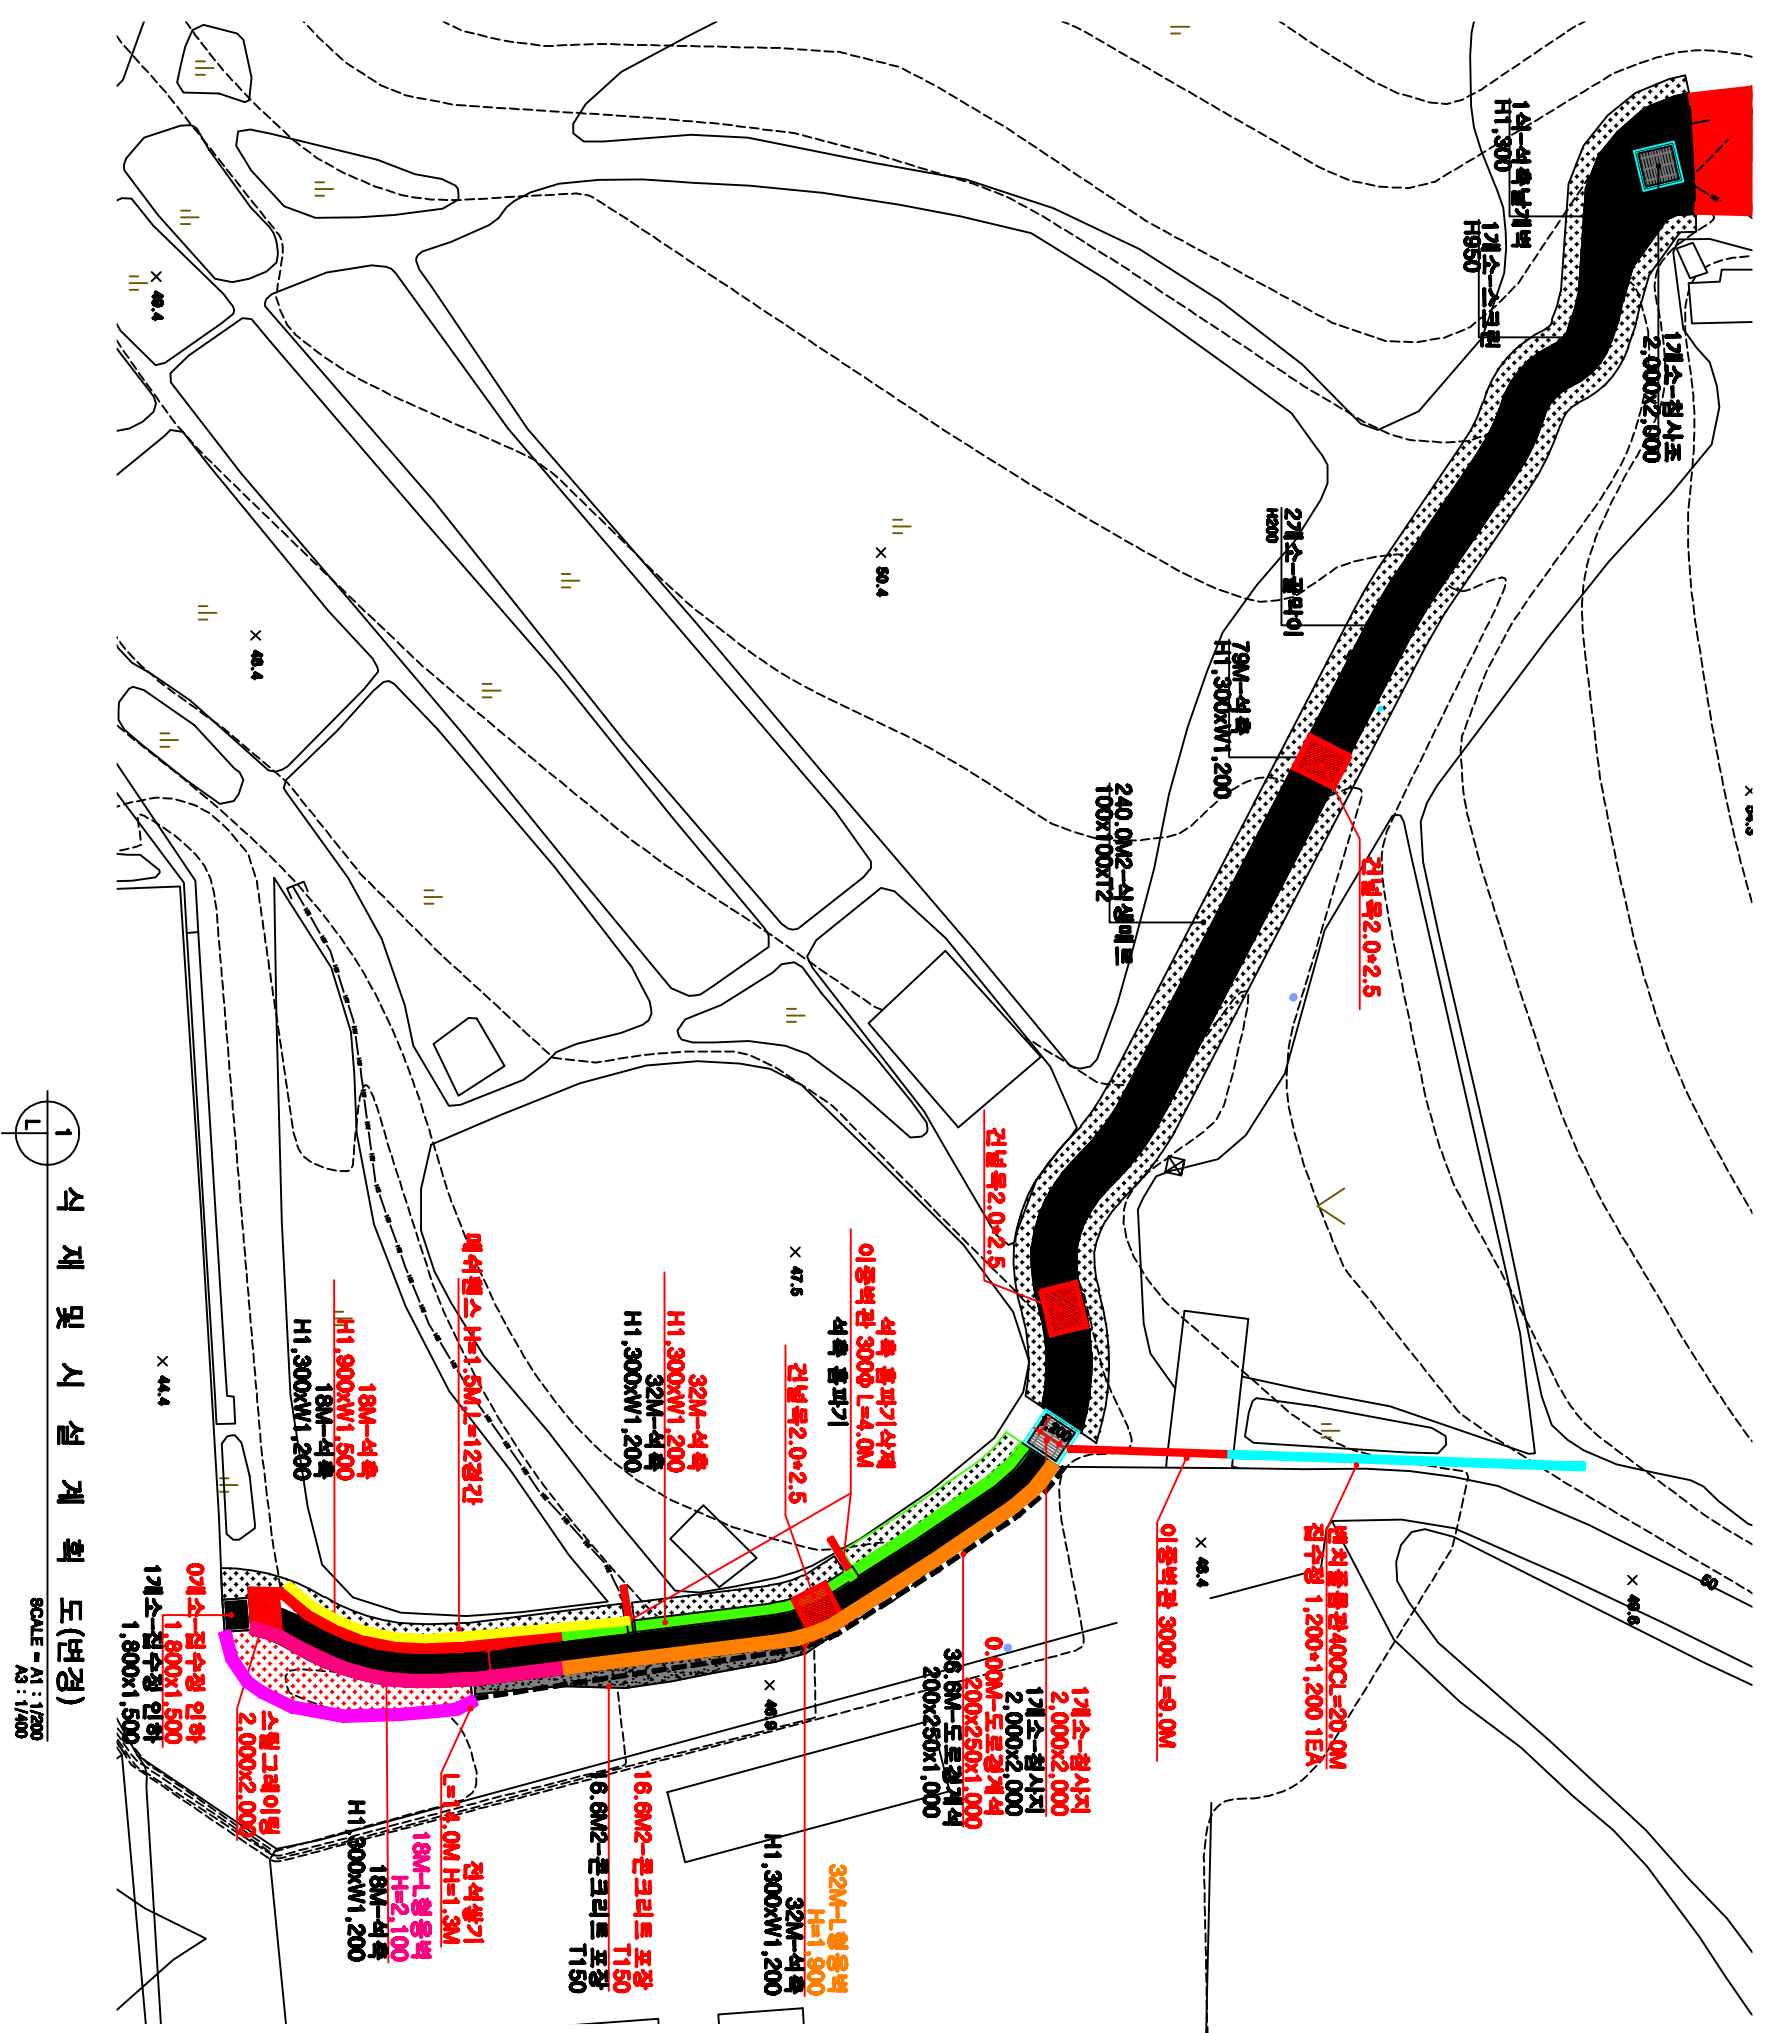


식재 및 시설 계획도(변경)

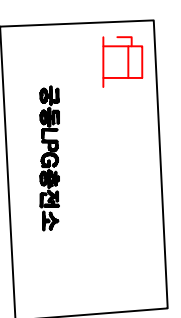

시설물 계획수량표 (변경)

구분	기호	종명	규격	단위	수량	비고
시설물	■	석축(2면)	H1,300xW1,200	M	82	
	■	석축(1면)	H1,300xW1,200	M	136	
	■	석축(1면)	H1,900xW1,200	M	36	
	■	옹벽	H=1,900	M	18	
	■	옹벽	H=2,100	M	32	
	■	옹벽	H=1,300	식	18	
	■	점수평 인하	1,800x1,500	개소	1	
	■	침사지	2,000x2,000	개소	1	
	■	침사조	2,000x2,000	개소	1	
	■	도로경계석	200x250x1,000	M	0	
시설물 계획수량표	■	콘크리트 포장	T150	M2	36.8	
	■	스크립	H950	개소	18.8	
	■	스크립	H200	개소	18.8	
	■	굴뚝이	H200	개소	2	석축포함
	■	건널목	2.0x2.5	개소	3	
	■	이중벽관	φ300	M	3	
	■	페쉬켄스	H=1.5L=2.0	경간	13	
	■	벤치플플관	400C	본	13	
	■	전석쌓기	0.5㎡	㎡	18.2	
	■	회양목및철축	0.3x0.3	주	200	
시설물 계획수량표	■	수목형	규격	면적	수량	비고
	■	식생매트	100x100xT2	M2	240.0	

식재 및 시설 계획도 - 1 (중동 271번지일대)

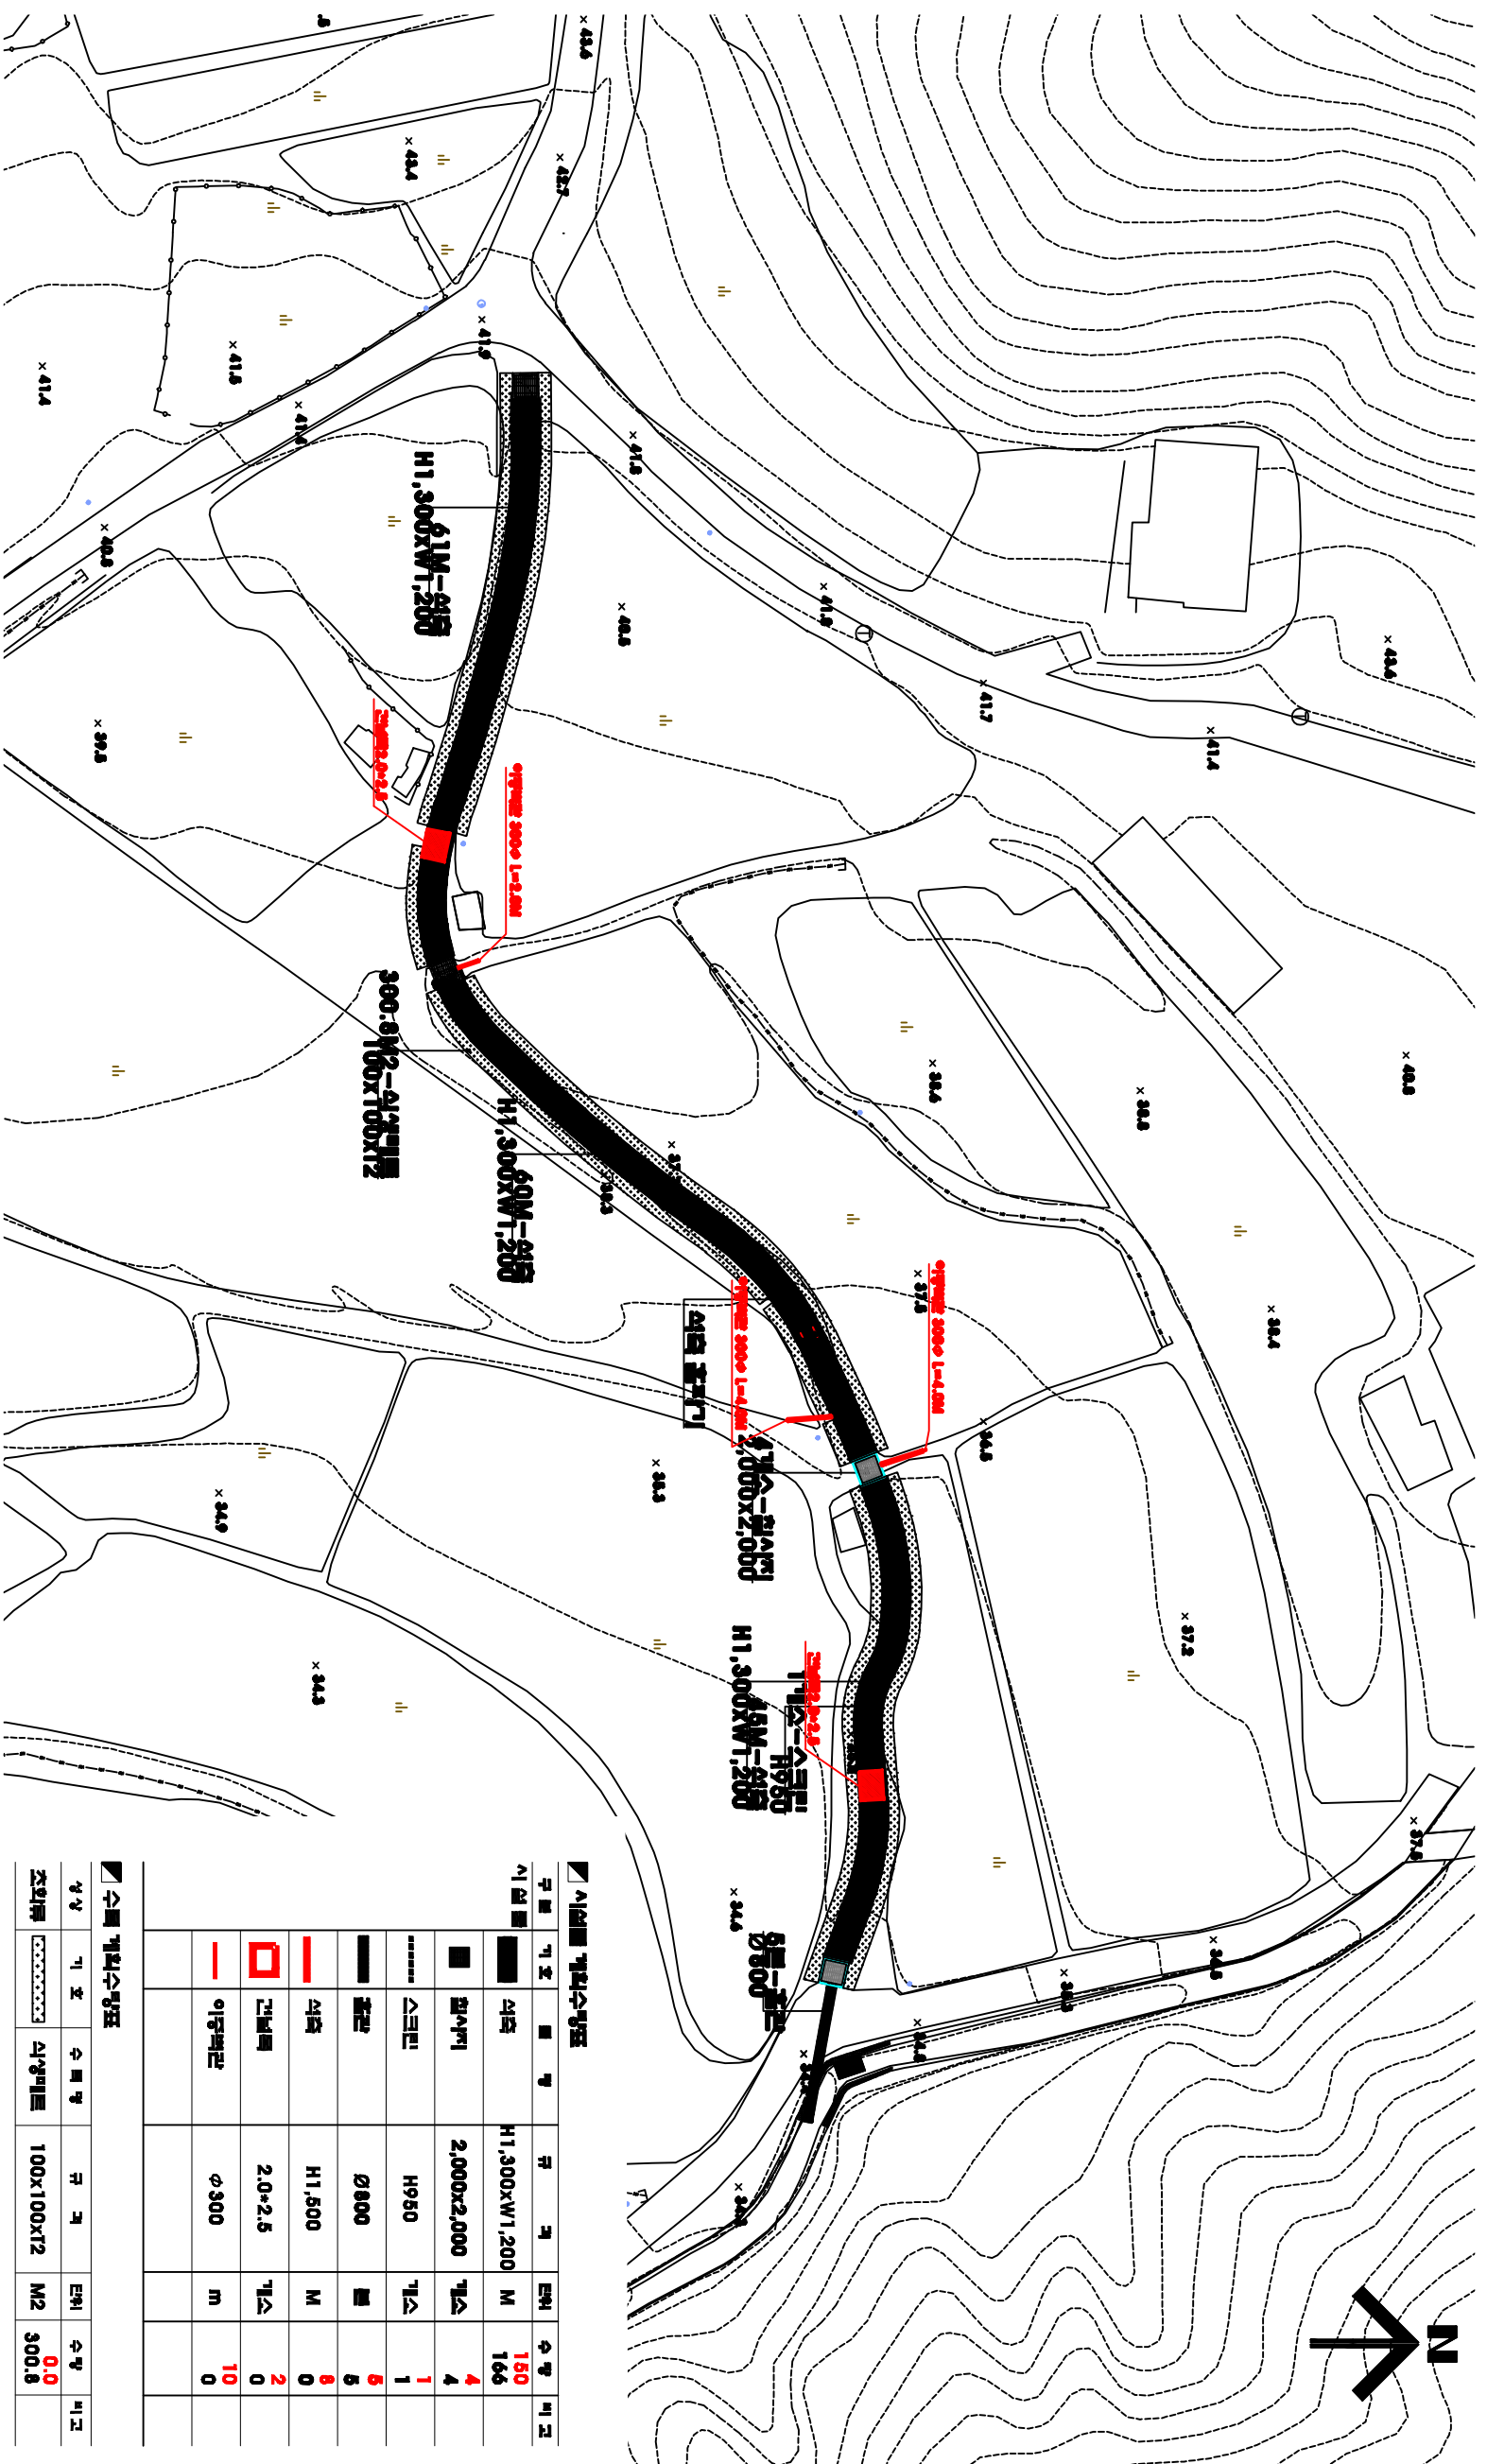

식재 및 시설 계획도(본경)

SCALE = A1 : 1/300
A3 : 1/600







식재 및 시설 계획도 - 2 (구방 산1-63번지(일부))


1/300
1/600
L-007

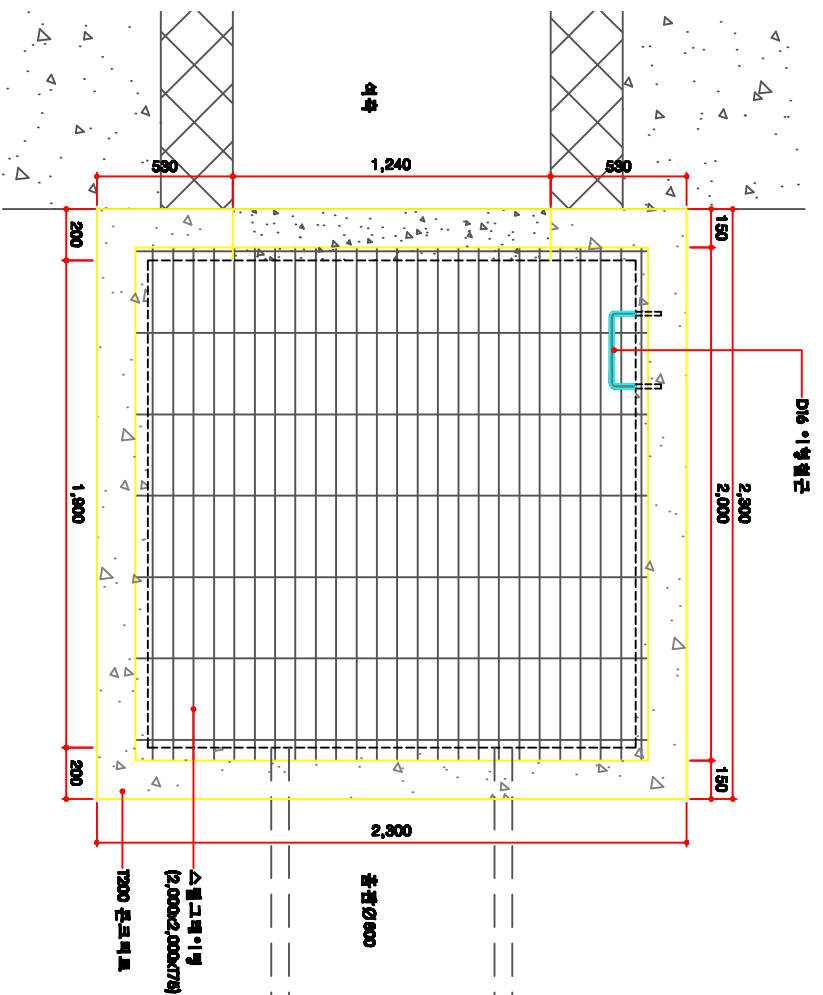


1 철사지평면도
SCALE = A1 : 1/15
A3 : 1/30

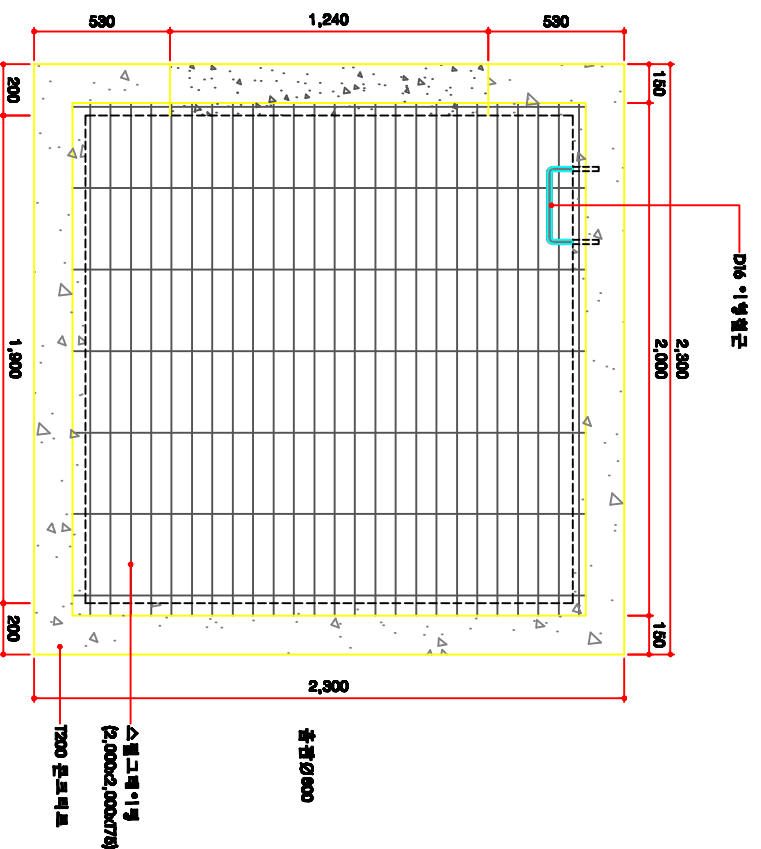


4 철사조평면도
SCALE = A1 : 1/15
A3 : 1/30

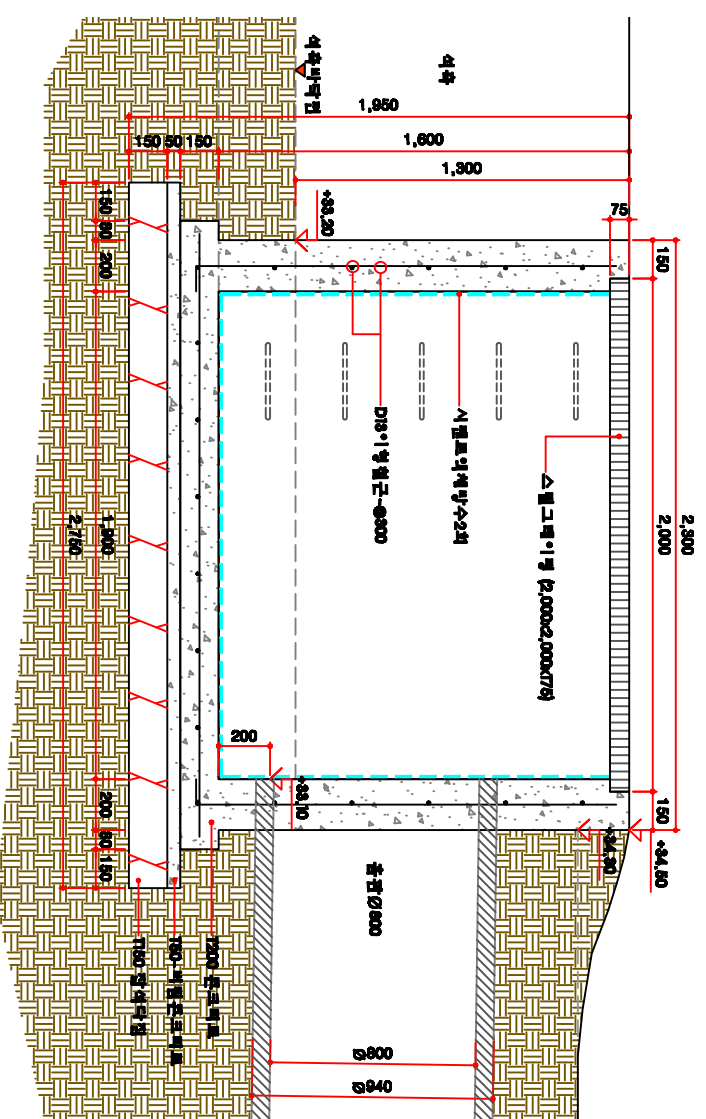


2 철사지단면도
SCALE = A1 : 1/15
A3 : 1/30

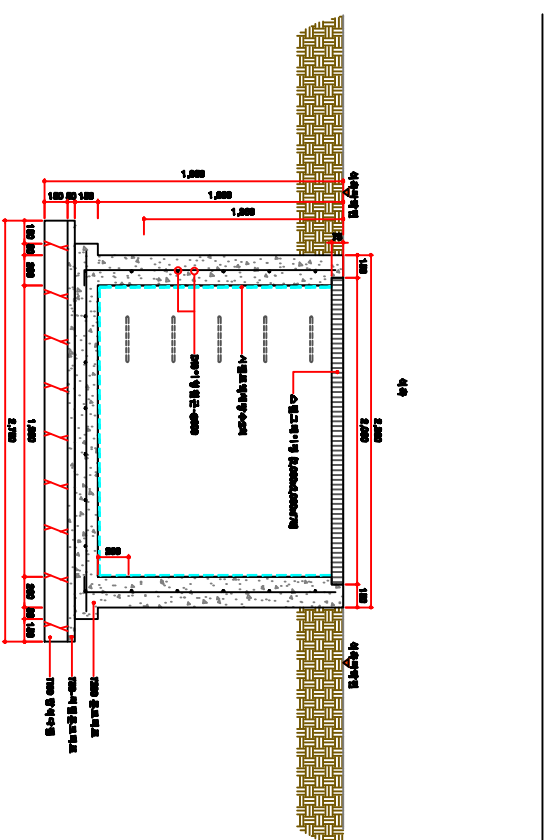

5 철사조단면도
SCALE = A1 : 1/15
A3 : 1/30

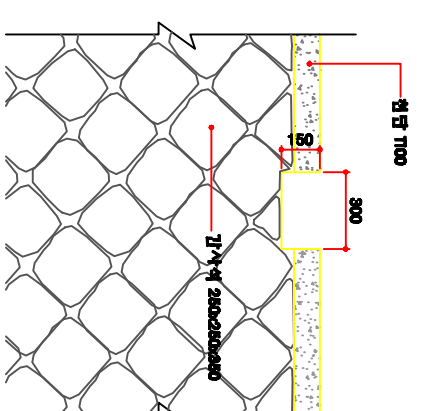

3 석축홈파기상세도
SCALE = A1 : 1/15
A3 : 1/30

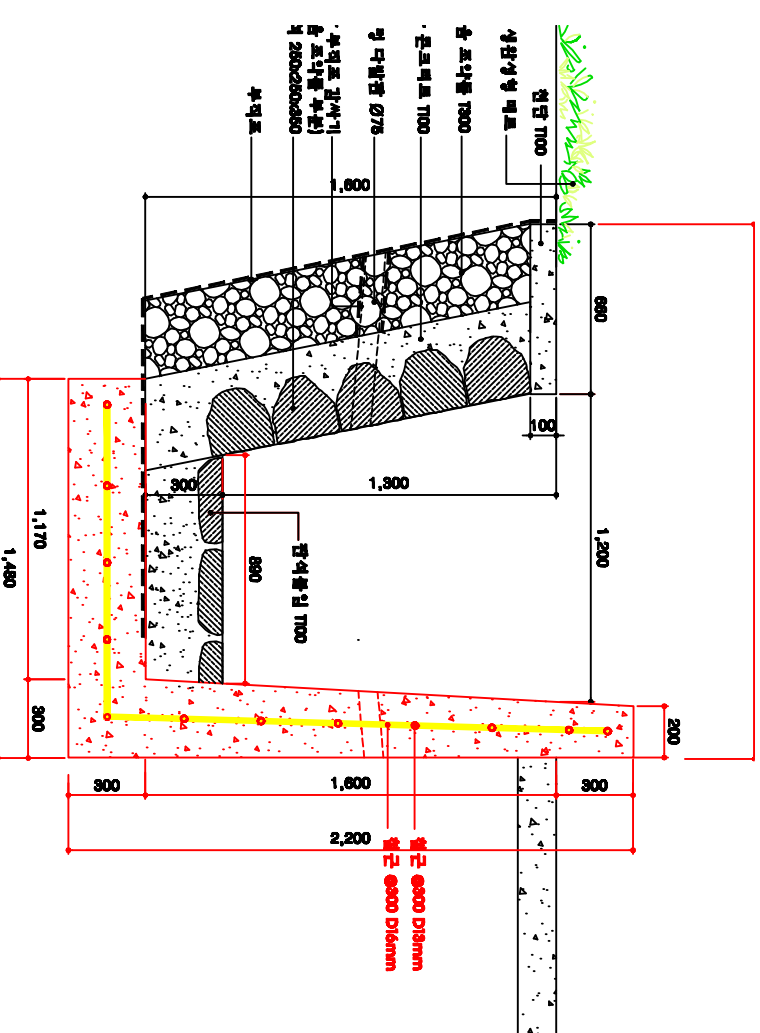

6 석축단면도
SCALE = A1 : 1/15
A3 : 1/30

철사지, 철사포, 석축, 상세도


1/15
1/30

L-008


석축 및 응벽 상세도(변경)

1/15
1/30

L-008-1

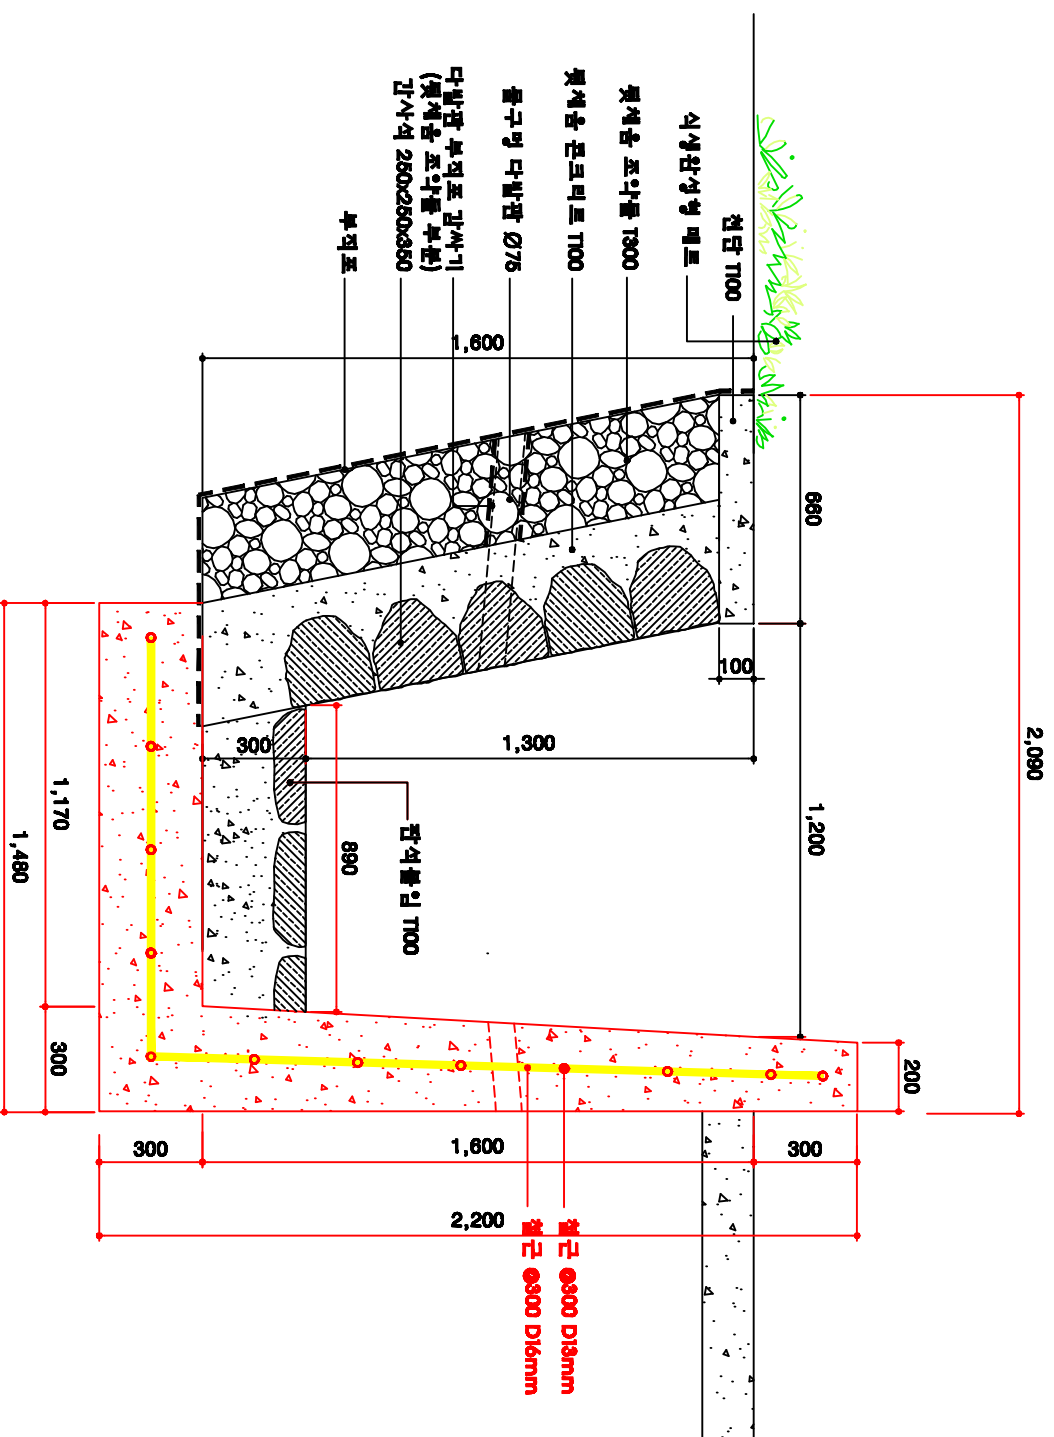

6 석축 및 응벽 단면도
SCALE = A3 : 1/15
A3 : 1/30

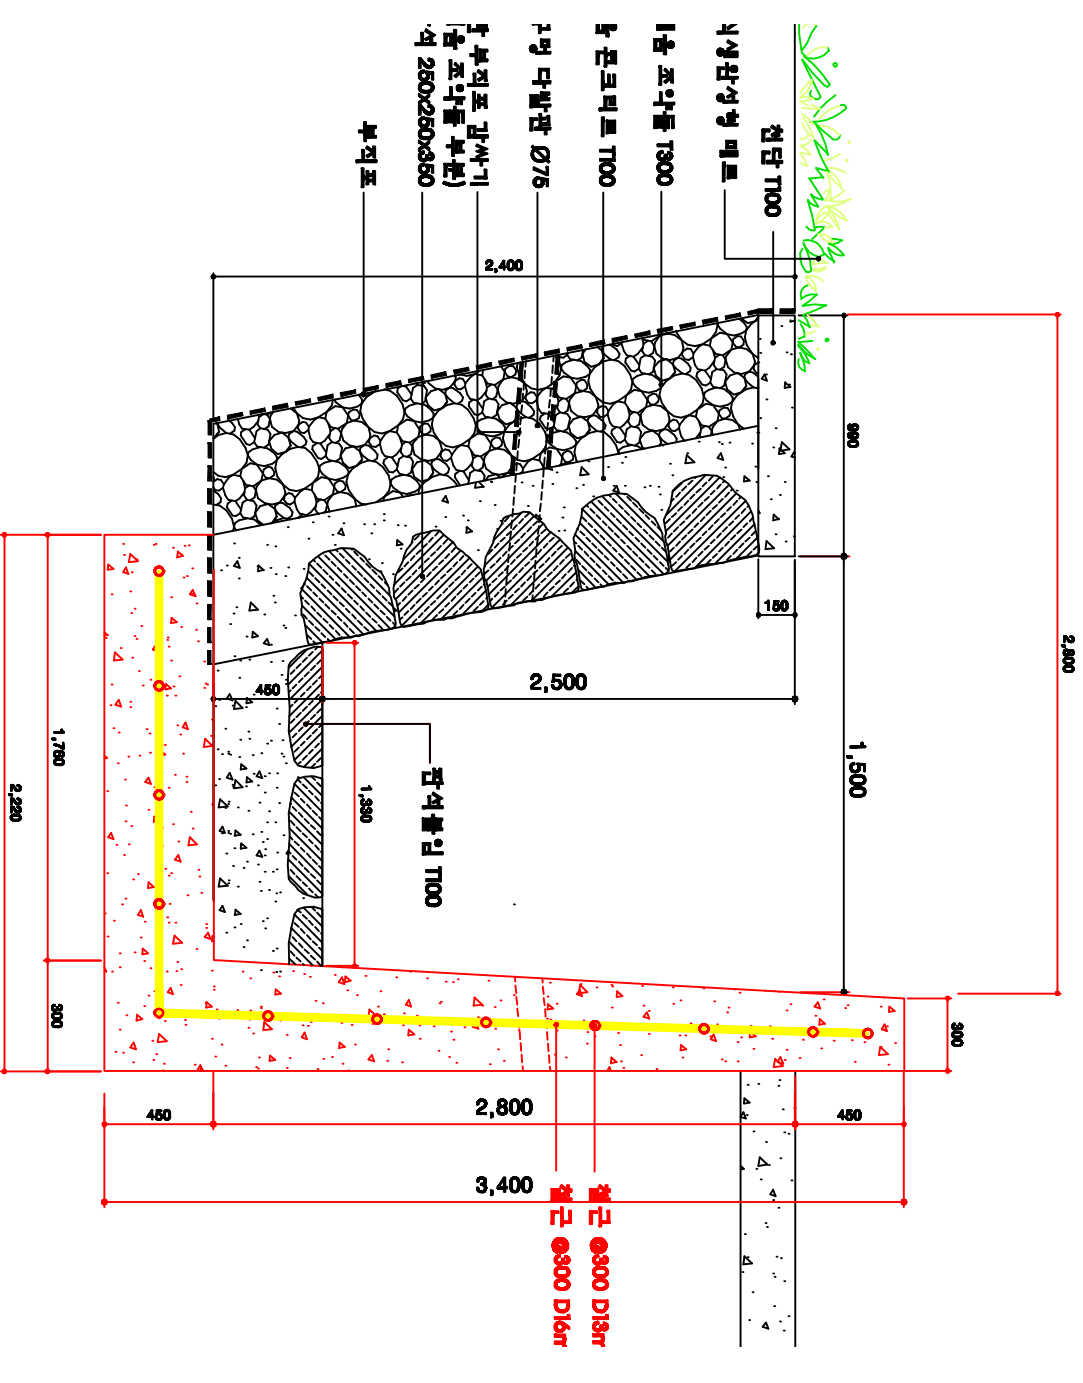

4 석축 및 응벽 단면도
SCALE = A3 : 1/15
A3 : 1/30