



□ 1156번(→ 2212번)

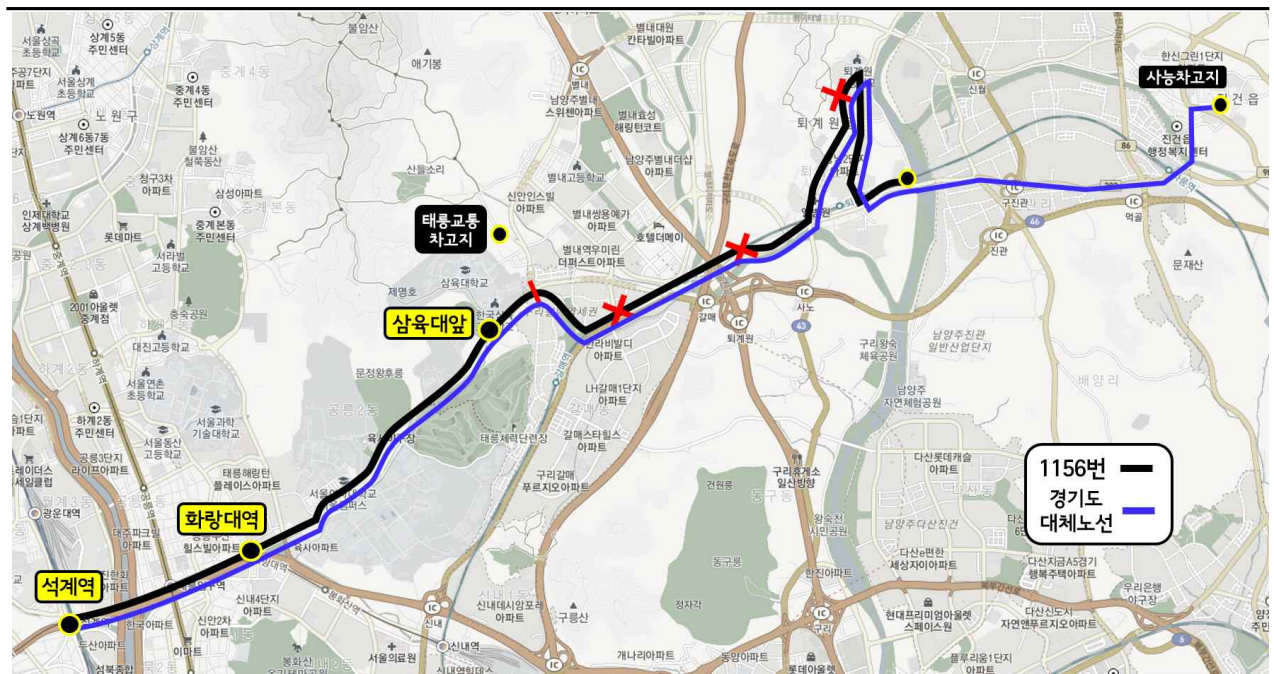

【참고】 경기도 대체노선 운영현황



□ 2236번

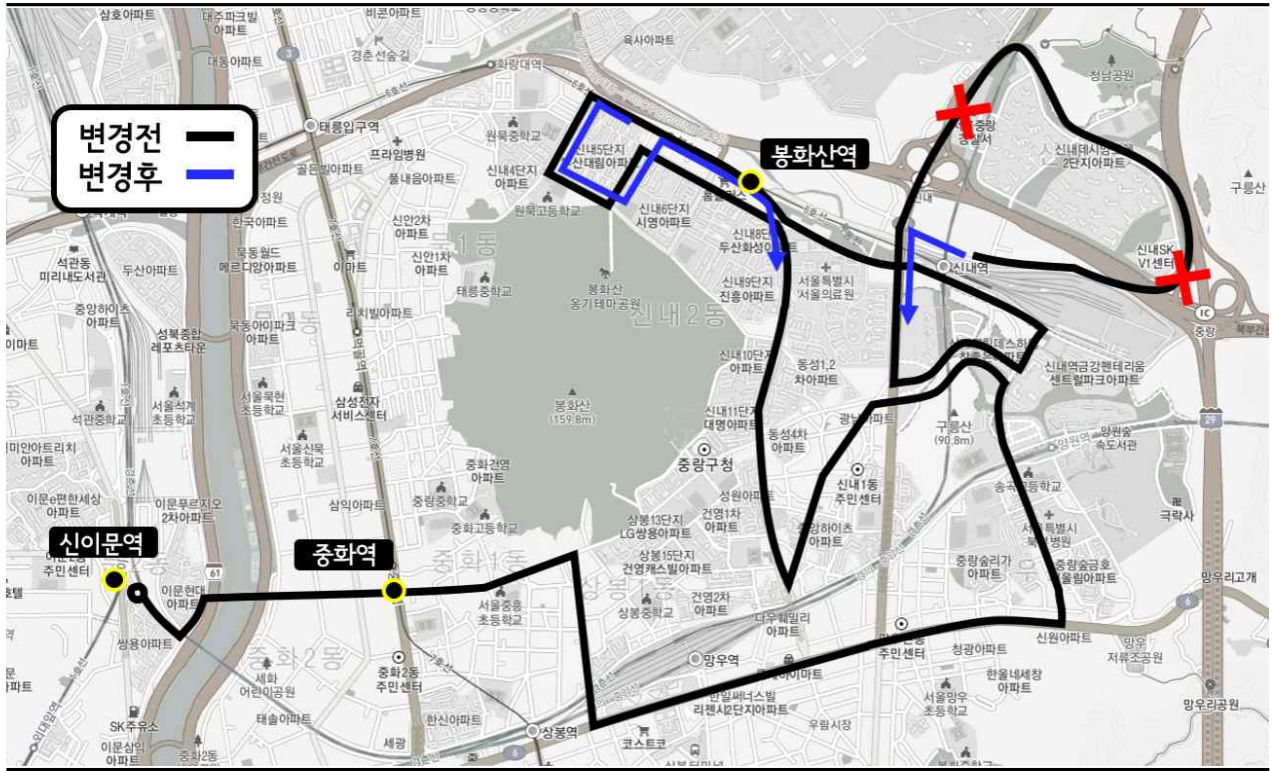

□ 2115번

