










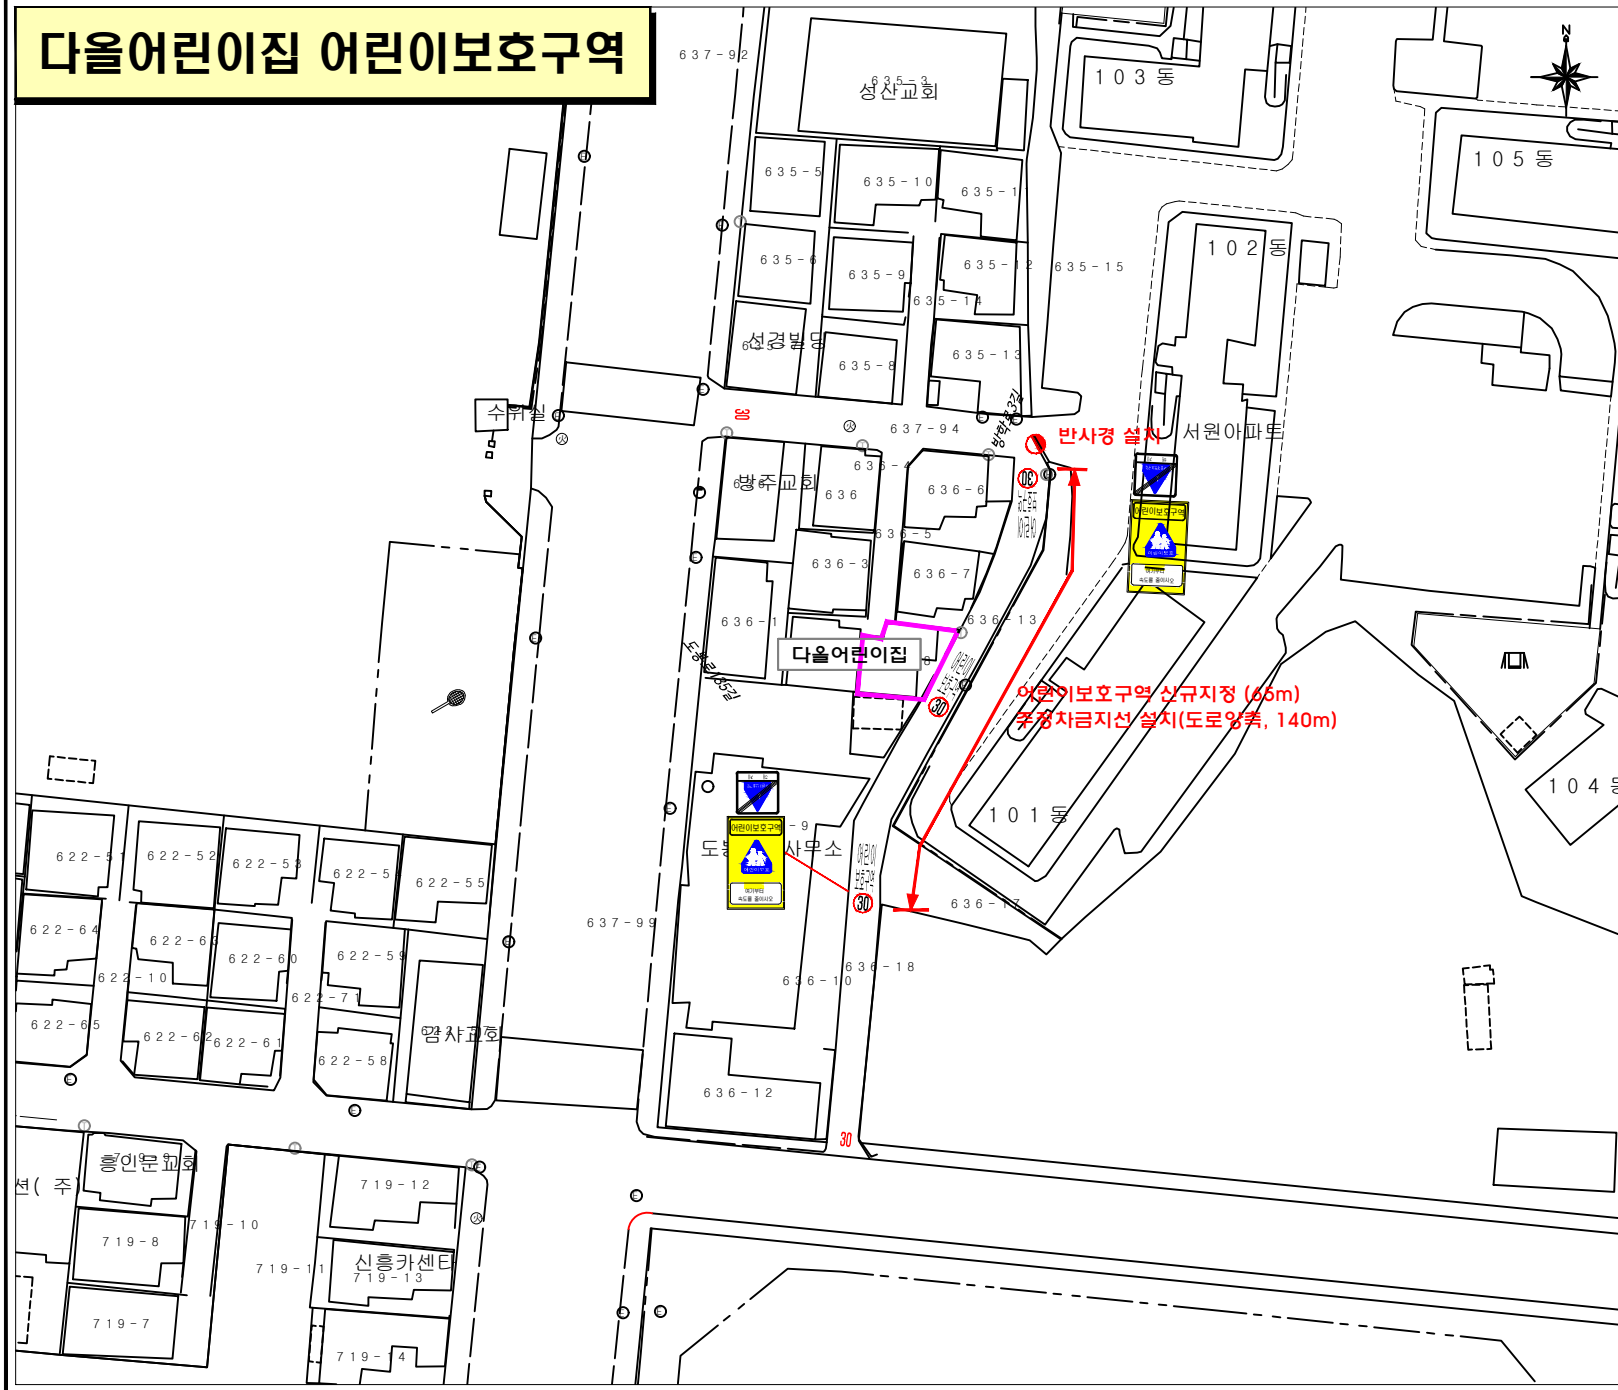

다올어린이집 어린이보호구역



구분	범례	구분	항목	단위	수량		
					현황	개선 신설 교체 제거	
구분	현황 - 백색	신호등	경보등	개소			
	신설 - 적색	신호등	신호등	개소			
			소계	개	4		
			129	개			
제거 - 청색	신호등	101	개				
		324	개				
통합 표지	(324,402,415)  어린이보호구역 (324,427)  어린이보호구역 (324,226)  어린이보호구역 (324,219)  어린이보호구역 (324,224)  어린이보호구역 (219,428)  어린이보호구역	안전표지					
		418	개				
		428	개				
		317	개				
		117-1	개				
		214	개				
		220	개				
		513	개				
		통합표지					
		324,402,415	개	2			
		324,427	개	2			
		324,224	개				
		324,226	개				
		324,219	개				
224,427	개						
노면 표지	(324,219)  어린이보호구역 (324,224)  어린이보호구역 (219,428)  어린이보호구역	516	m	140			
		517	개	2			
		518	개	3			
		519	개				
		536	개	3			
도로 부 설 물	(219,428)  어린이보호구역	소계	개				
		과속방지턱	개				
		도로반사경	개	1			
		미끄럼방지포장	개소				
			방호울타리	개소			
도면번호 :							

도면명	시설명	위치	일자	도면번호
어린이 보호구역 개선안도	다올어린이집	서울 도봉구 마들로672-26	-	-