


부 록


1. 시험 위치도
2. 균열 및 변형 위치도
3. 콘크리트 강도 측정 DATA
4. FERROSCAN IMAGE
5. 구조검토 근거
6. 보강 위치도
7. 건축물 대장

부록 1. 시험위치도

도 시	내 용
■	철근배근 상태 조사
▲	콘크리트 강도 조사
●	초음파 시험 조사

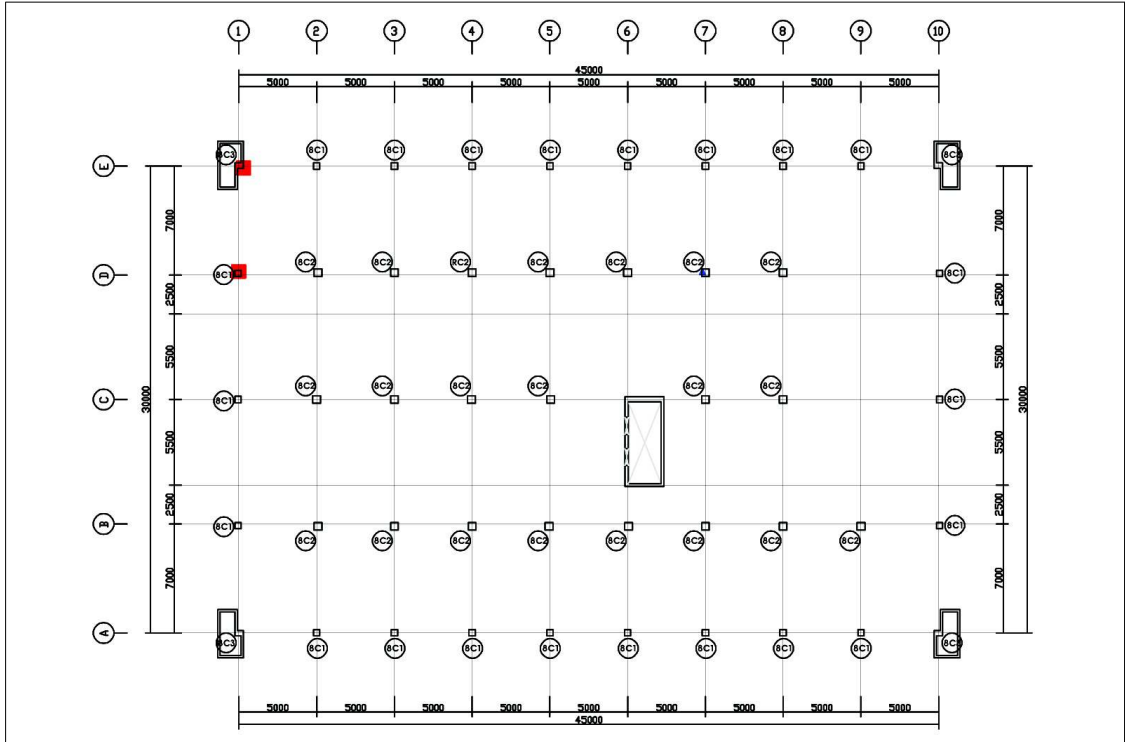


[그림 1] 지상8층 바닥 시험 위치도

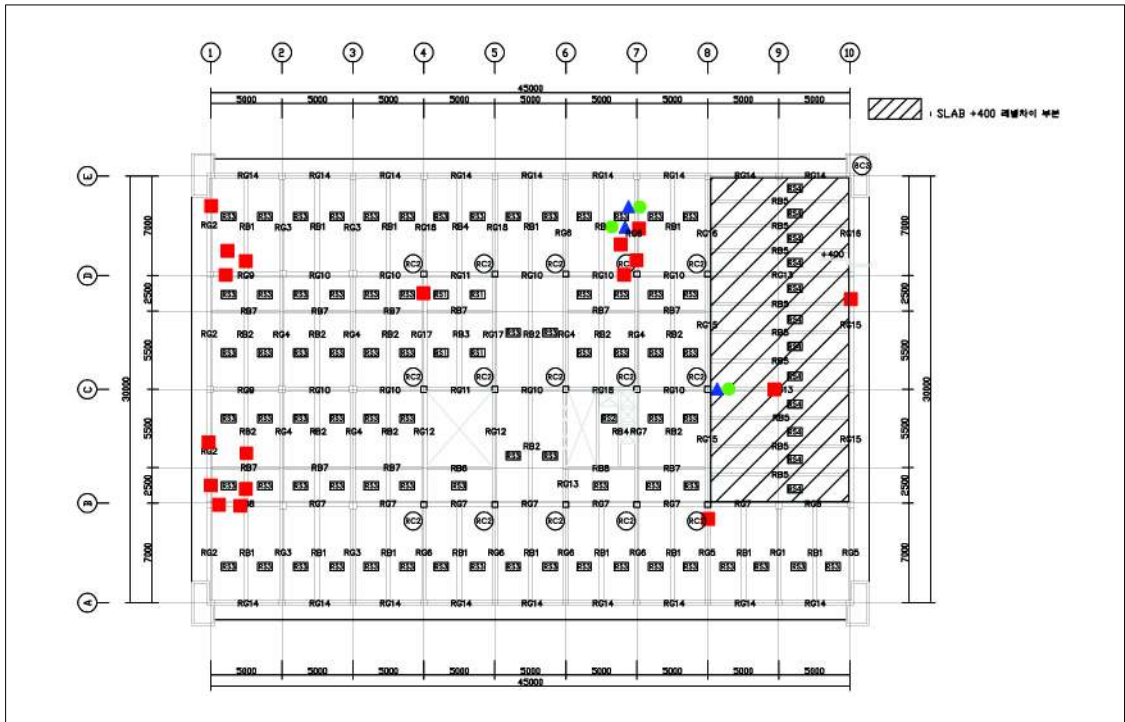


[그림 2] 지붕층 바닥 시험 위치도


부록 2. 균열 및 변형 위치도

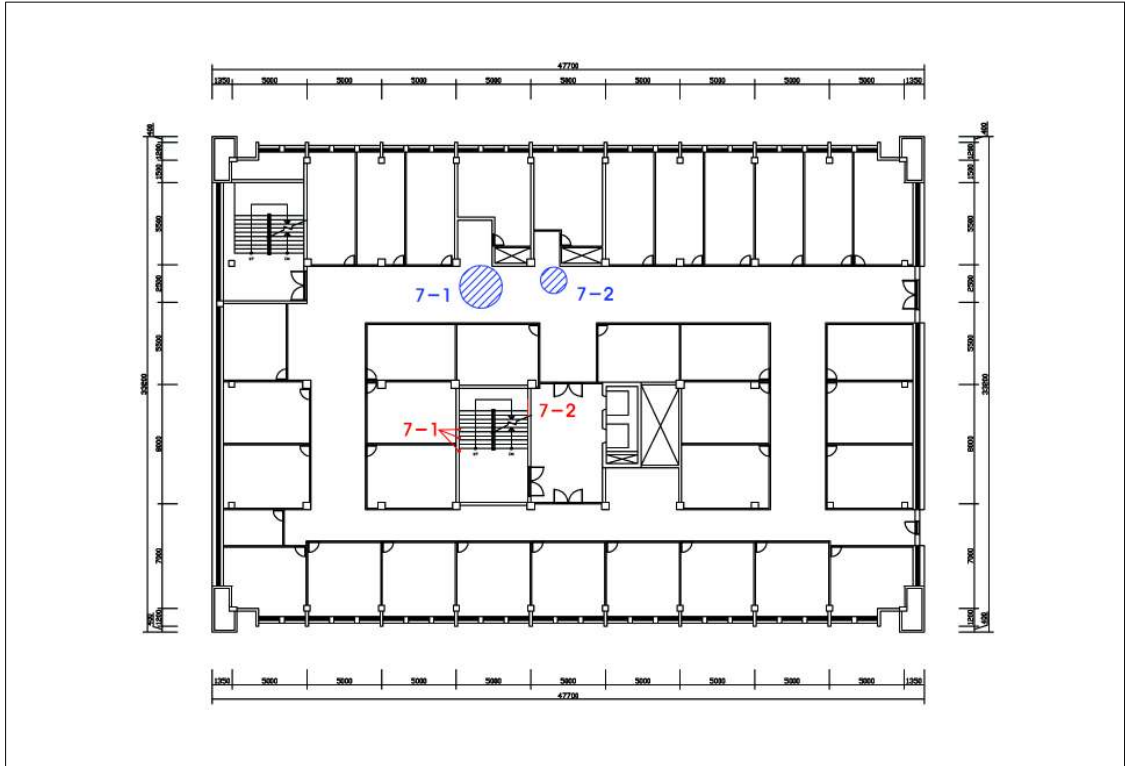

[그림 3] 지상7층 균열 및 변형 위치도

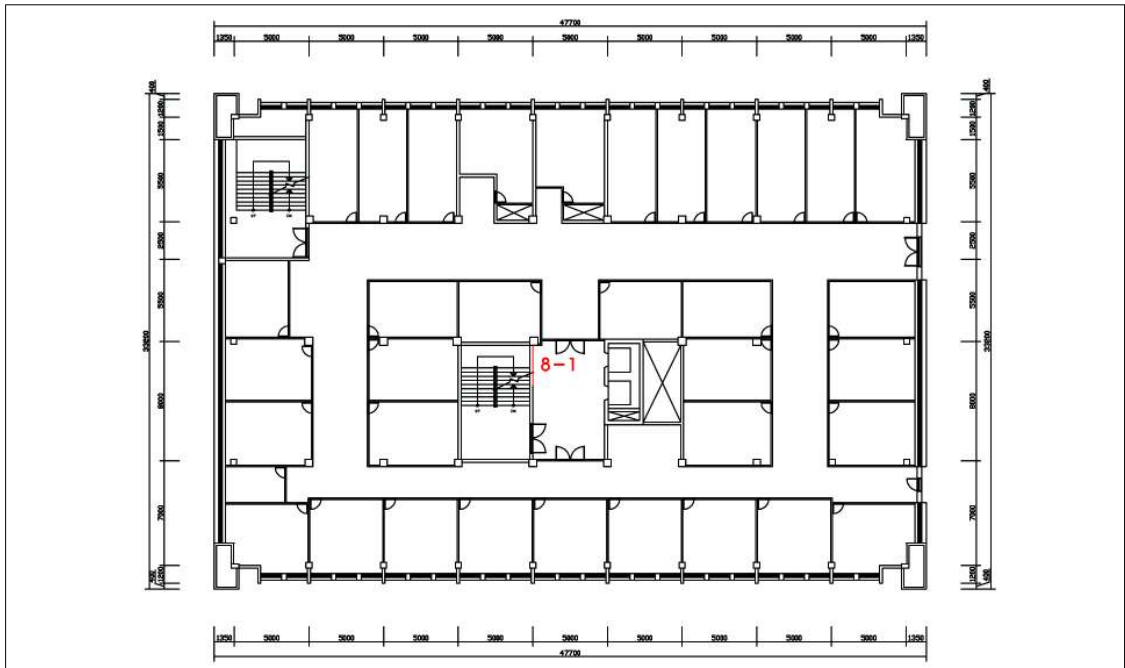

[그림 4] 지상8층 균열 및 변형 위치도

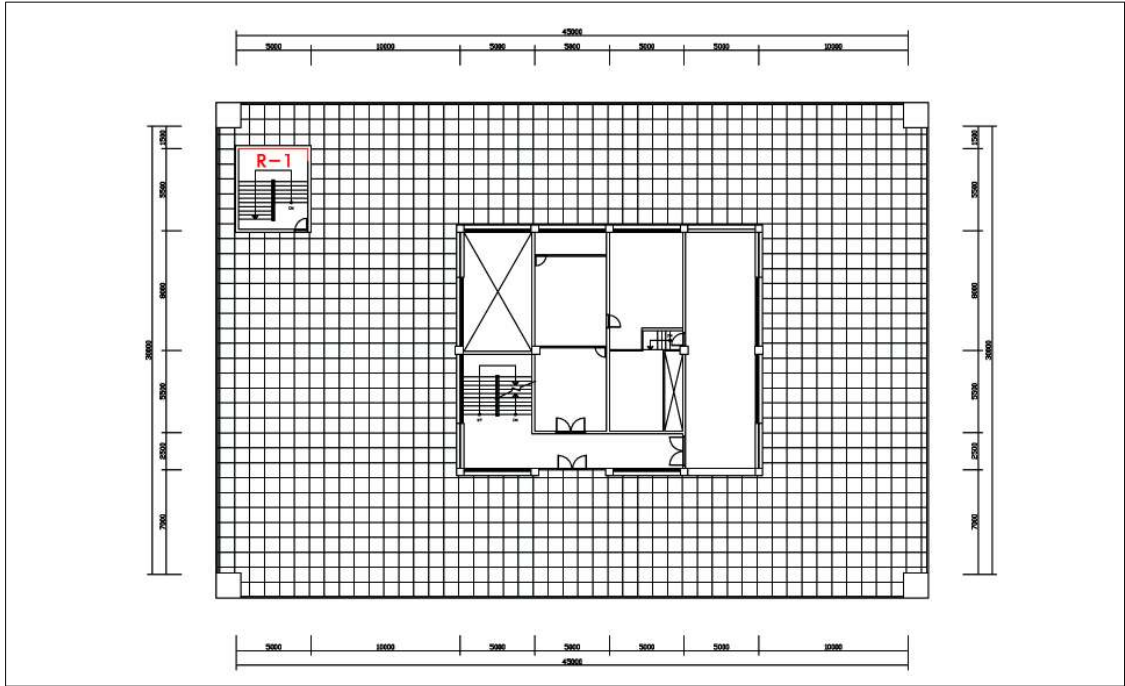

[그림 5] 지붕층 균열 및 변형 위치도


부록 3. 콘크리트 강도 측정 DATA


☐ 슈미트 해머 이미지

<p>PROCEQ - DIGISCHMIDT (4.2, 85-2369, ND 4050)</p> <p>Title: AAAAAAAAAA 2459 Date: 25-Aug-2008 10:44 Name:</p> <p>Remarks:</p> <p style="text-align: right;">1</p>	<p>PROCEQ - DIGISCHMIDT (4.2, 85-2369, ND 4050)</p> <p>Title: AAAAAAAAAA 2460 Date: 25-Aug-2008 10:45 Name:</p> <p>Remarks:</p> <p style="text-align: right;">2</p>
<p>PROCEQ - DIGISCHMIDT (4.2, 85-2369, ND 4050)</p> <p>Title: AAAAAAAAAA 2461 Date: 25-Aug-2008 11:29 Name:</p> <p>Remarks:</p> <p style="text-align: right;">3</p>	<p>PROCEQ - DIGISCHMIDT (4.2, 85-2369, ND 4050)</p> <p>Title: AAAAAAAAAA 2462 Date: 25-Aug-2008 14:39 Name:</p> <p>Remarks:</p> <p style="text-align: right;">4</p>


부록 4. FERROSCAN IMAGE

⊞ 철근배근 탐사 IMAGE

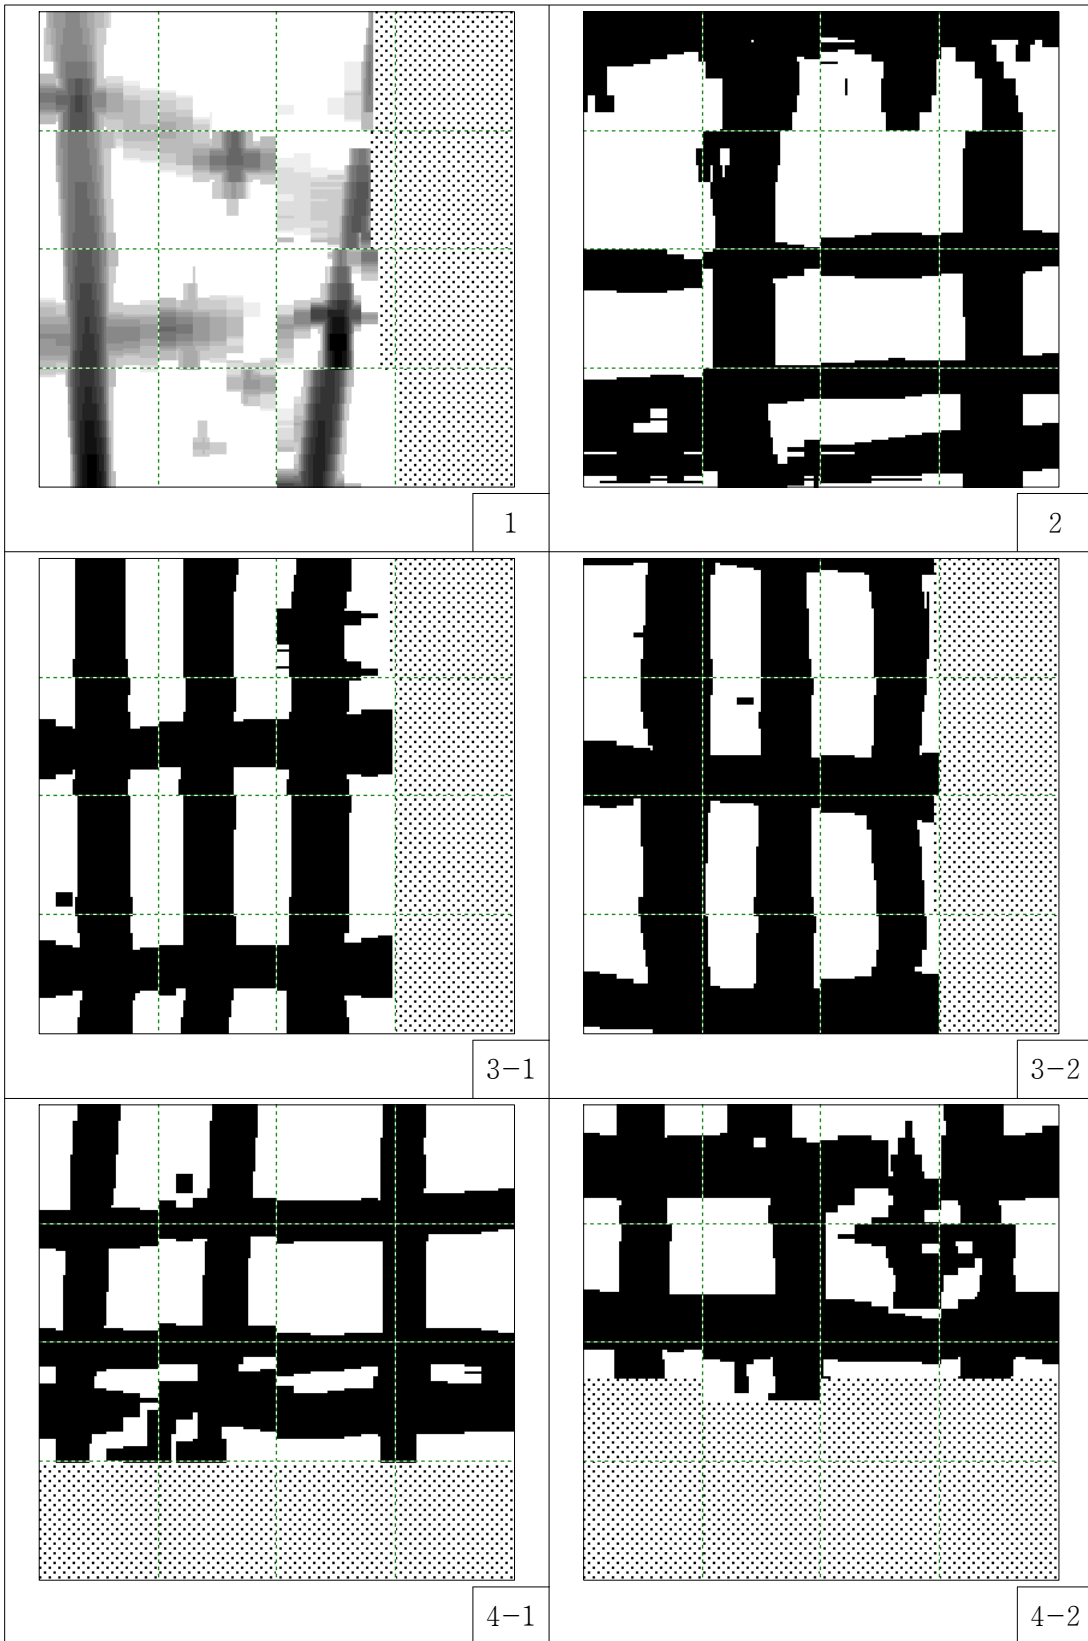


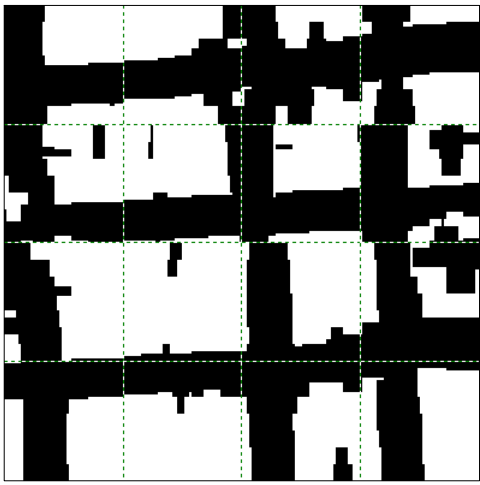


5

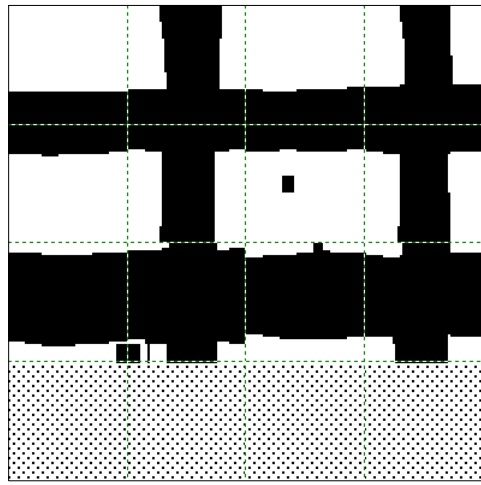


6

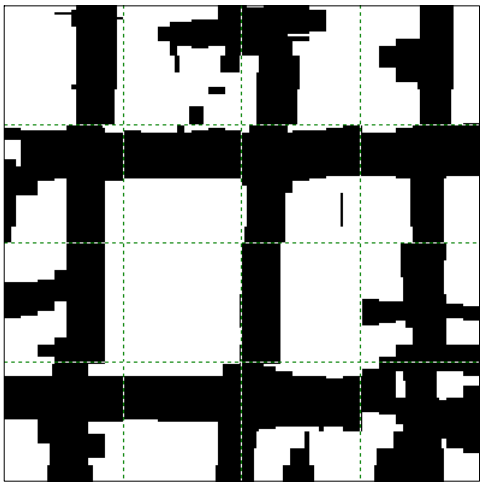


7

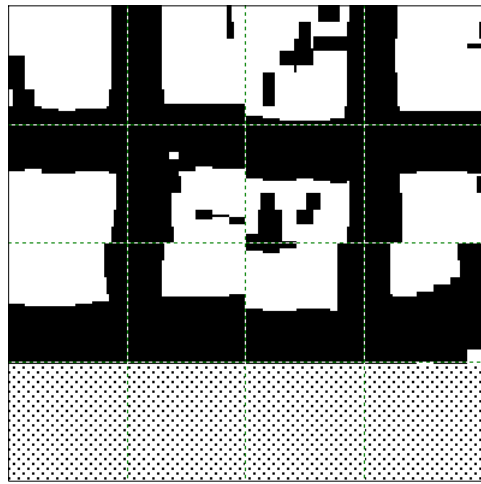


8-1

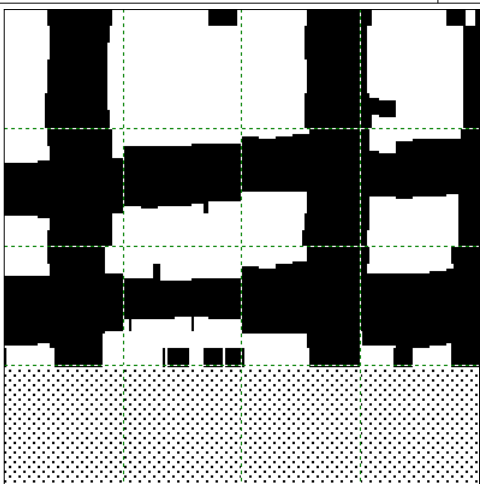


8-2

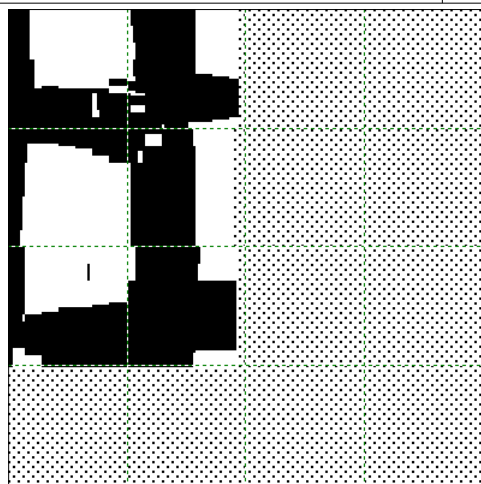


9

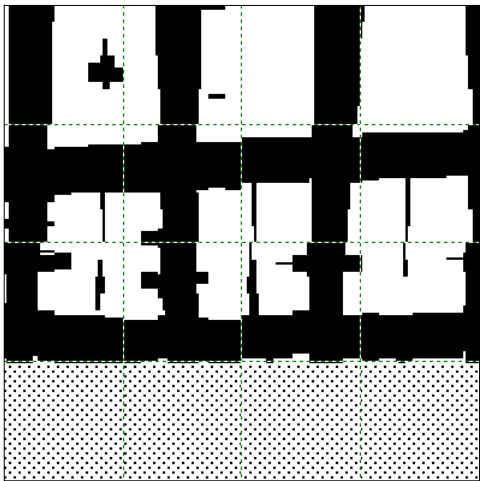


10

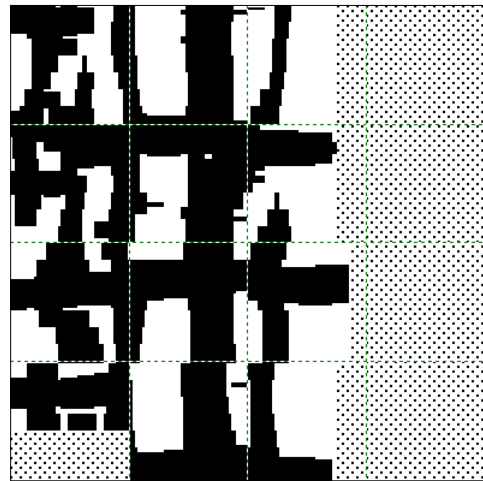


11

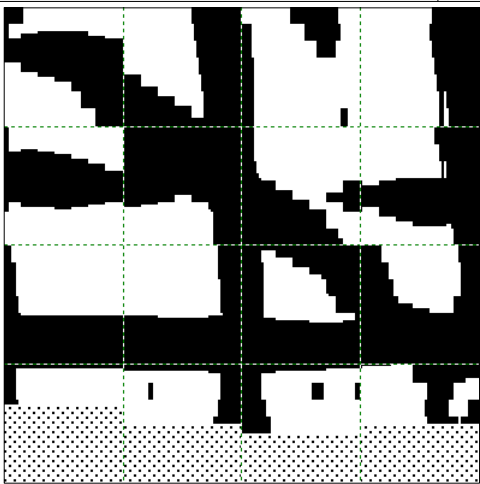


12-1

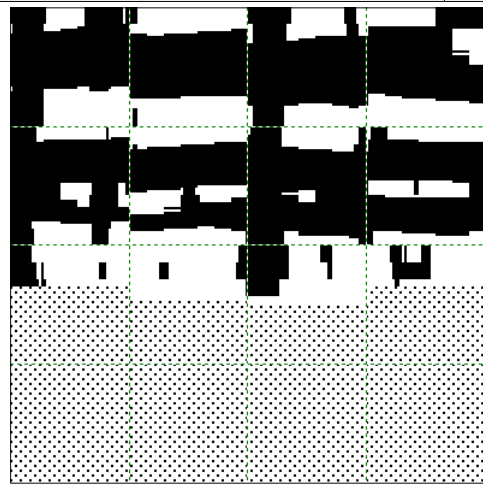


12-2

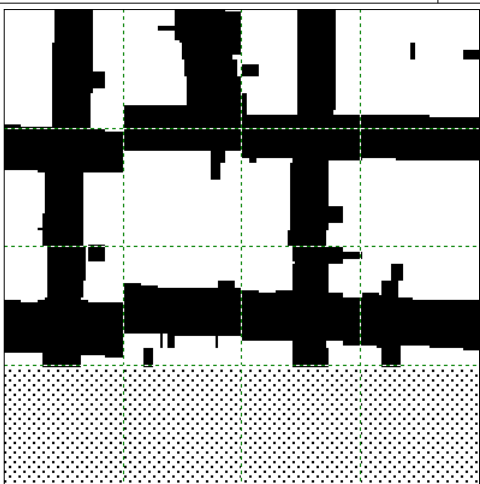


13

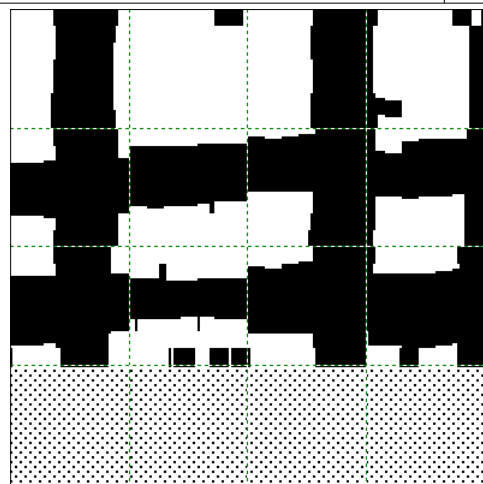


14

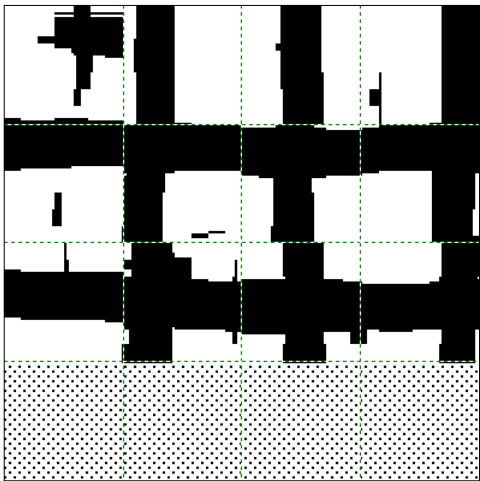


15

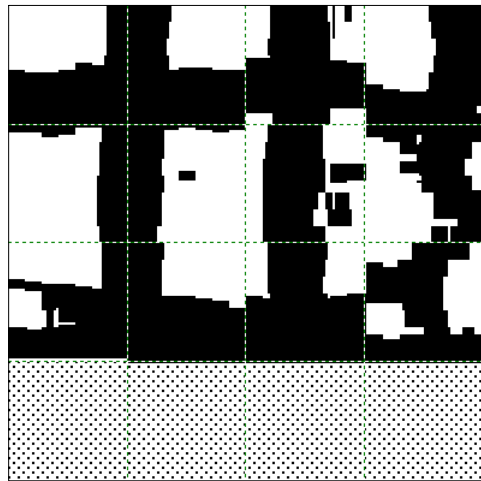

16

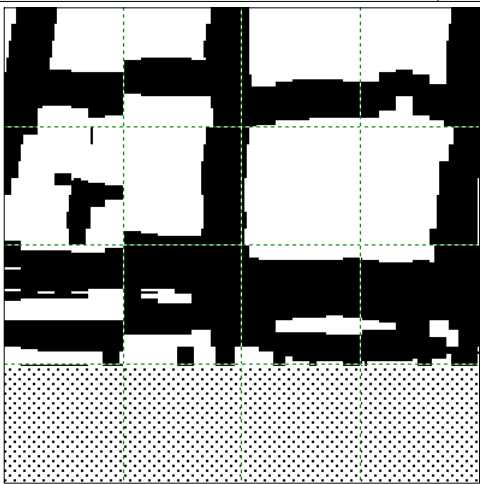


17

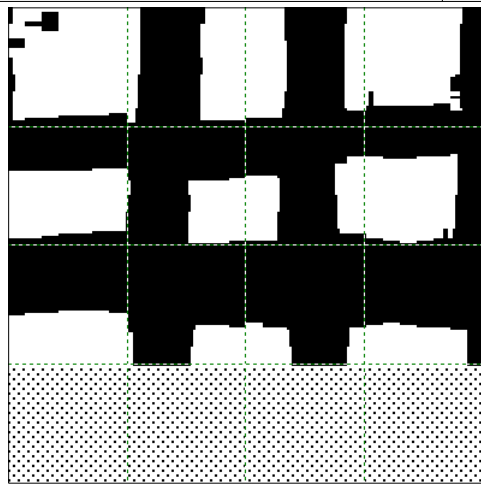


18

부록 5. 구조검토 근거

	Company	o	Project Name	
	Designer	o	File Name	

1. Geometry and Materials

Design Code : KCI-USD99 (Build.)
 Material Data : $f_{ck} = 180 \text{ kgf/cm}^2$
 $f_y = 2400 \text{ kgf/cm}^2$
 Slab Span L : 1.70 m (Both End Fixed)
 Slab Depth : 120 mm ($c_c = 20 \text{ mm}$)

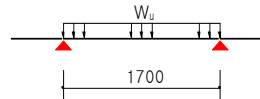

2. Applied Loads

Dead Load : $W_d = 0.97 \text{ tf/m}^2$
 Live Load : $W_l = 0.20 \text{ tf/m}^2$
 $W_u = 1.4 \cdot W_d + 1.7 \cdot W_l = 1.70 \text{ tf/m}^2$

3. Check Minimum Slab Thk.

$h_{min} = L/28 = 61 \text{ mm}$
 $h = h_{min} \cdot (0.43 + f_y/7000) = 47 \text{ mm}$
 Thk = 120 > Req'd Thk = 47 mm O.K.


4. Reinforcement

Strength Reduction Factor $\Phi = 0.900$

	Short Span			Minimum Ratio ($\omega_c < 0.4$)
	Cont.	Cent.	DisCon	
M_u (tf-m/m)	0.41 ($W_u L^2/12$)	0.31 ($W_u L^2/16$)	0.00	
ρ (%)	0.209	0.156	0.000	0.200
A_{st} (cm^2/m)	2.00	1.50	0.00	2.40
D6	@ 150	@ 210	@ 400	@ 130
D6+D10	@ 250	@ 340	@ 400	@ 210
D10	@ 350	@ 400	@ 400	@ 290
D10+D13	@ 400	@ 400	@ 400	@ 400


5. Check Shear Stresses

Strength Reduction Factor $\Phi = 0.850$
 $V_{uk} = 1.44 < \Phi V_c = 5.80 \text{ tf/m}$ O.K.

	Company	.	Project Name	
	Designer	.	File Name	

1. Geometry and Materials

Design Code : KCI-USD99 (Build.)
 Stress Profile : Parabolic
 Material Data : $f_{ck} = 180 \text{ kgf/cm}^2$ ($\beta_1 = 0.850$)
 $f_y = 2400$, $f_{ys} = 2400 \text{ kgf/cm}^2$
 Section : $75 \times 40 \text{ cm}$ ($h_f=15$, $b_f=100 \text{ cm}$)
 Top Bar (Layer 1) : 4 - D22 ($d_r = 6.00 \text{ cm}$)
 Bot. Bar (Layer 1) : 5 - D22 ($d_b = 6.00 \text{ cm}$)
 Bot. Bar (Layer 2) : 2 - D22 ($d_b = 11.00 \text{ cm}$)
 Stirrups : 2 - D10 @ 200

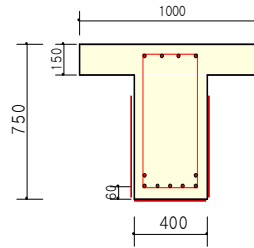

2. Strengthening Materials

Location	W_{FRP} (mm)	T_{FRP} (mm)	f_{FRP} (tf/cm ²)	$\epsilon_{FRP,Allow}$	Reduc.F(β)
1	400	0.501	35.5	0.015	0.7486
2	500	0.167	35.5	0.015	0.7

3. Member Force and Moment


$M_u = 70.80 \text{ tf-m}$ $V_u = 41.90 \text{ tf}$

4. Check Tension Reinforcement

$A_s = \sum(A_{bar} + A_{FRP} * (f_{FRP}/f_y) * \beta) = 49.29 \text{ cm}^2$
 $A_s' = \sum(A_{bar}') = 15.48 \text{ cm}^2$
 $d_c = (A_s * \sum d_{ci}) / (A_s) = 4.08 \text{ cm}$
 $d_c' = (A_s' * \sum d_{ci}') / (A_s')$ = 6.00 cm
 $d = H - d_c = 70.92 \text{ cm}$
 $A_{s,min1} = (0.8\sqrt{f_{ck}}/f_y) * B * d = 12.69 \text{ cm}^2$
 $A_{s,min2} = (14/f_y) * B * d = 16.55 \text{ cm}^2$
 $A_{s,min} = \text{Max}[A_{s,min1}, A_{s,min2}] = 16.55 < 49.29 \text{ cm}^2 \dots\dots \text{O.K.}$
 $\rho_b = 0.85\beta_1(f_{ck}/f_y) * 6000 / (6000 + f_y) = 0.0387$
 $f_{sb}' = 6000 - d_c' / d * (6000 + f_y) = 5.27 \text{ tf/cm}^2$
 $f_{sb} = \text{Min}[f_{sb}', f_y] = 2.40 \text{ tf/cm}^2$
 $A_{s,max} = 0.75\rho_b(H - d_c)B + A_s' * f_{sb}' / f_y = 221.35 > 49.29 \text{ cm}^2 \dots\dots \text{O.K.}$

5. Bending Moment Capacity - Before Strengthening

Neutral Axis Depth $c = 5.56 \text{ cm}$
 Compression : Concrete $C_c = 72.30 \text{ tf}$
 Compression : Rebar $C_s = 0.00 \text{ tf}$
 Tension : Rebar $T_s = -72.30 \text{ tf}$
 Strength Reduction Factor $\Phi = 0.900$
 Design Moment Strength $\Phi M_n = 38.34 \text{ tf-m}$
 Strength Ratio : $M_u / \Phi M_n = 1.846 > 1.300 \dots\dots \text{N.G.}$

	Company	.	Project Name	
	Designer	.	File Name	

6. Bending Moment Capacity - After Strengthening


- Neutral Axis Depth $c = 7.74$ cm
- Compression : Concrete $C_c = 99.11$ tf
- Compression : Rebar $C_s = 19.21$ tf
- Tension : Rebar $T_s = -65.03$ tf
- Tension : FRP $T_{FRP} = -53.26$ tf
- Strength Reduction Factor $\Phi = 0.900$
- Design Moment Strength $\Phi M_n = 71.50$ tf-m
- Strength Ratio : $M_u/\Phi M_n = 0.990 < 1.000$ O.K.

7. Check Strain in FRP at Required Flexural Strength

- Design Moment Strength $\Phi M_n = 70.80$ tf-m
- Neutral Axis Depth $c = 8.80$ cm
- Strain in Concrete $\epsilon_c = 0.0020$
- Max. Strain in FRP $\epsilon_{FRP} = 0.0147 < \epsilon_{FRP,Allow} = 0.0150$ ----> O.K.

8. Check Shear

- Strength Reduction Factor $\Phi = 0.850$
- $V_c = 0.53\sqrt{f'_c}Bd = 19.22$ tf
- $V_s = A_v f_y d/s = 11.57$ tf
- $V_{FRP} = \beta \cdot [2T_{FRP} f_{FRP} W_{FRP}] = 41.50$ tf
- $\Phi V_n = \Phi(V_c + V_s + V_{FRP}) = 61.44$ tf $> V_u = 41.90$ tf ----> O.K.

	Company	o	Project Name	
	Designer	o	File Name	

1. Design Conditions

Design Code : KCI-USD99 (Build.)
 Material Data : $f_{ck} = 180 \text{ kgf/cm}^2$
 : $f_y = 2400 \text{ kgf/cm}^2$ $f_{ys} = 2400 \text{ kgf/cm}^2$
 Section Dim. : 40 * 75 cm ($c_c = 4 \text{ cm}$)


2. Resisting Moment Capacity

A_s	A'_s	$\Phi M_n(\text{tf-m})$	d(cm)	ρ	ρ'	$\omega_c(\text{mm})$
2-D22	2-D22	11.45	68.94	0.0028 $A_{s,\text{min}}$	0.0028	0.2122
3-D22	2-D22	16.75	68.94	0.0042 $A_{s,\text{min}}$	0.0028	0.1854
4-D22	2-D22	22.04	68.94	0.0056 $A_{s,\text{min}}$	0.0028	0.1684
5-D22	2-D22	27.30	68.94	0.0070	0.0028	0.1564
6-D22	2-D22	32.13	68.15	0.0085	0.0028	0.1532
7-D22	2-D22	36.91	67.59	0.0100	0.0028	0.1495
8-D22	2-D22	41.60	67.17	0.0115	0.0028	0.1456
9-D22	2-D22	46.12	66.84	0.0130	0.0028	0.1419
10-D22	2-D22	50.53	66.58	0.0145	0.0028	0.1385

$A_{s,\text{min}} = 16.09 \text{ cm}^2$, $0.75\rho_s = 0.0290 (80.05 \text{ cm}^2)$
 Torsional Effect is neglected if $T_u \leq 1.16 \text{ tf-m}$

3. Resisting Shear Capacity

Stirrup	$\Phi V_n(\text{tf})$	$\Phi V_c(\text{tf})$	$\Phi V_s(\text{tf})$	$\Phi V_{\text{max}}(\text{tf})$
<d = 68.94>				
2- D10 @100	36.73	16.67	20.06	83.33
2- D10 @125	32.72	16.67	16.05	83.33
2- D10 @150	30.04	16.67	13.37	83.33
2- D10 @175	28.13	16.67	11.46	83.33
2- D10 @200	26.70	16.67	10.03	83.33
2- D10 @250	24.69	16.67	8.02	83.33
2- D10 @300	23.35	16.67	6.69	83.33
<d = 66.58>				
2- D10 @100	35.47	16.10	19.38	80.48
2- D10 @125	31.60	16.10	15.50	80.48
2- D10 @150	29.01	16.10	12.92	80.48
2- D10 @175	27.17	16.10	11.07	80.48
2- D10 @200	25.78	16.10	9.69	80.48
2- D10 @250	23.85	16.10	7.75	80.48
2- D10 @300	22.55	16.10	6.46	80.48

	Company	o	Project Name	
	Designer	o	File Name	

1. Design Conditions

Design Code : KCI-USD99 (Build.)
 Material Data : $f_{ck} = 180 \text{ kgf/cm}^2$
 : $f_y = 2400 \text{ kgf/cm}^2$ $f_{ys} = 2400 \text{ kgf/cm}^2$
 Section Dim. : 30 * 65 cm ($c_c = 4 \text{ cm}$)


2. Resisting Moment Capacity

A_s	A'_s	$\Phi M_n(\text{tf-m})$	d(cm)	ρ	ρ'	$\omega_c(\text{mm})$
2-D22	2-D22	9.57	58.94	0.0044 $A_{s,\text{min}}$	0.0044	0.1928
3-D22	2-D22	14.02	58.94	0.0066	0.0044	0.1684
4-D22	2-D22	18.44	58.94	0.0088	0.0044	0.1530
5-D22	2-D22	22.44	57.99	0.0111	0.0044	0.1491
6-D22	2-D22	26.38	57.36	0.0135	0.0044	0.1444
7-D22	2-D22	30.14	56.91	0.0159	0.0044	0.1398
8-D22	2-D22	33.72	56.58	0.0182	0.0044	0.1355

$A_{s,\text{min}} = 10.31 \text{ cm}^2$, $0.75\rho_o = 0.0290 (51.33 \text{ cm}^2)$
 Torsional Effect is neglected if $T_u \leq 0.59 \text{ tf-m}$

3. Resisting Shear Capacity

Stirrup	$\Phi V_n(\text{tf})$	$\Phi V_c(\text{tf})$	$\Phi V_s(\text{tf})$	$\Phi V_{\text{max}}(\text{tf})$
<d = 58.94>				
2- D10 @100	27.84	10.69	17.15	53.43
2- D10 @125	24.41	10.69	13.72	53.43
2- D10 @150	22.12	10.69	11.43	53.43
2- D10 @175	20.49	10.69	9.80	53.43
2- D10 @200	19.26	10.69	8.58	53.43
2- D10 @250	17.55	10.69	6.86	53.43
2- D10 @300<=MAX	16.40	10.69	5.72	53.43
<d = 56.58>				
2- D10 @100	26.72	10.26	16.47	51.29
2- D10 @125	23.43	10.26	13.17	51.29
2- D10 @150	21.24	10.26	10.98	51.29
2- D10 @175	19.67	10.26	9.41	51.29
2- D10 @200	18.49	10.26	8.23	51.29
2- D10 @250	16.84	10.26	6.59	51.29
2- D10 @300<=MAX	15.75	10.26	5.49	51.29

	Company	o	Project Name	
	Designer	o	File Name	

1. Design Conditions

Design Code : KCI-USD99 (Build.)
 Material Data : $f_{ck} = 180 \text{ kgf/cm}^2$
 : $f_y = 2400 \text{ kgf/cm}^2$ $f_{ys} = 2400 \text{ kgf/cm}^2$
 Section Dim. : 30 * 65 cm ($c_c = 4 \text{ cm}$)


2. Resisting Moment Capacity

A_s	A'_s	$\Phi M_n(\text{tf-m})$	d(cm)	ρ	ρ'	$\omega_s(\text{mm})$
2-D22	2-D22	9.57	58.94	0.0044 $A_{s,min}$	0.0044	0.1928
3-D22	2-D22	14.02	58.94	0.0066	0.0044	0.1684
4-D22	2-D22	18.05	57.76	0.0089	0.0044	0.1624
5-D22	2-D22	22.04	57.05	0.0113	0.0044	0.1555
6-D22	2-D22	25.98	56.58	0.0137	0.0044	0.1492

$A_{s,min} = 10.31 \text{ cm}^2$, $0.75\rho_s = 0.0290 (51.33 \text{ cm}^2)$
 Torsional Effect is neglected if $T_u \leq 0.59 \text{ tf-m}$

3. Resisting Shear Capacity

Stirrup	$\Phi V_n(\text{tf})$	$\Phi V_c(\text{tf})$	$\Phi V_s(\text{tf})$	$\Phi V_{max}(\text{tf})$
<d = 58.94>				
2- D10 @100	27.84	10.69	17.15	53.43
2- D10 @125	24.41	10.69	13.72	53.43
2- D10 @150	22.12	10.69	11.43	53.43
2- D10 @175	20.49	10.69	9.80	53.43
2- D10 @200	19.26	10.69	8.58	53.43
2- D10 @250	17.55	10.69	6.86	53.43
2- D10 @300<=MAX	16.40	10.69	5.72	53.43
<d = 56.58>				
2- D10 @100	26.72	10.26	16.47	51.29
2- D10 @125	23.43	10.26	13.17	51.29
2- D10 @150	21.24	10.26	10.98	51.29
2- D10 @175	19.67	10.26	9.41	51.29
2- D10 @200	18.49	10.26	8.23	51.29
2- D10 @250	16.84	10.26	6.59	51.29
2- D10 @300<=MAX	15.75	10.26	5.49	51.29

	Company	o	Project Name	
	Designer	o	File Name	

1. Design Conditions

Design Code : KCI-USD99 (Build.)

Material Data : $f_{ck} = 180 \text{ kgf/cm}^2$

: $f_y = 2400 \text{ kgf/cm}^2$

Concrete Clear Cover : 2 cm

2. Slab Thk : 120 mm

Short Direction Moment (Unit : tf-m/m)

	@ 100	@ 120	@ 150	@ 180	@ 200	@ 250	@ 300	@ 350
D10	1.38	1.16	0.94	0.79	0.71	0.57	0.48	0.41
D10+D13	1.85	1.57	1.27	1.07	0.97	0.78	0.65	0.56
D13	2.29	1.95	1.59	1.34	1.21	0.98	0.82	0.71
D13+D16	2.81	2.41	1.97	1.67	1.52	1.23	1.04	0.90
D16	3.28	2.83	2.33	1.99	1.81	1.47	1.24	1.07

Long Direction Moment

	@ 100	@ 120	@ 150	@ 180	@ 200	@ 250	@ 300	@ 350
D10	1.21	1.02	0.83	0.69	0.63	0.50	0.42	0.36
D10+D13	1.60	1.36	1.10	0.93	0.84	0.68	0.57	0.49
D13	1.94	1.66	1.36	1.15	1.04	0.84	0.71	0.61
D13+D16	2.34	2.01	1.66	1.41	1.28	1.04	0.88	0.76
D16	2.67	2.31	1.93	1.65	1.50	1.23	1.04	0.90

$\phi V_c = 5.66 \text{ tf/m}$

3. Slab Thk : 150 mm


Short Direction Moment (Unit : tf-m/m)

	@ 100	@ 120	@ 150	@ 180	@ 200	@ 250	@ 300	@ 350
D10	1.84	1.55	1.25	1.05	0.94	0.76	0.63	0.54
D10+D13	2.49	2.10	1.70	1.43	1.29	1.04	0.87	0.75
D13	3.11	2.63	2.13	1.80	1.62	1.31	1.10	0.94
D13+D16	3.87	3.28	2.68	2.26	2.05	1.65	1.39	1.20
D16	4.57	3.90	3.19	2.70	2.45	1.99	1.67	1.44

Long Direction Moment


	@ 100	@ 120	@ 150	@ 180	@ 200	@ 250	@ 300	@ 350
D10	1.67	1.41	1.13	0.95	0.86	0.69	0.58	0.50
D10+D13	2.24	1.89	1.53	1.29	1.16	0.94	0.78	0.67
D13	2.76	2.34	1.90	1.60	1.45	1.17	0.98	0.85
D13+D16	3.39	2.89	2.36	2.00	1.81	1.46	1.23	1.06
D16	3.95	3.39	2.78	2.36	2.14	1.74	1.47	1.27

$\phi V_c = 7.47 \text{ tf/m}$

	Company	o	Project Name	
	Designer	o	File Name	

1. Geometry and Materials

Design Code : KCI-USD99 (Build.)
 Material Data : $f_{ck} = 180 \text{ kgf/cm}^2$
 $f_y = 2400 \text{ kgf/cm}^2$
 Slab Span L : 2.20 m (Both End Fixed)
 Slab Depth : 150 mm ($c_c = 20 \text{ mm}$)

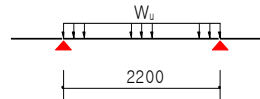

2. Applied Loads

Dead Load : $W_d = 0.74 \text{ tf/m}^2$
 Live Load : $W_l = 0.20 \text{ tf/m}^2$
 $W_u = 1.4*W_d + 1.7*W_l = 1.38 \text{ tf/m}^2$

3. Check Minimum Slab Thk.

$h_{min} = L/28 = 79 \text{ mm}$
 $h = h_{min} * (0.43 + f_y/7000) = 61 \text{ mm}$
 Thk = 150 > Req'd Thk = 61 mm O.K.


4. Reinforcement

Strength Reduction Factor $\Phi = 0.900$

	Short Span			Minimum Ratio ($\omega_c < 0.4$)
	Cont.	Cent.	DisCon	
M_u (tf-m/m)	0.55 ($W_u L^2/12$)	0.42 ($W_u L^2/16$)	0.00	
ρ (%)	0.164	0.122	0.000	0.200
A_{st} (cm^2/m)	2.07	1.54	0.00	3.00
D6	@ 150	@ 200	@ 400	@ 100
D6+D10	@ 240	@ 330	@ 400	@ 170
D10	@ 340	@ 400	@ 400	@ 230
D10+D13	@ 400	@ 400	@ 400	@ 330


5. Check Shear Stresses

Strength Reduction Factor $\Phi = 0.850$
 $V_{uk} = 1.51 < \Phi V_c = 7.62 \text{ tf/m}$ O.K.

	Company	o	Project Name	
	Designer	o	File Name	

1. Geometry and Materials

Design Code : KCI-USD99 (Build.)
 Material Data : $f_{ck} = 180 \text{ kgf/cm}^2$
 $f_y = 2400 \text{ kgf/cm}^2$
 Slab Span L : 2.20 m (Both End Fixed)
 Slab Depth : 150 mm ($c_c = 20 \text{ mm}$)

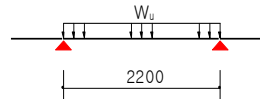

2. Applied Loads

Dead Load : $W_d = 0.94 \text{ tf/m}^2$
 Live Load : $W_l = 0.20 \text{ tf/m}^2$
 $W_u = 1.4 \cdot W_d + 1.7 \cdot W_l = 1.66 \text{ tf/m}^2$

3. Check Minimum Slab Thk.

$h_{min} = L/28 = 79 \text{ mm}$
 $h = h_{min} \cdot (0.43 + f_y/7000) = 61 \text{ mm}$
 Thk = 150 > Req'd Thk = 61 mm O.K.


4. Reinforcement

Strength Reduction Factor $\Phi = 0.900$

	Short Span			Minimum Ratio ($\omega_c < 0.4$)
	Cont.	Cent.	DisCon	
M_u (tf-m/m)	0.67 ($W_u L^2/12$)	0.50 ($W_u L^2/16$)	0.00	
ρ (%)	0.198	0.148	0.000	0.200
A_{st} (cm^2/m)	2.49	1.86	0.00	3.00
D6	@ 120	@ 170	@ 400	@ 100
D6+D10	@ 200	@ 270	@ 400	@ 170
D10	@ 280	@ 380	@ 400	@ 230
D10+D13	@ 390	@ 400	@ 400	@ 330


5. Check Shear Stresses

Strength Reduction Factor $\Phi = 0.850$
 $V_{uk} = 1.82 < \Phi V_c = 7.62 \text{ tf/m}$ O.K.

	Company	o	Project Name	
	Designer	o	File Name	

1. Geometry and Materials

Design Code : KCI-USD99 (Build.)
 Material Data : $f_{ck} = 180 \text{ kgf/cm}^2$
 $f_y = 2400 \text{ kgf/cm}^2$
 Slab Span L : 2.20 m (Both End Fixed)
 Slab Depth : 150 mm ($c_c = 20 \text{ mm}$)

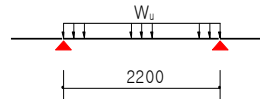

2. Applied Loads

Dead Load : $W_d = 1.04 \text{ tf/m}^2$
 Live Load : $W_l = 0.20 \text{ tf/m}^2$
 $W_u = 1.4 \cdot W_d + 1.7 \cdot W_l = 1.80 \text{ tf/m}^2$

3. Check Minimum Slab Thk.

$h_{min} = L/28 = 79 \text{ mm}$
 $h = h_{min} \cdot (0.43 + f_y/7000) = 61 \text{ mm}$
 Thk = 150 > Req'd Thk = 61 mm O.K.


4. Reinforcement

Strength Reduction Factor $\Phi = 0.900$

	Short Span			Minimum Ratio ($\omega_c < 0.4$)
	Cont.	Cent.	DisCon	
M_u (tf-m/m)	0.72 ($W_u L^2/12$)	0.54 ($W_u L^2/16$)	0.00	
ρ (%)	0.215	0.160	0.000	0.200
A_{st} (cm ² /m)	2.71	2.02	0.00	3.00
D6	@ 110	@ 150	@ 400	@ 100
D6+D10	@ 190	@ 250	@ 400	@ 170
D10	@ 260	@ 350	@ 400	@ 230
D10+D13	@ 360	@ 400	@ 400	@ 330


5. Check Shear Stresses

Strength Reduction Factor $\Phi = 0.850$
 $V_{uk} = 1.98 < \Phi V_c = 7.62 \text{ tf/m}$ O.K.

	Company	o	Project Name	
	Designer	o	File Name	

1. Geometry and Materials

Design Code : KCI-USD99 (Build.)
 Material Data : $f_{ck} = 180 \text{ kgf/cm}^2$
 $f_y = 2400 \text{ kgf/cm}^2$
 Slab Span L : 1.70 m (Both End Fixed)
 Slab Depth : 120 mm ($c_c = 20 \text{ mm}$)

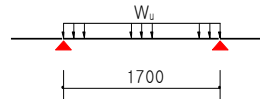

2. Applied Loads

Dead Load : $W_d = 0.67 \text{ tf/m}^2$
 Live Load : $W_l = 0.20 \text{ tf/m}^2$
 $W_u = 1.4*W_d + 1.7*W_l = 1.28 \text{ tf/m}^2$

3. Check Minimum Slab Thk.

$h_{min} = L/28 = 61 \text{ mm}$
 $h = h_{min} * (0.43 + f_y/7000) = 47 \text{ mm}$
 Thk = 120 > Req'd Thk = 47 mm O.K.


4. Reinforcement

Strength Reduction Factor $\Phi = 0.900$

	Short Span			Minimum Ratio ($\omega_c < 0.4$)
	Cont.	Cent.	DisCon	
M_u (tf-m/m)	0.31 ($W_u L^2/12$)	0.23 ($W_u L^2/16$)	0.00	
ρ (%)	0.156	0.117	0.000	0.200
A_{st} (cm^2/m)	1.50	1.12	0.00	2.40
D6	@ 210	@ 280	@ 400	@ 130
D6+D10	@ 340	@ 400	@ 400	@ 210
D10	@ 400	@ 400	@ 400	@ 290
D10+D13	@ 400	@ 400	@ 400	@ 400


5. Check Shear Stresses

Strength Reduction Factor $\Phi = 0.850$
 $V_{uk} = 1.09 < \Phi V_c = 5.80 \text{ tf/m}$ O.K.

	Company	o	Project Name	
	Designer	o	File Name	

1. Geometry and Materials

Design Code : KCI-USD99 (Build.)
 Material Data : $f_{ck} = 180 \text{ kgf/cm}^2$
 $f_y = 2400 \text{ kgf/cm}^2$
 Slab Span L : 1.70 m (Both End Fixed)
 Slab Depth : 120 mm ($c_c = 20 \text{ mm}$)

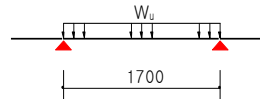

2. Applied Loads

Dead Load : $W_d = 0.87 \text{ tf/m}^2$
 Live Load : $W_l = 0.20 \text{ tf/m}^2$
 $W_u = 1.4*W_d + 1.7*W_l = 1.56 \text{ tf/m}^2$

3. Check Minimum Slab Thk.

$h_{min} = L/28 = 61 \text{ mm}$
 $h = h_{min} * (0.43 + f_y/7000) = 47 \text{ mm}$
 Thk = 120 > Req'd Thk = 47 mm O.K.

4. Reinforcement


Strength Reduction Factor $\Phi = 0.900$

	Short Span			Minimum Ratio ($\omega_c < 0.4$)
	Cont.	Cent.	DisCon	
M_u (tf-m/m)	0.38 ($W_u L^2/12$)	0.28 ($W_u L^2/16$)	0.00	
ρ (%)	0.191	0.143	0.000	0.200
A_{st} (cm ² /m)	1.84	1.37	0.00	2.40
D6	@ 170	@ 230	@ 400	@ 130
D6+D10	@ 280	@ 370	@ 400	@ 210
D10	@ 380	@ 400	@ 400	@ 290
D10+D13	@ 400	@ 400	@ 400	@ 400


5. Check Shear Stresses

Strength Reduction Factor $\Phi = 0.850$
 $V_{uk} = 1.32 < \Phi V_c = 5.80 \text{ tf/m}$ O.K.

부록 6. 보강 위치도

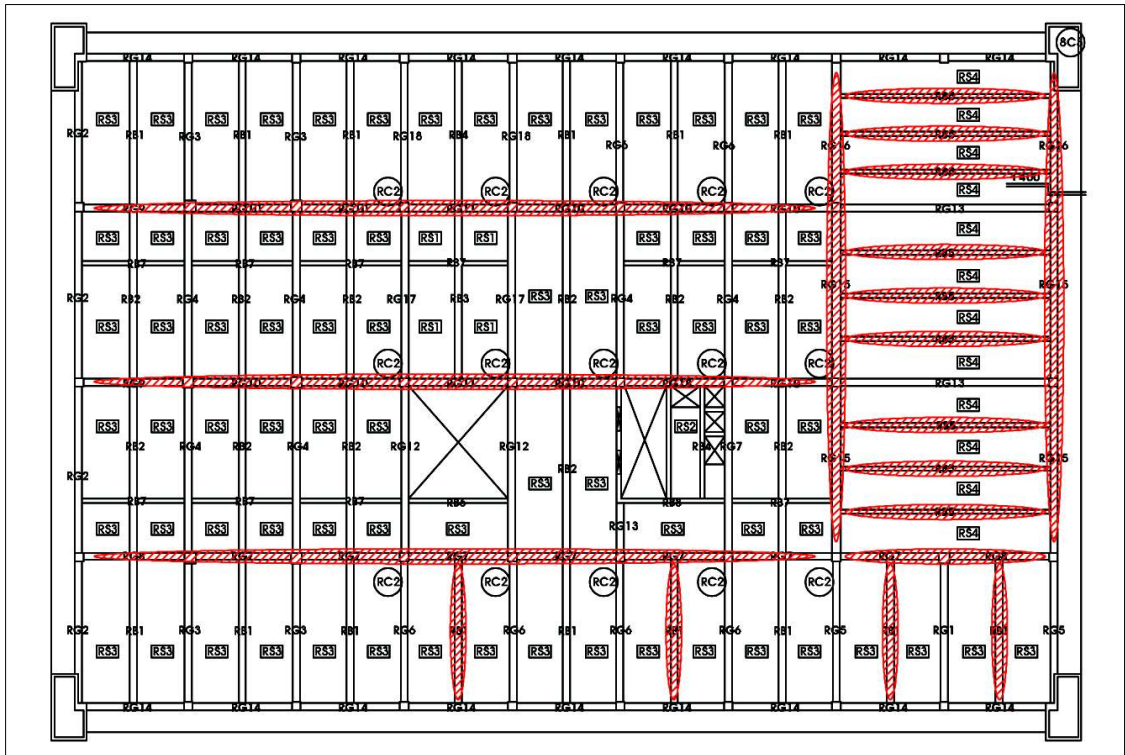

[그림 6] 지붕층 바닥 보 보강위치도

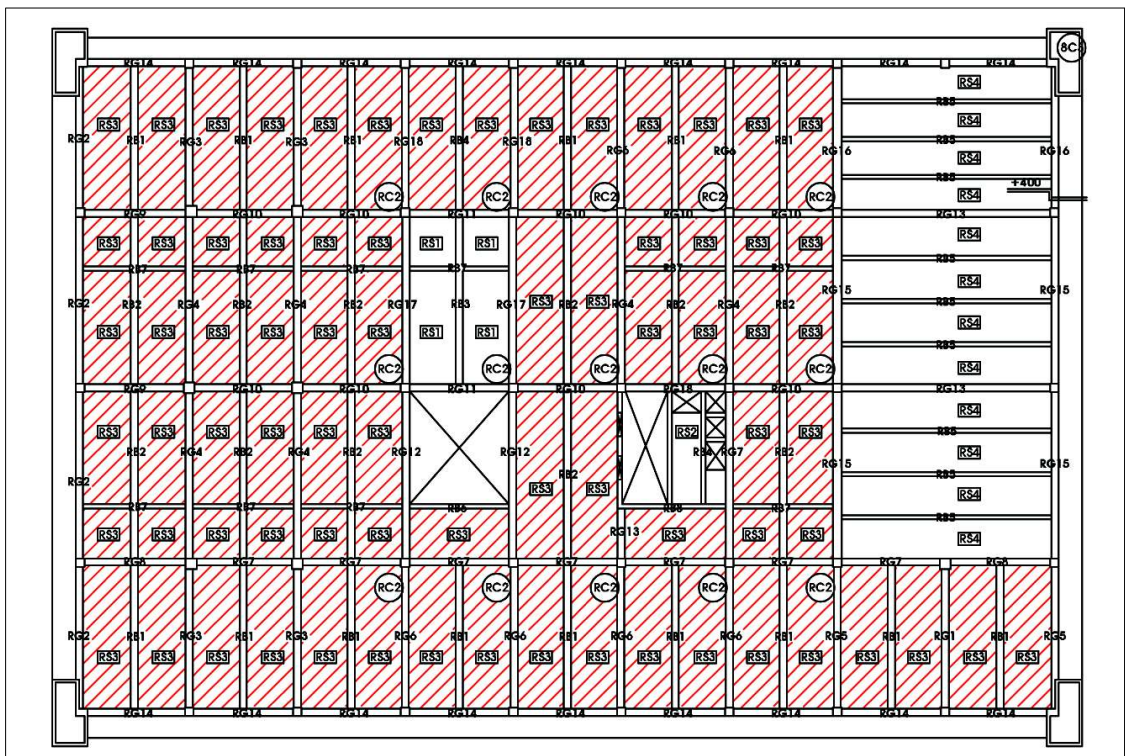

[그림 7] 지붕층 바닥 슬래브 보강위치도

부록 7. 건축물 대장