



# 성동교차로 사거리 (현황+개선)

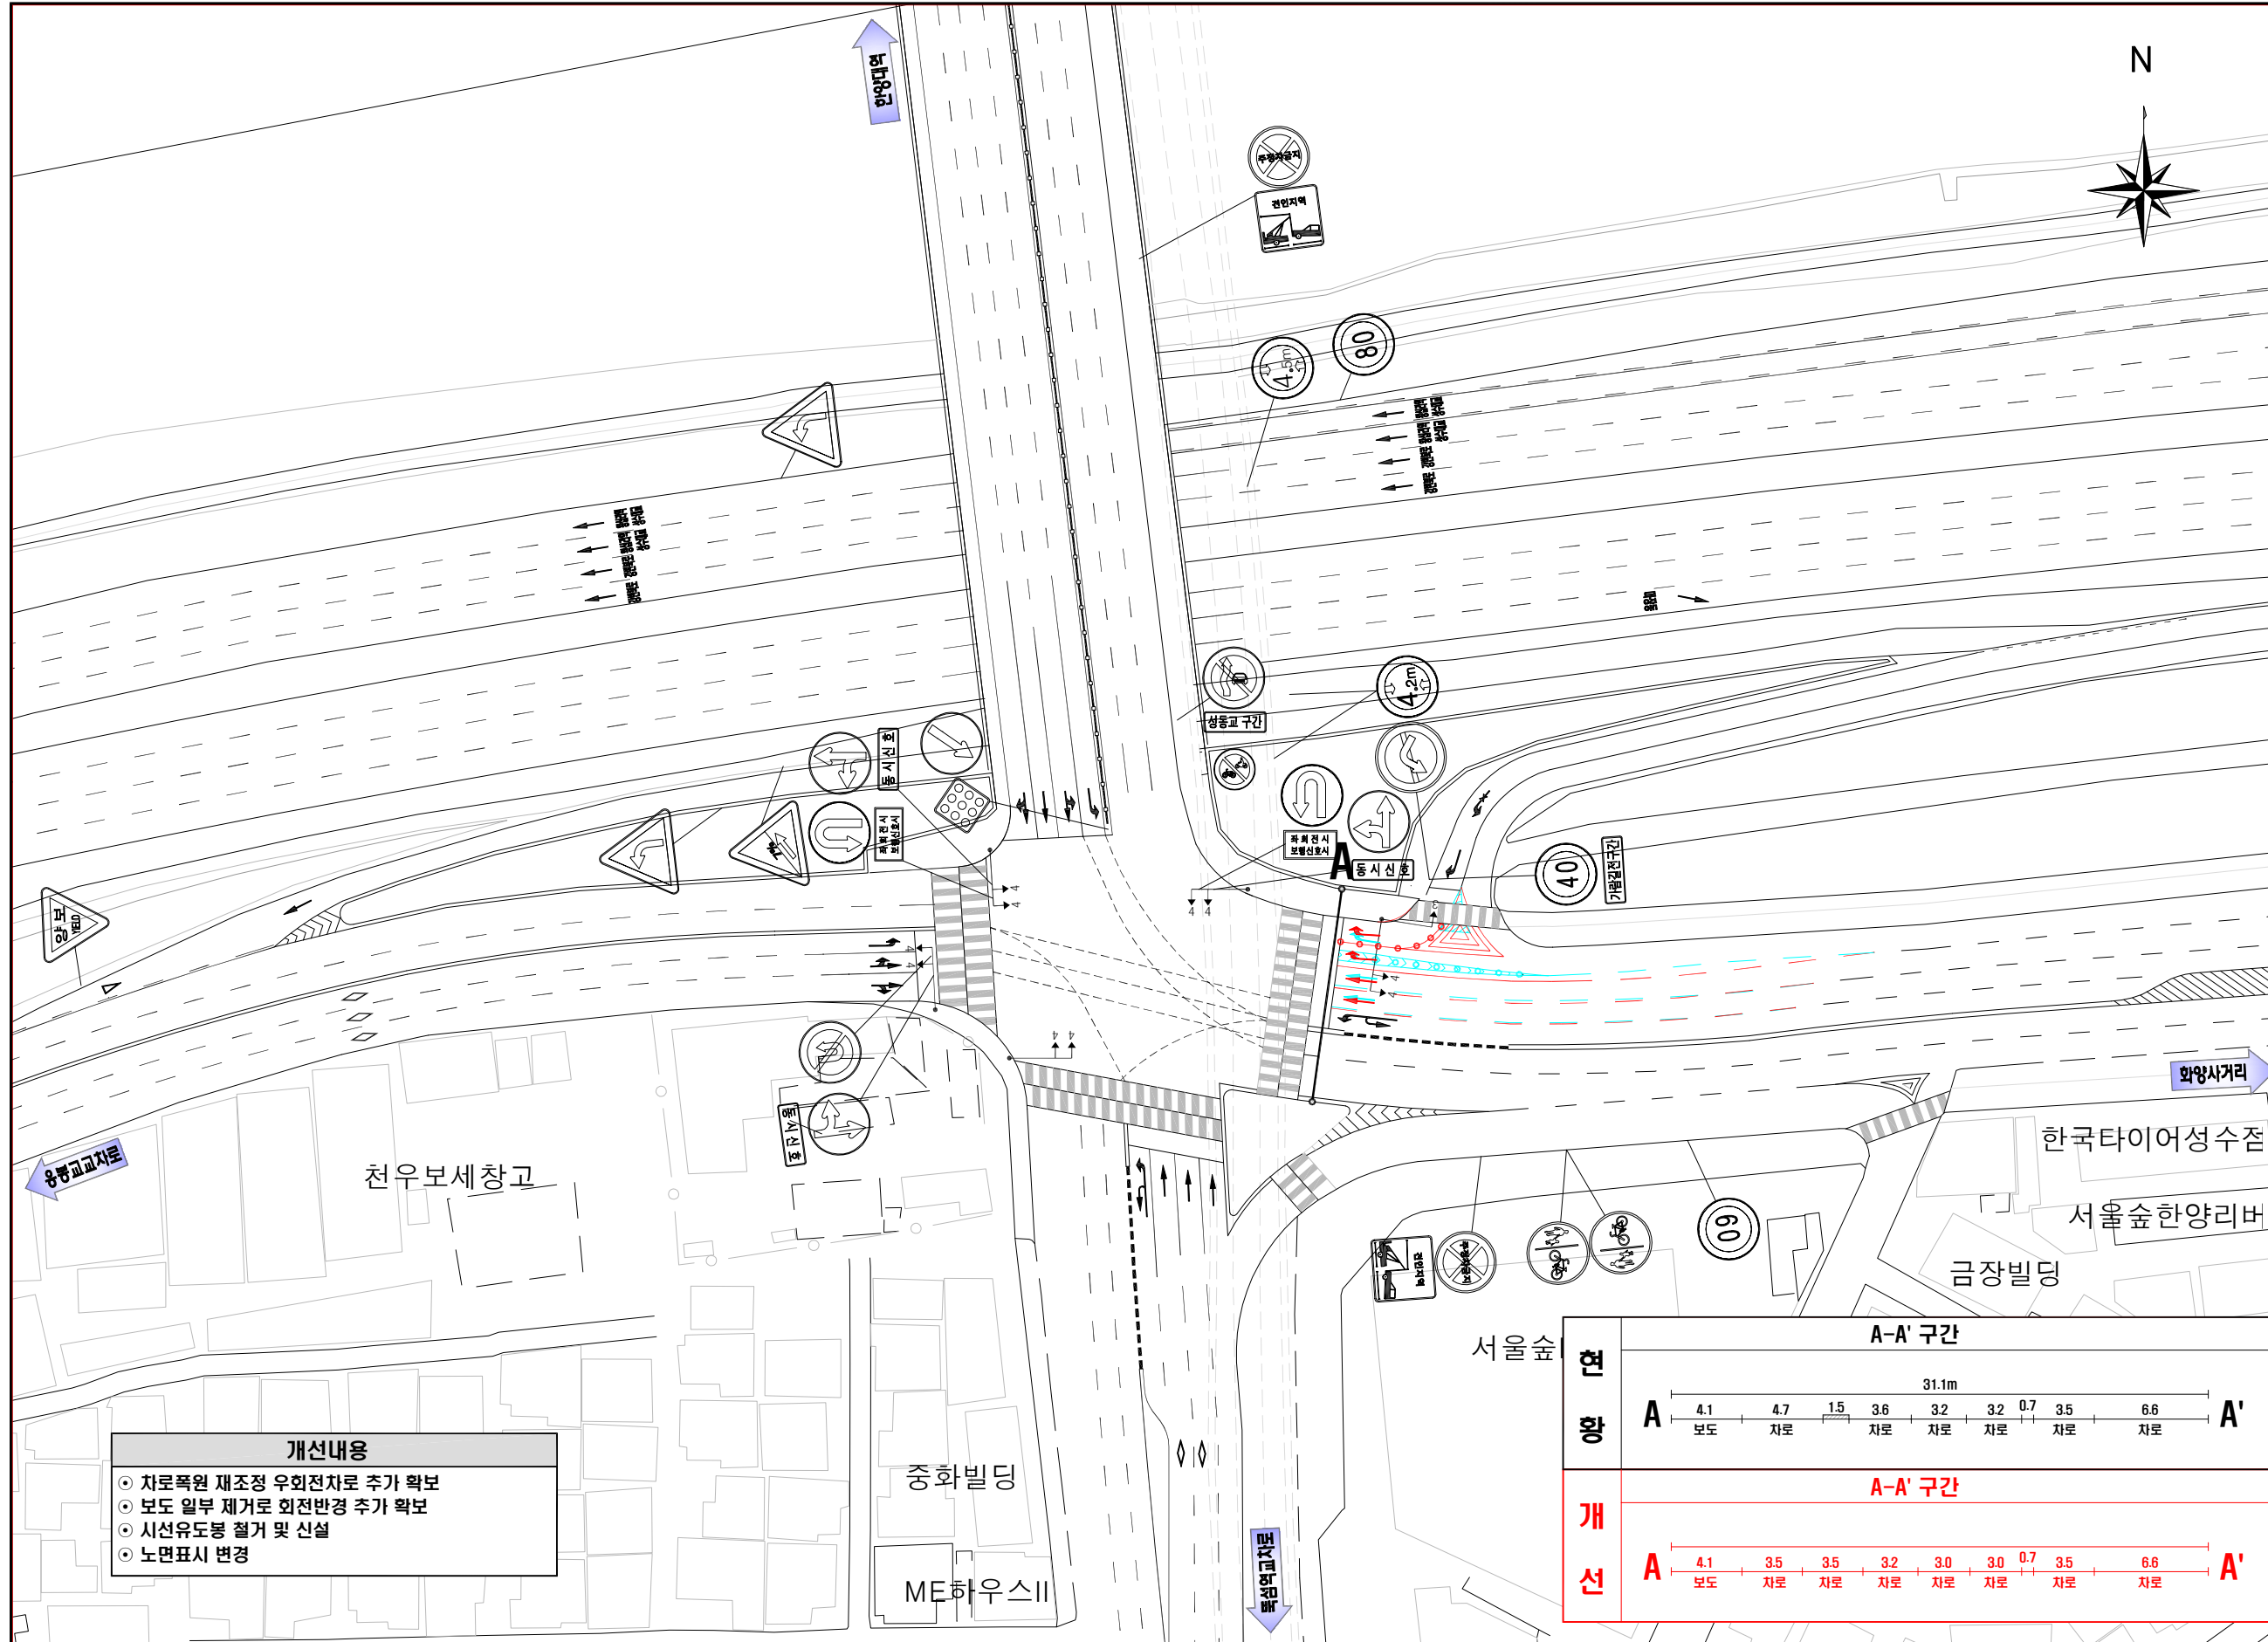


- 개선내용**
- 차로폭원 재조정 우회전차로 추가 확보
  - 보도 일부 제거로 회전반경 추가 확보
  - 시선유도봉 철거 및 신설
  - 노면표시 변경

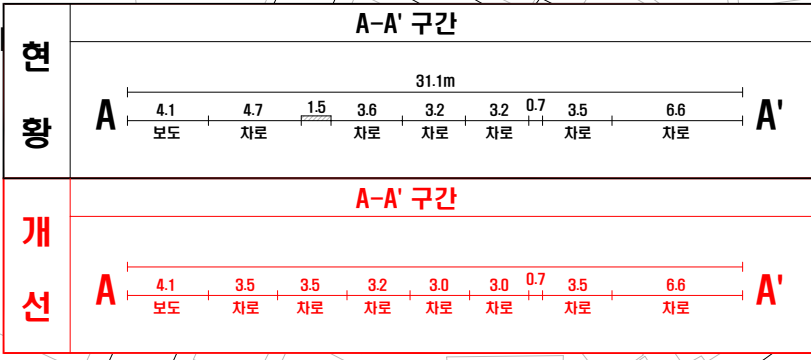

## KEYMAP



## [교통량(차량)]

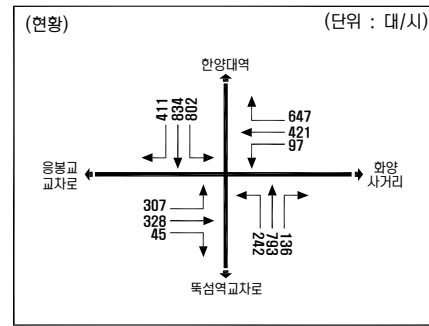

구분	φ1	φ2	φ3	φ4	φ5	주기
현황	41(3)	58(3)	29(3)	40(3)	-	180초

※ 오우점두시(18:00~19:00시)기준

구분	평균제어지체(초/대)	서비스수준
현황	72.6	E
개선	62.3	D
증감	▼10.3	-

※ 오우점두시(18:00~19:00시)기준

