


【 첨부 1 】 상세 노선 변경도(1120, 1144번)

○ 시내버스 1120, 1144번 변경 노선도(안)

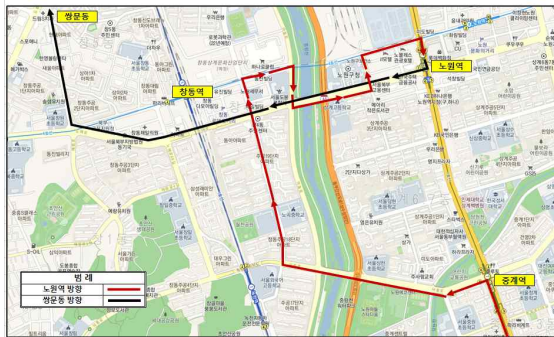

차고지→회차지 방면 운행시



회차지→차고지 방면 운행시