


위치도 및 현황사진

□ 위치도

- **당초** : 동작대로 198(방배동 765-27) 앞
- **변경** : 동작대로 194(방배동 782-1) 앞

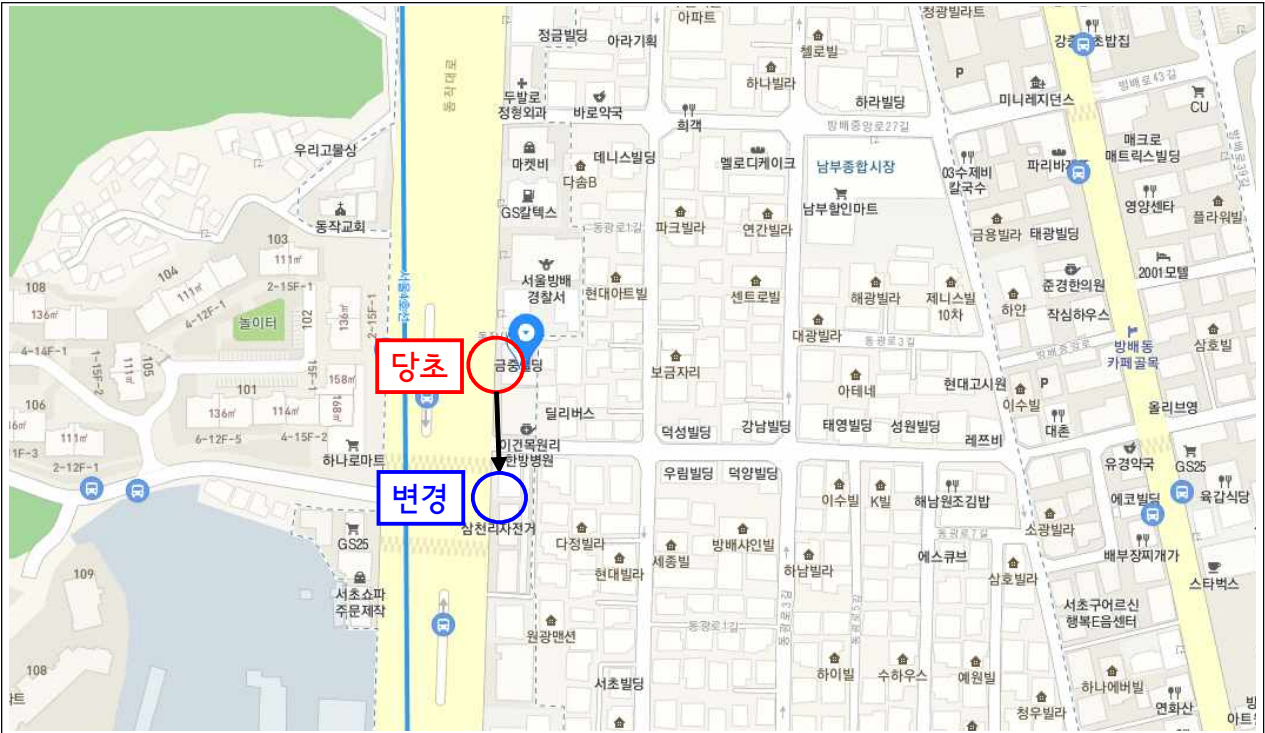

□ 당초 현황사진



□ 변경 현황사진

