


노을캠핑장 면정비 전기공사

2019.12


서부공원녹지사업소

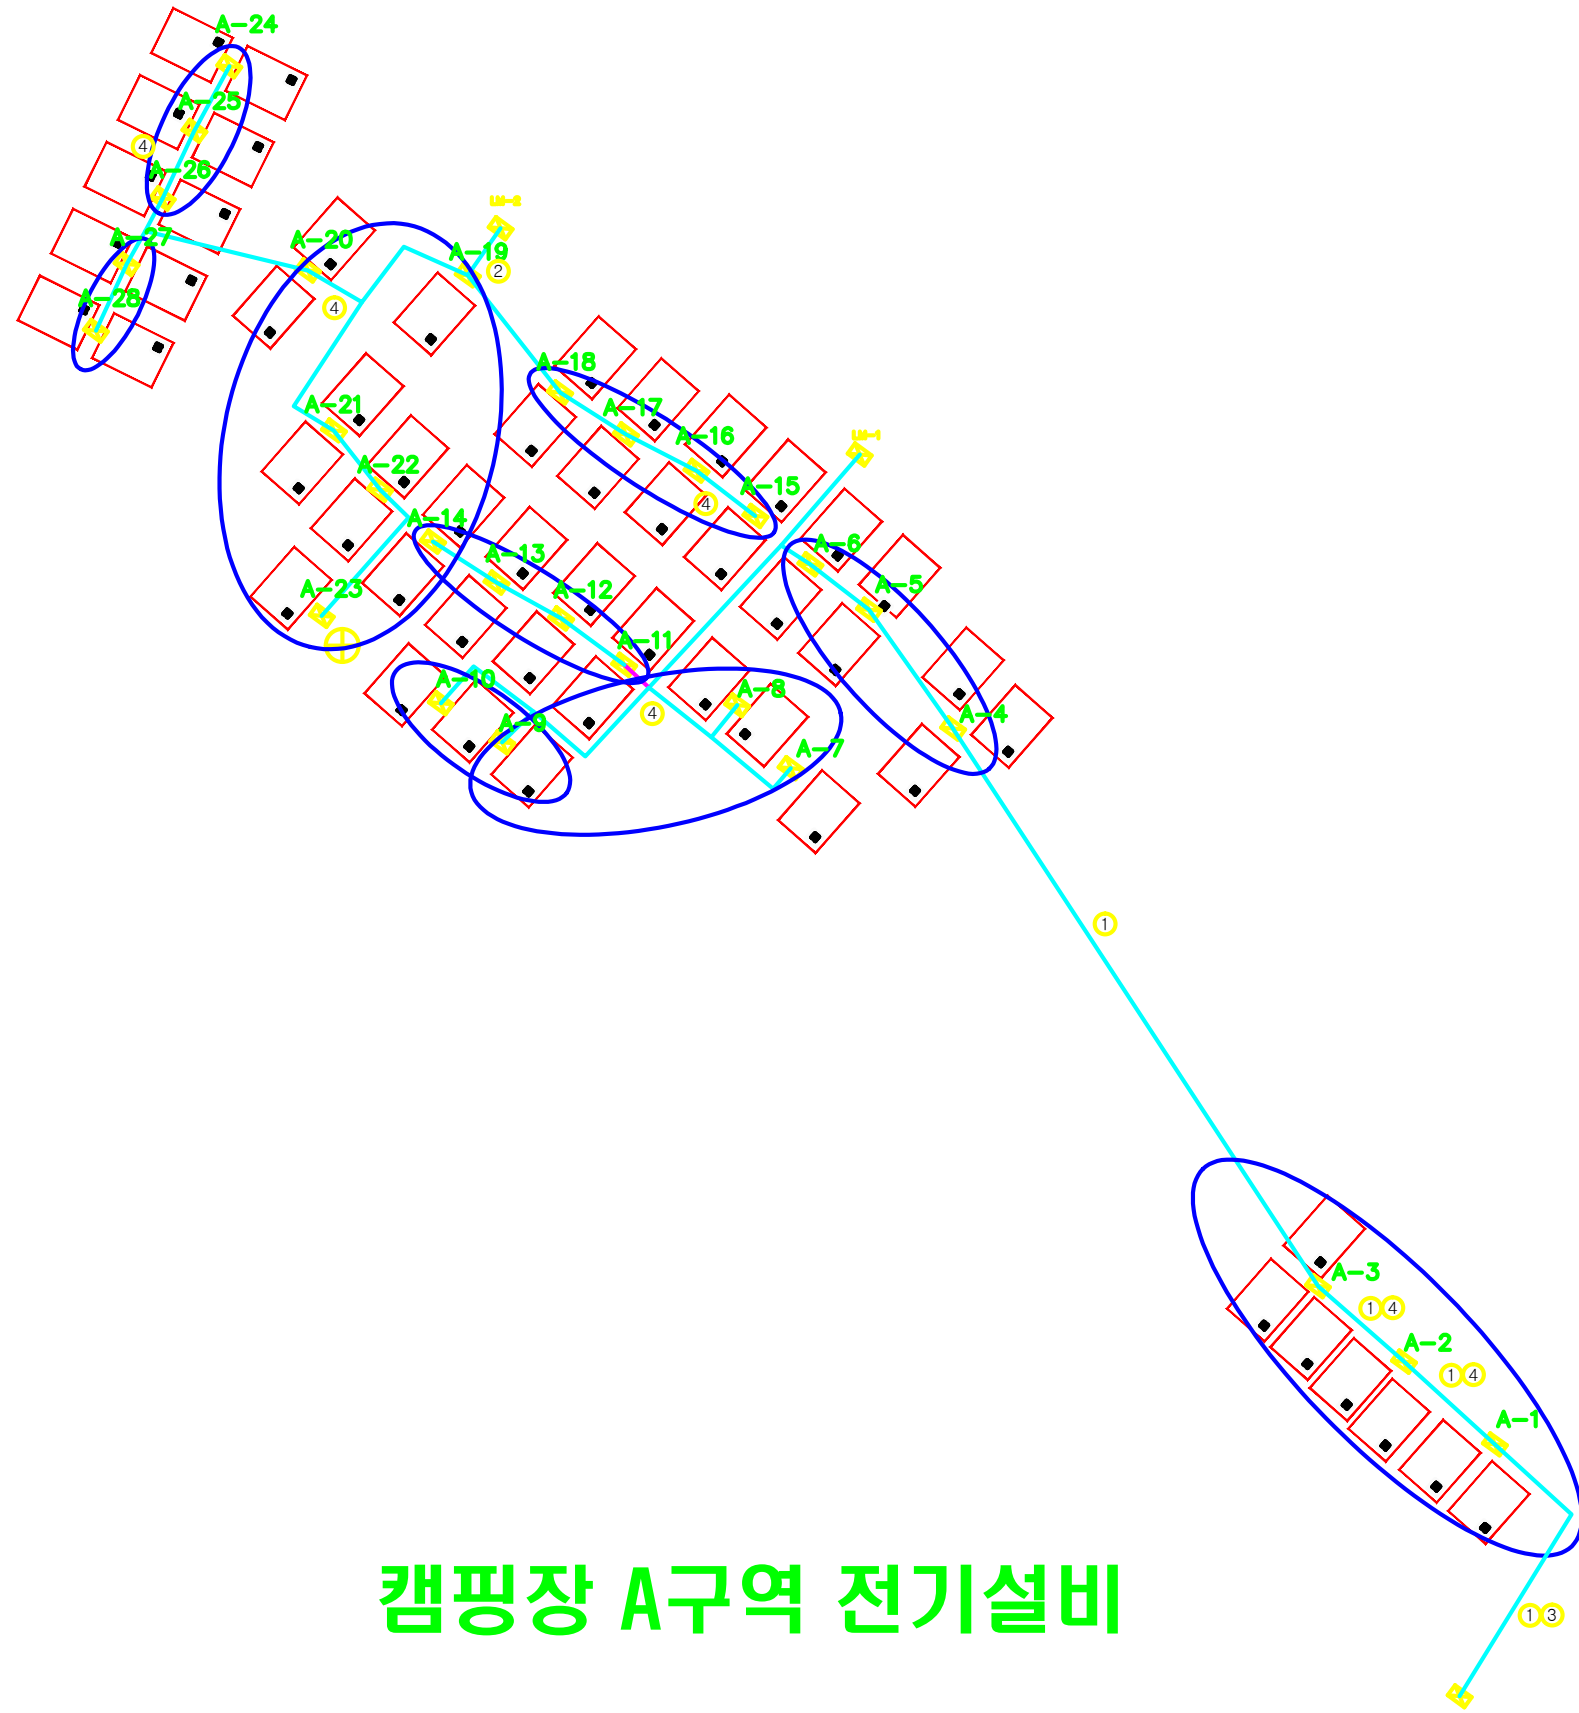

캠핑장 A구역 전기설비

CABLE SCHEDULE	
규격	
①	0.6/1kV F-CV 25sq/2Cx2, E-16sq(ELP50Cx2)
②	0.6/1kV F-CV 25sq/2Cx1, E-16sq(ELP50C)
③	0.6/1kV F-CV 10sq/2Cx1, E-6sq(ELP40C)
④	0.6/1kV F-CV 6sq/2Cx1, E-6sq(ELP30C)
간이분전반. 28EA	

REV.	DATE	DESCRIPTION
△		
△		
△		
PROJECT TITLE		
DRAWING TITLE		
CHECKED BY/ DATE	APPROVED BY/ DATE	
PROJECT ARCHITECT	PROJECT MANAGER	
ENGINEER	DRAWN BY/ DATE	
SCALE		
A1 :		A3 :
DRAWING NO.	REV. 0	

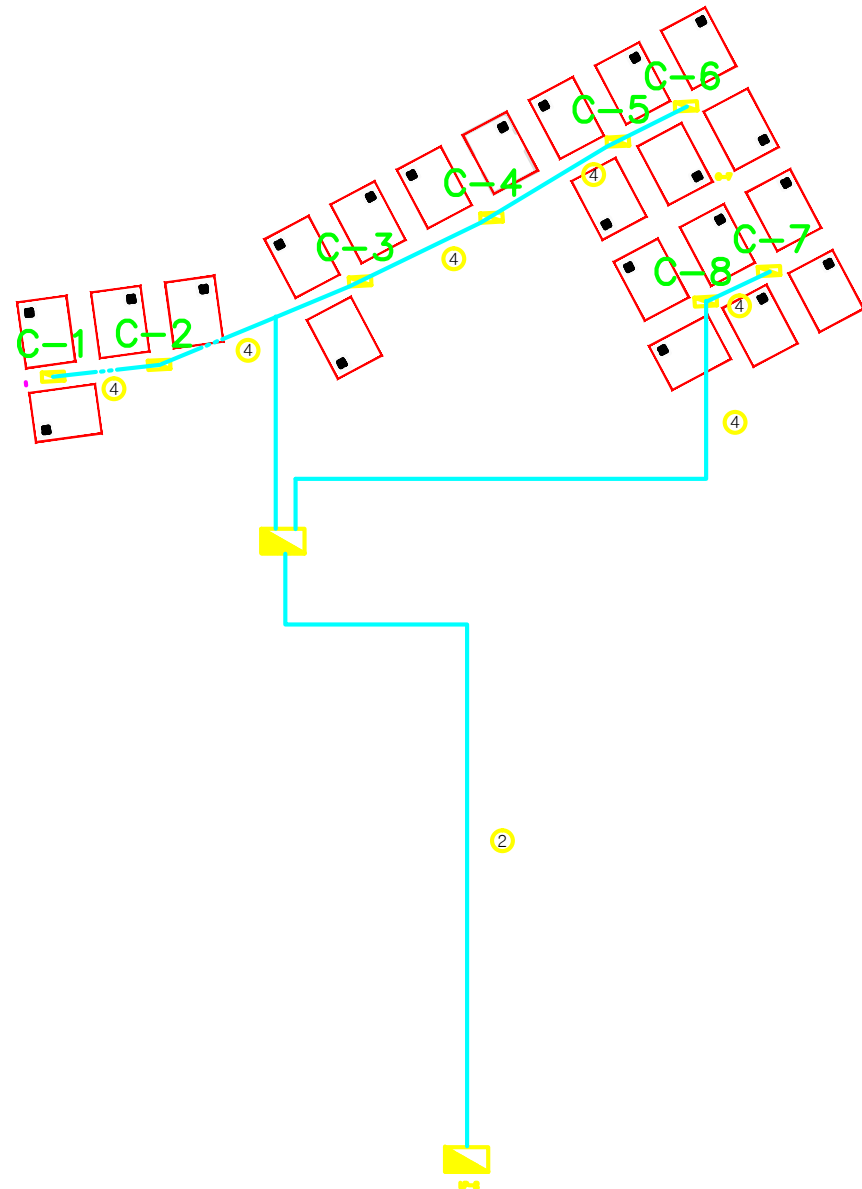

캠핑장 C구역 전기설비

CABLE SCHEDULE

규격	
①	0.6/1kV F-CV 25sq/2Cx2, E-16sq(ELP50Cx2)
②	0.6/1kV F-CV 25sq/2Cx1, E-16sq(ELP50C)
③	0.6/1kV F-CV 10sq/2Cx1, E-6sq(ELP40C)
④	0.6/1kV F-CV 6sq/2Cx1, E-6sq(ELP30C)
간이분전반. 8EA	

NOTES

REV.	DATE	DESCRIPTION	DRN	CHK	APP
△1					
△2					
△3					

PROJECT TITLE

DRAWING TITLE

CHECKED BY/ DATE

APPROVED BY/ DATE

PROJECT ARCHITECT

PROJECT MANAGER

ENGINEER

DRAWN BY/ DATE

SCALE


A1 :

A3 :

DRAWING NO.

REV.

0

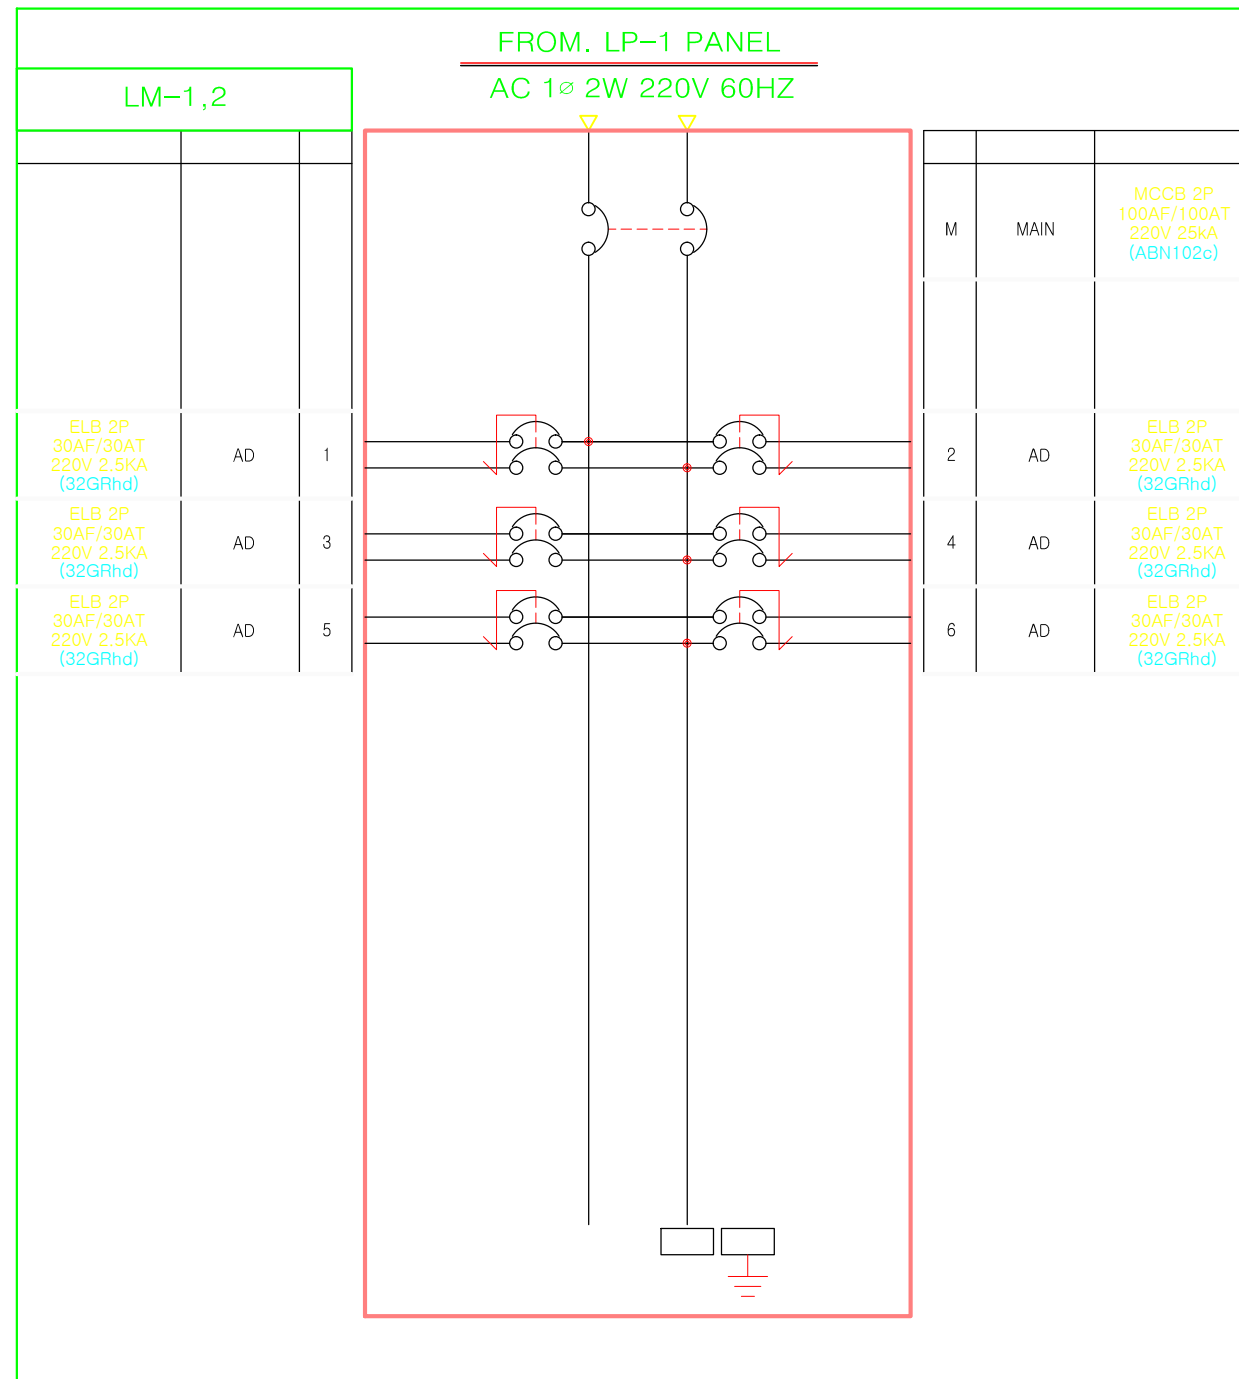


간이 분전반 상세도 -1


- N O T E -

1. 설치형식 : 옥외노출 방수 자립형
2. DOOR MAT'L : 1.2t SUS PLATE
3. BOX MAT'L : 1.2t STEEL PLATE
4. 속판 MAT'L : 1.6t STEEL PLATE
5. P-COVER MAT'L : 폴리카보네이트
6. PANEL COLOR : 헤어라인


REV.	DATE	DESCRIPTION
1		
2		
3		
PROJECT TITLE		
DRAWING TITLE		
CHECKED BY/ DATE	APPROVED BY/ DATE	
PROJECT ARCHITECT	PROJECT MANAGER	
ENGINEER	DRAWN BY/ DATE	
SCALE		
A1 :		A3 :
DRAWING NO.		

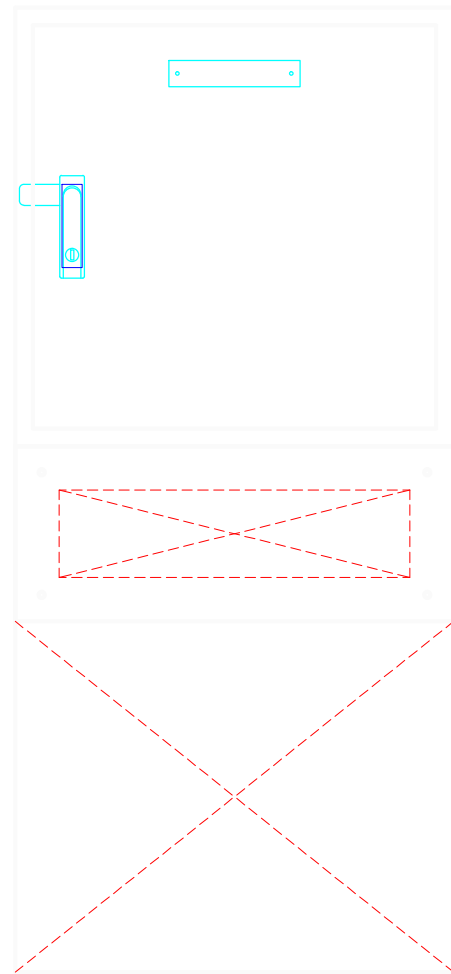

FRONT VIEW

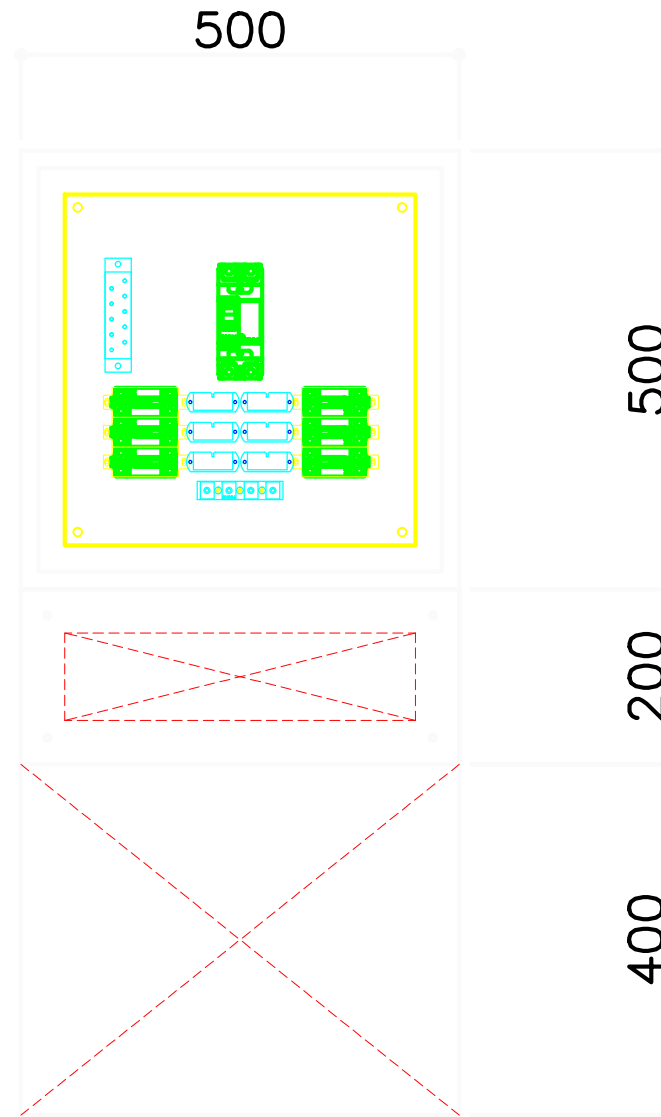

INNER VIEW

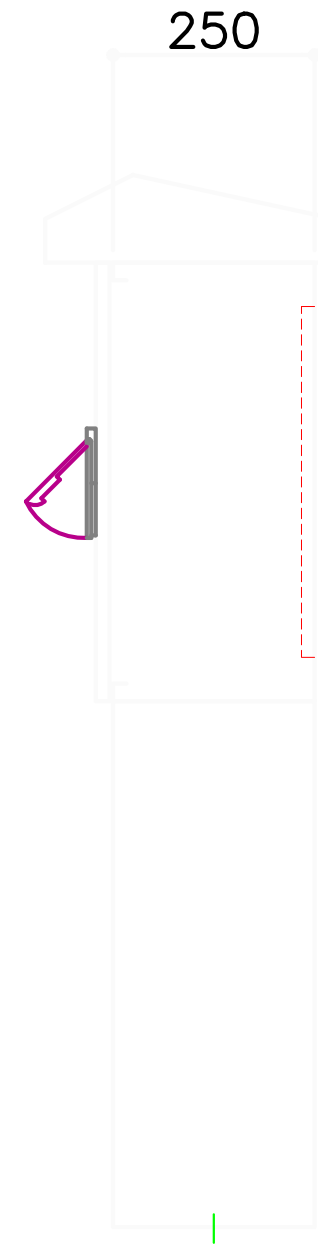

SIDE VIEW

간이 분전반 상세도 -2

REV.	DATE	DESCRIPTION
△		
△		
△		
PROJECT TITLE		
DRAWING TITLE		
CHECKED BY/ DATE	APPROVED BY/ DATE	
PROJECT ARCHITECT	PROJECT MANAGER	
ENGINEER	DRAWN BY/ DATE	
SCALE		
A1 :		A3 :
DRAWING NO.		