


평면도(북측 2구역) (변경)

SCALE (A1) 1:800
(A3) 1:1600

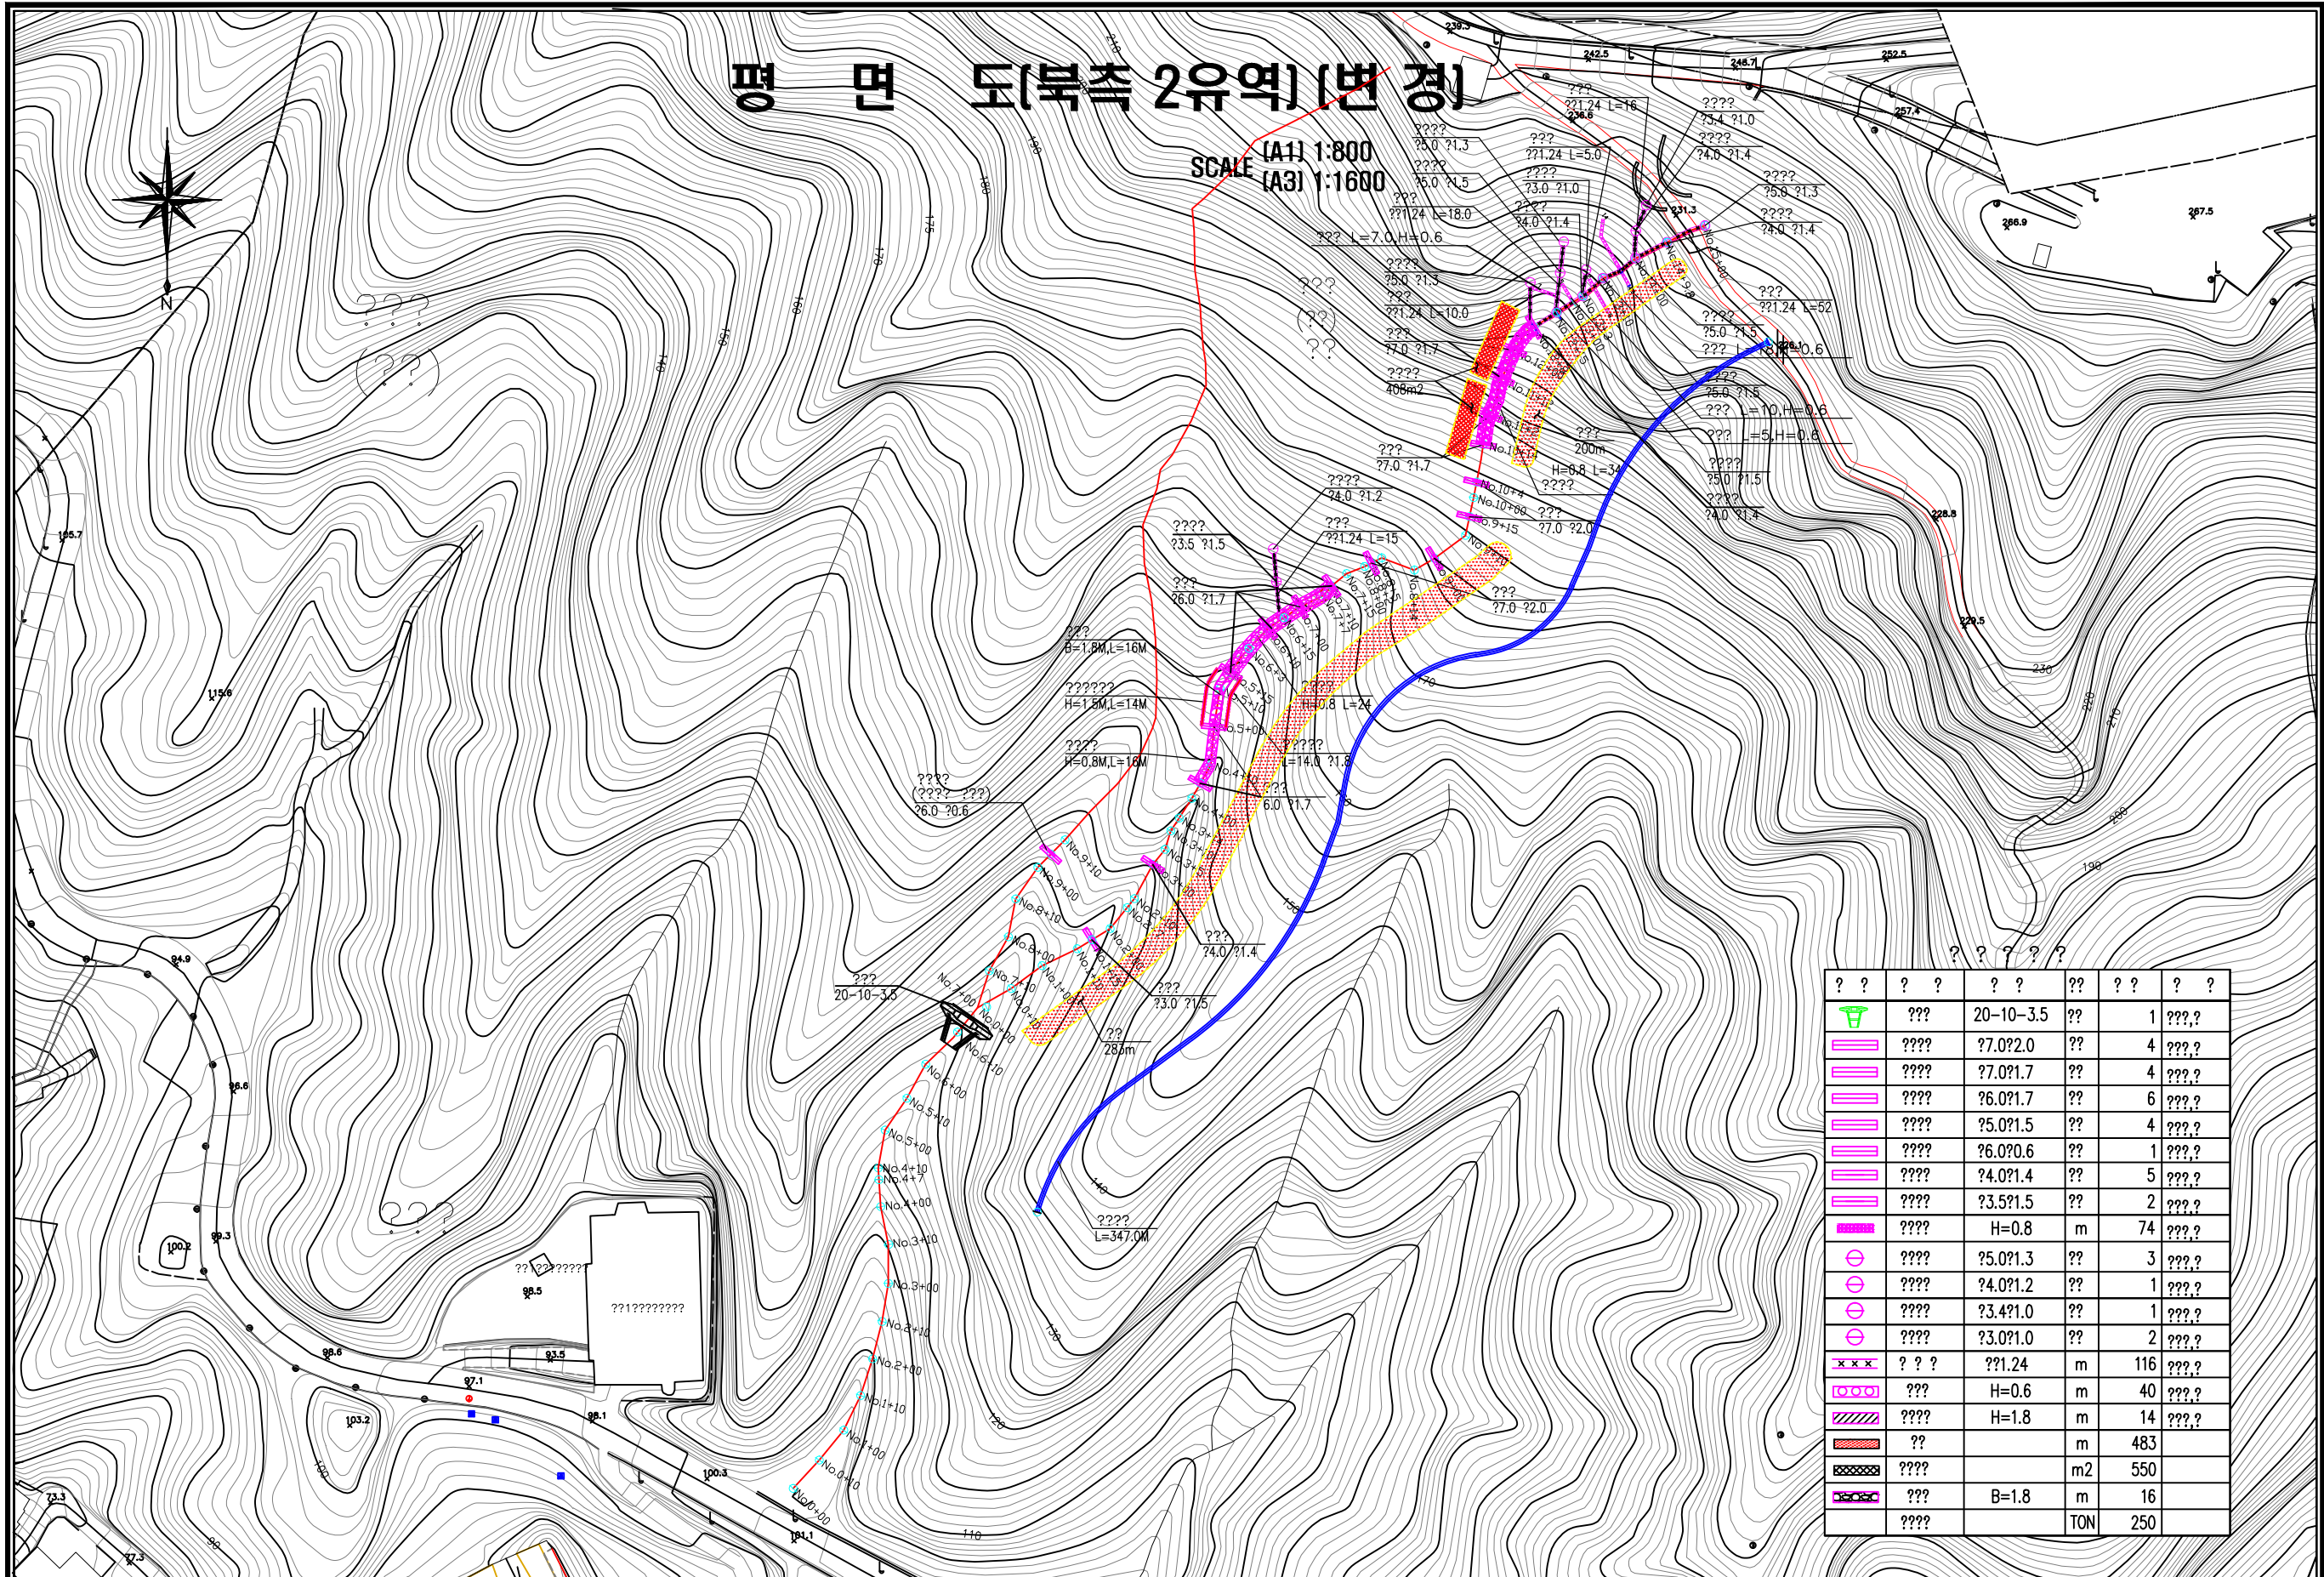


발주처 중부공원녹지사업소	설계자 찬동산림기술사사무소 포항시 북구 장성동 1387-5번지	설계 DESIGNED BY	심사 CHECKED BY	책임기술자 CHIEF ENGR ???????	승인 APPROVED BY	도면구분 SERIAL NO.	공사명 PROJECT 2013년도 예방사방사업
		제도 DRAWN BY	축척 SCALE	일자 DATE 2012.06.	일자 DATE	도면번호 SHEET NO. 2	도면명 TITLE ? ? (? ? 2?) (?)