


# 대명초등학교(현황+개선)

KEYMAP

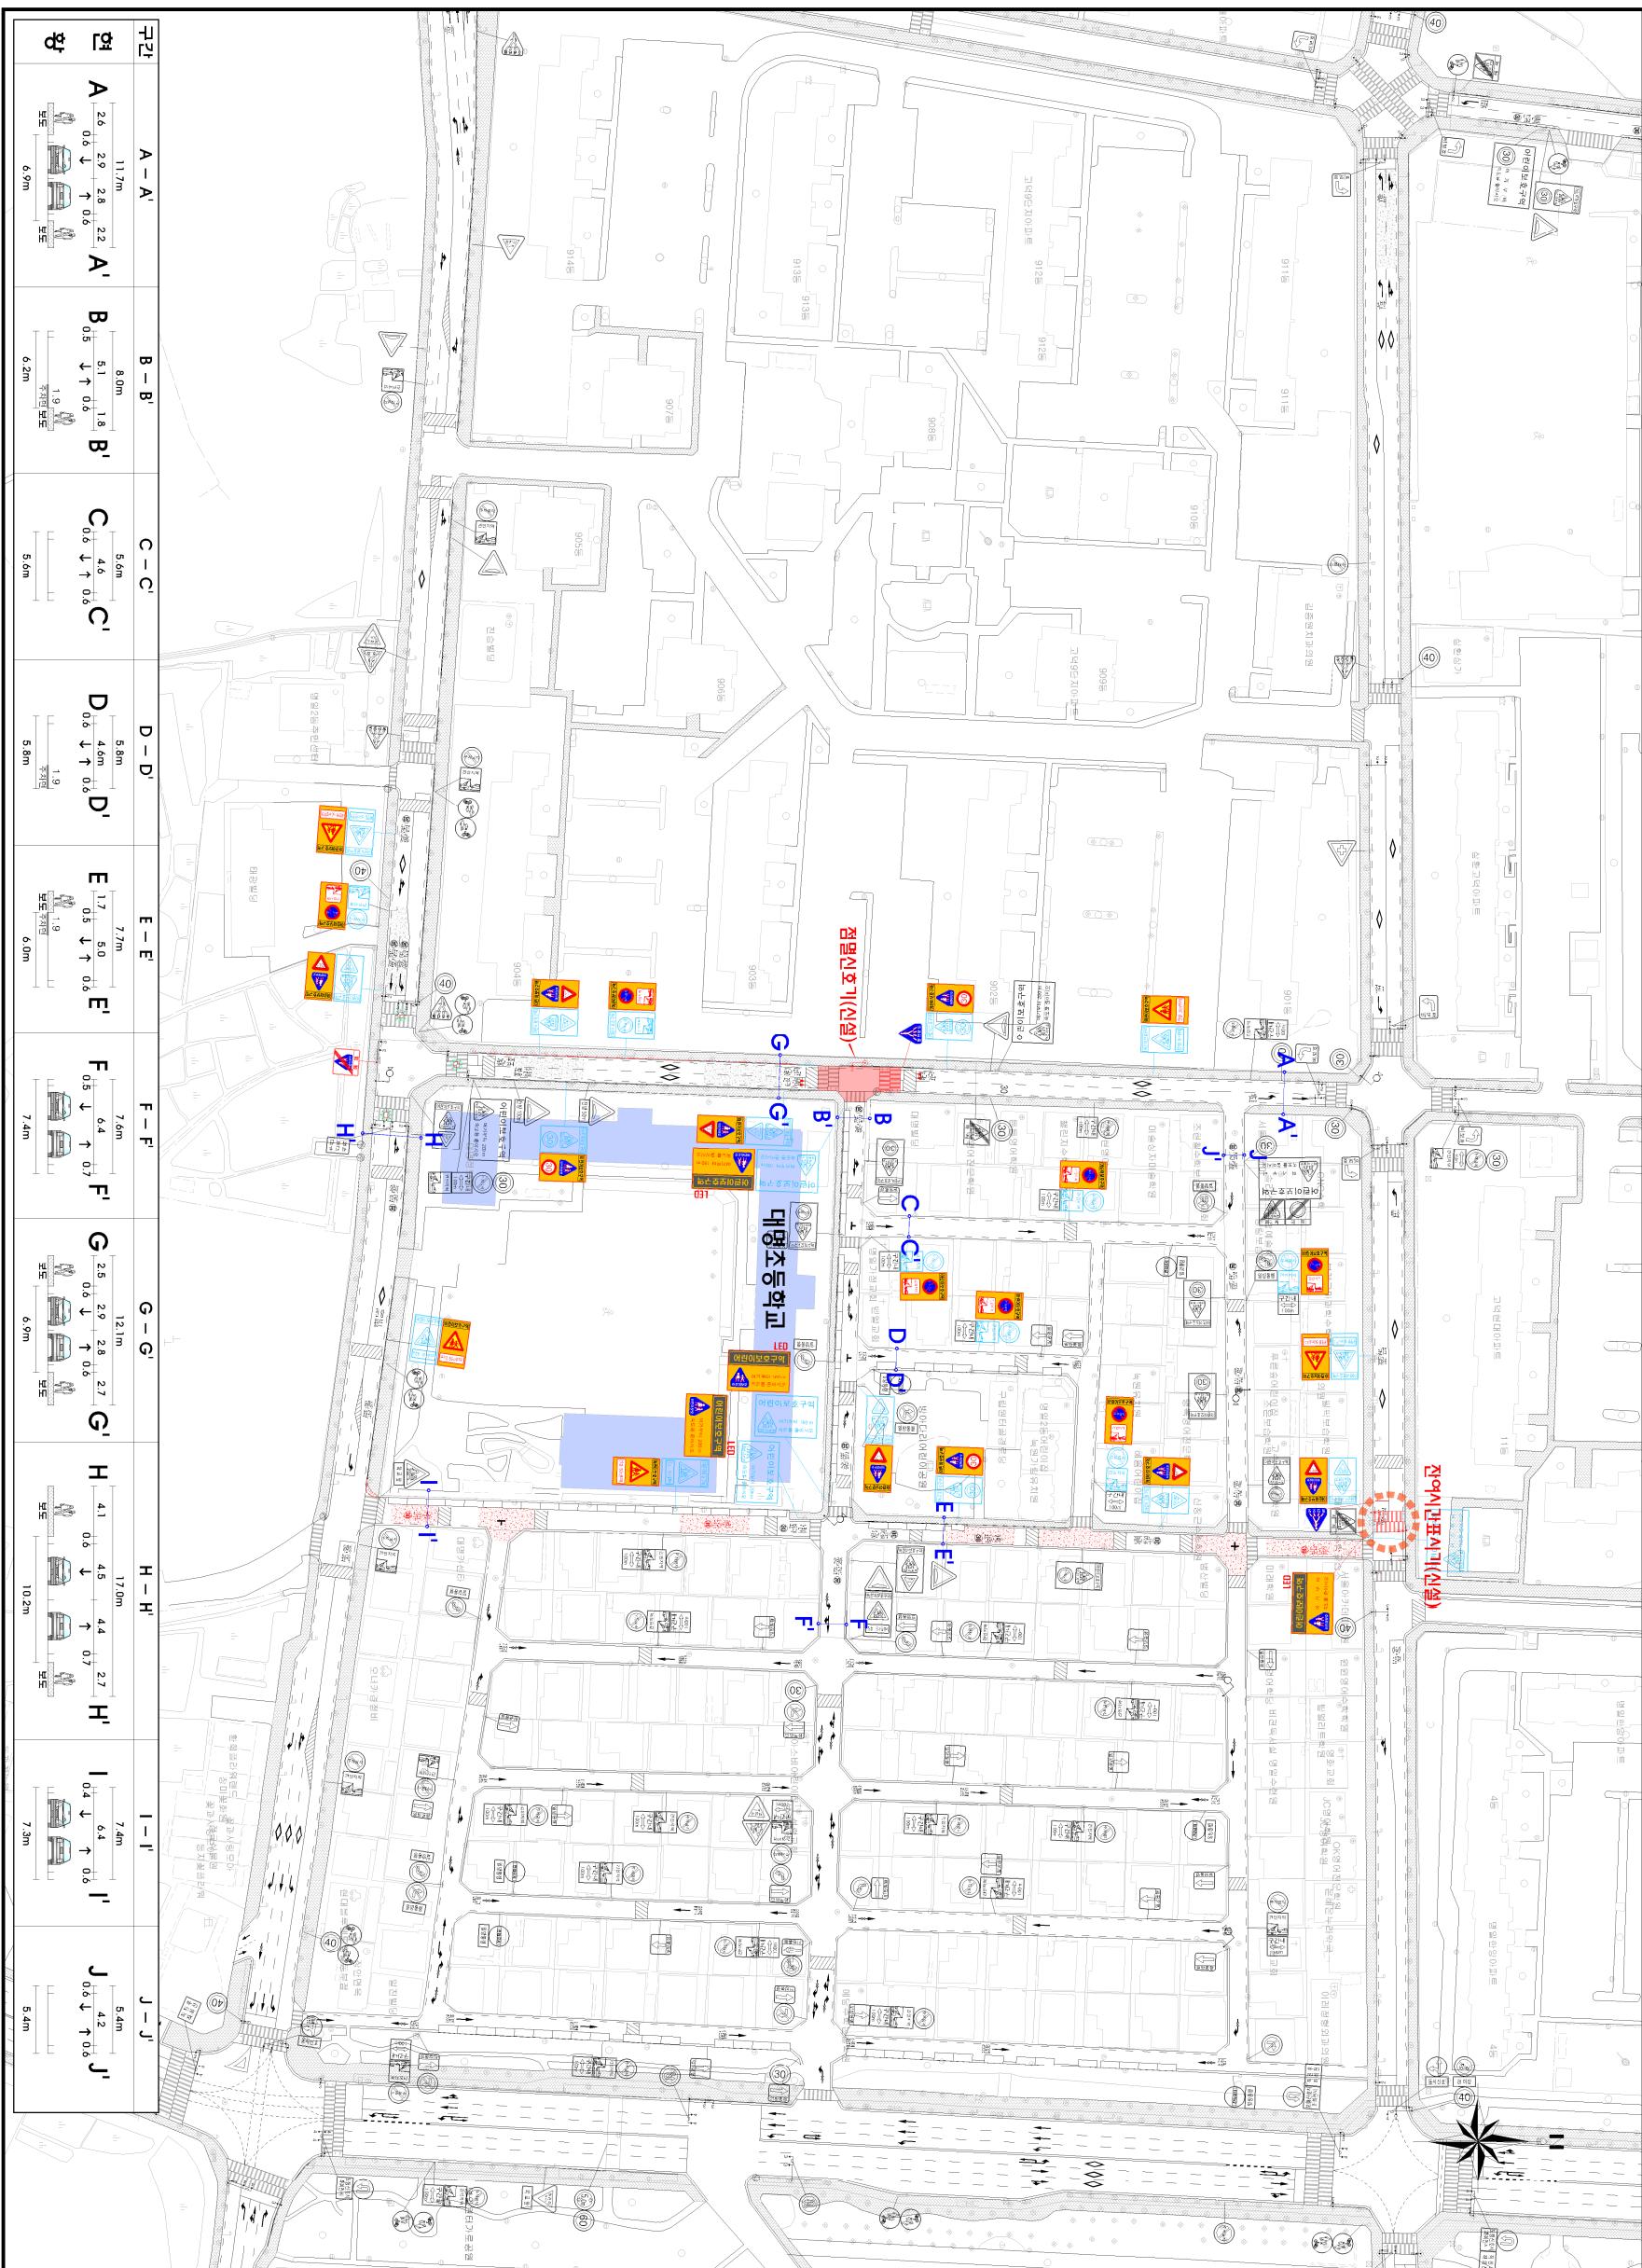

[ 범 류 ]		현 황	
—	—	신	설
—	—	제	거
—	—	교	운
—	—	안	전

