


화랑대사거리(개선)

개선 사항

- 차선 및 안전지대 조정으로 시설전용 진입차로 신설
- 속도제한 표지판 신설(2개소)

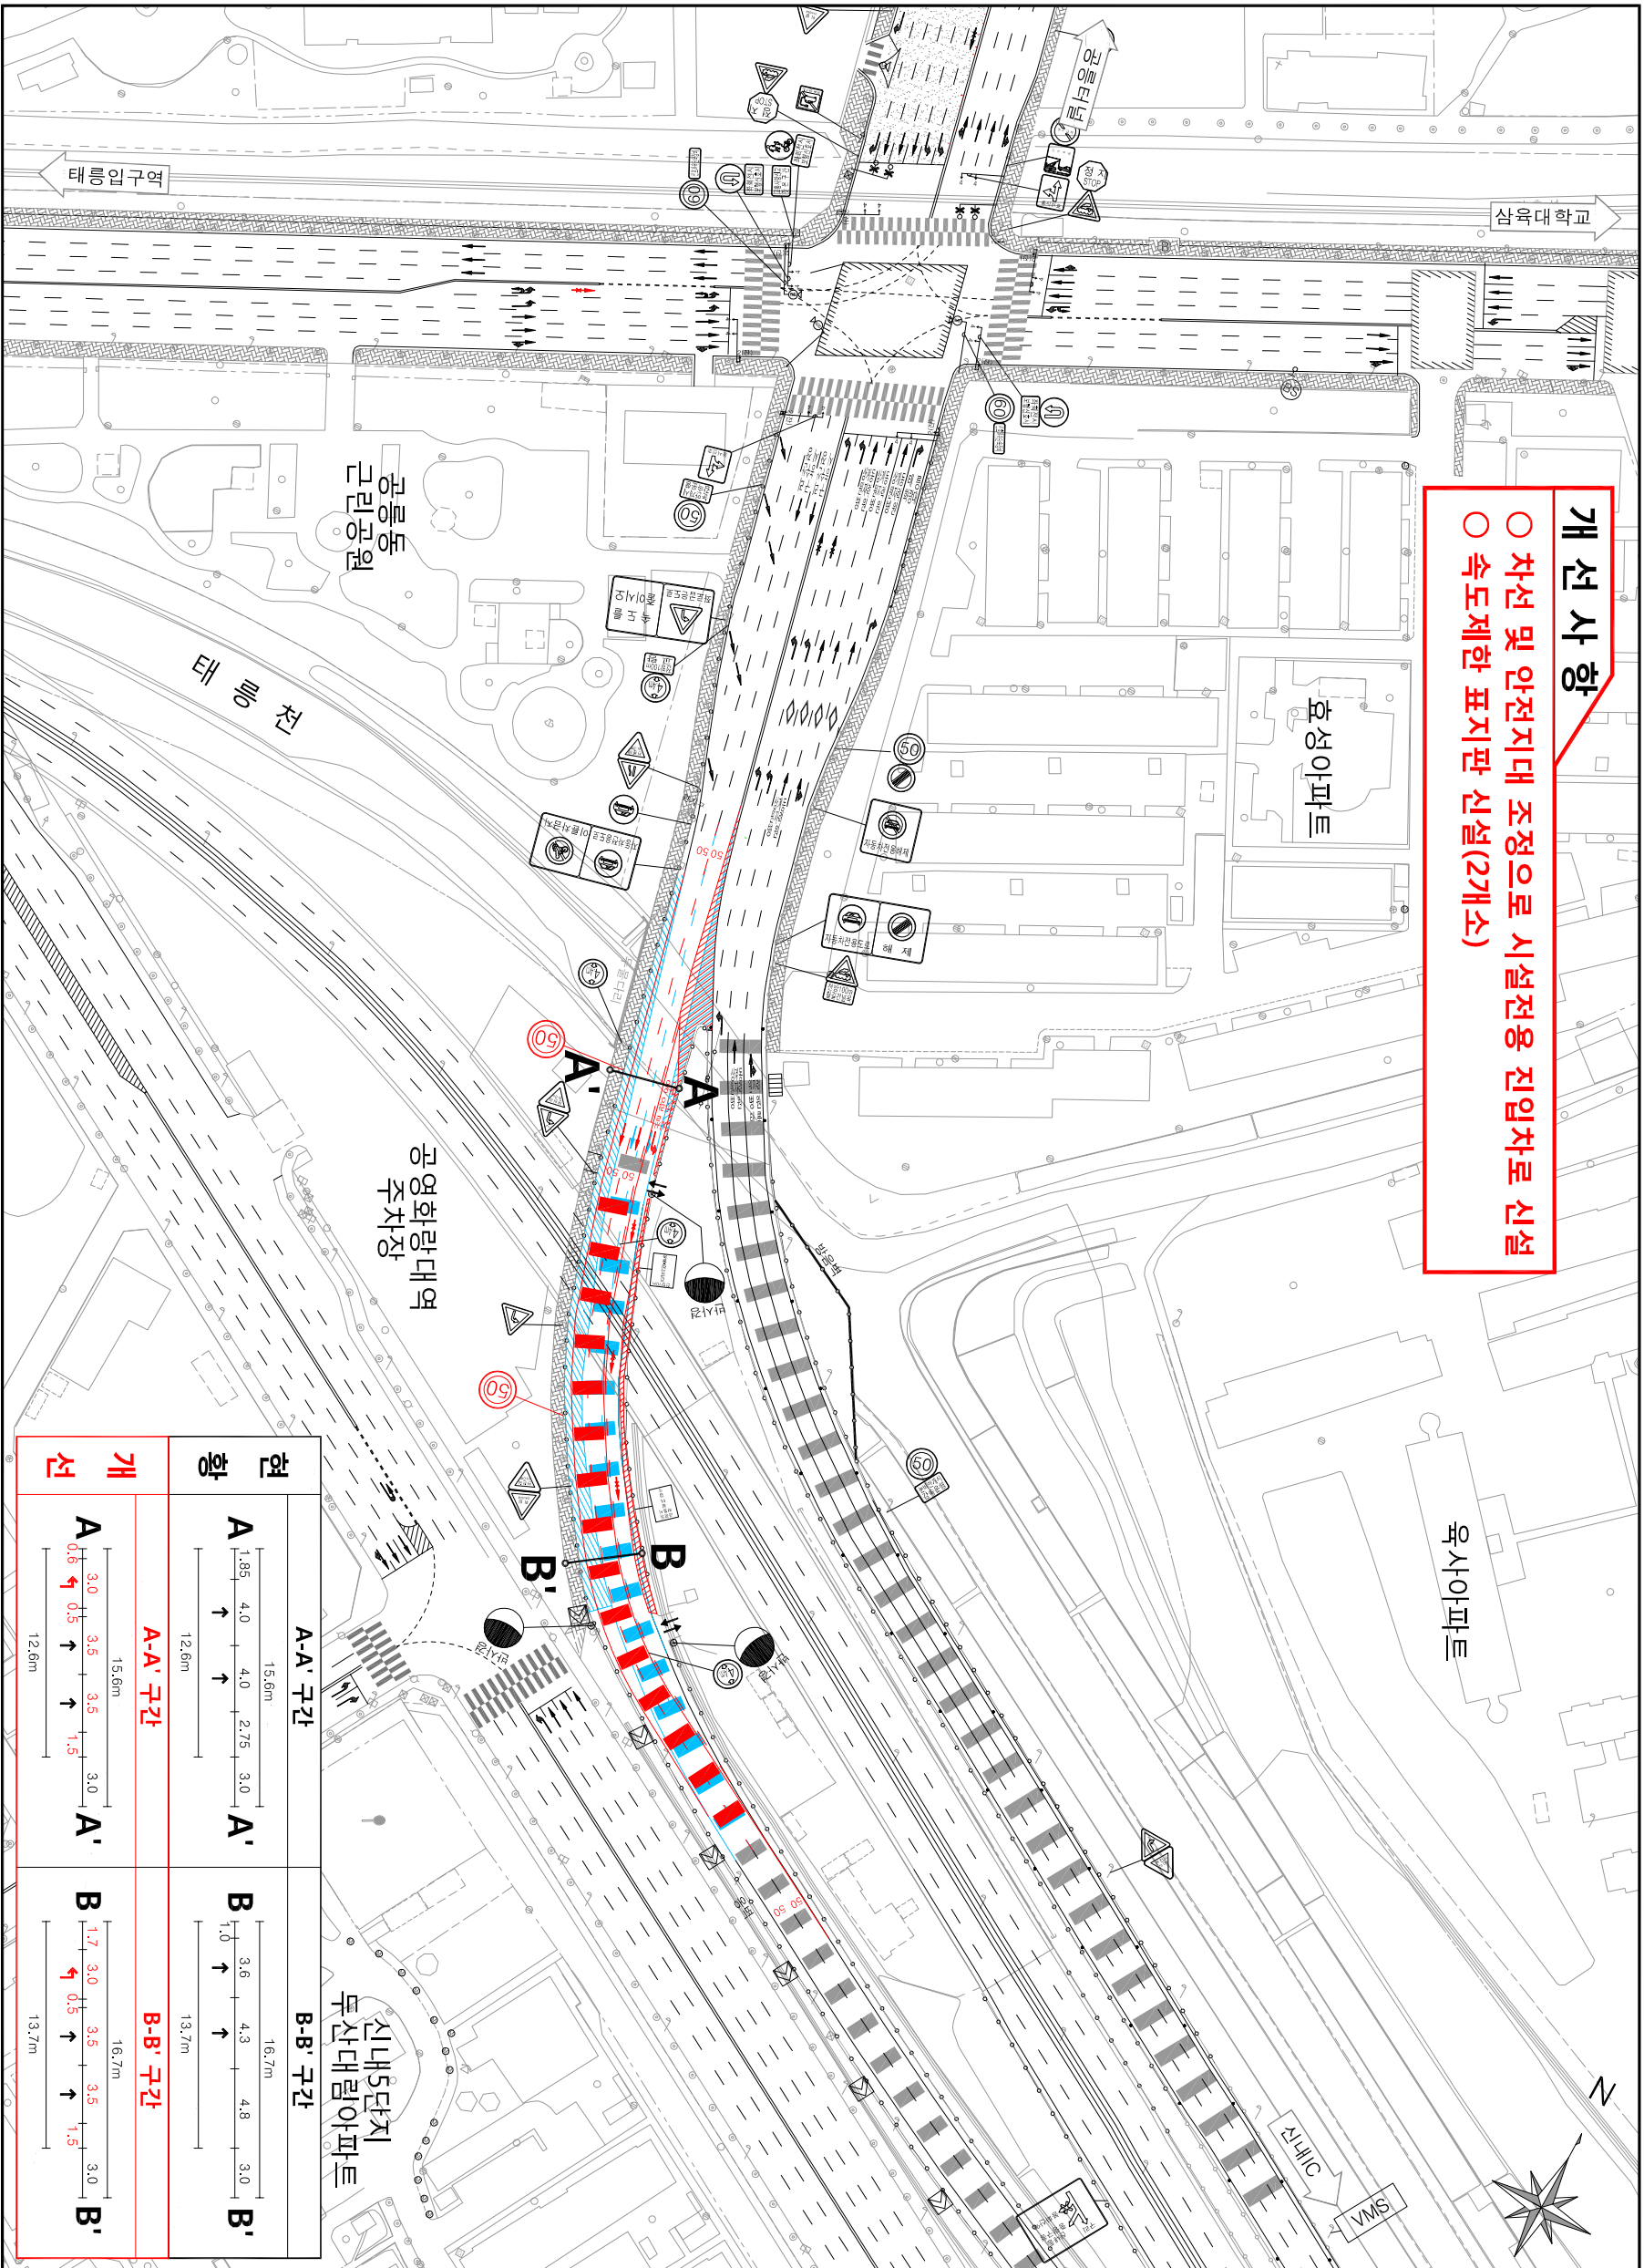

현황	개선	
<table border="1"> <tr> <th colspan="2">A-A' 구간</th> <th colspan="2">B-B' 구간</th> </tr> <tr> <td>A</td> <td>A'</td> <td>B</td> <td>B'</td> </tr> <tr> <td>1.85</td> <td>4.0</td> <td>3.6</td> <td>4.8</td> </tr> <tr> <td>4.0</td> <td>2.75</td> <td>4.3</td> <td>3.0</td> </tr> <tr> <td>15.6m</td> <td>12.6m</td> <td>16.7m</td> <td>13.7m</td> </tr> </table>	A-A' 구간		B-B' 구간		A	A'	B	B'	1.85	4.0	3.6	4.8	4.0	2.75	4.3	3.0	15.6m	12.6m	16.7m	13.7m	<table border="1"> <tr> <th colspan="2">A-A' 구간</th> <th colspan="2">B-B' 구간</th> </tr> <tr> <td>A</td> <td>A'</td> <td>B</td> <td>B'</td> </tr> <tr> <td>3.0</td> <td>3.5</td> <td>1.7</td> <td>3.0</td> </tr> <tr> <td>0.6</td> <td>0.5</td> <td>3.0</td> <td>3.5</td> </tr> <tr> <td>15.6m</td> <td>12.6m</td> <td>16.7m</td> <td>13.7m</td> </tr> </table>	A-A' 구간		B-B' 구간		A	A'	B	B'	3.0	3.5	1.7	3.0	0.6	0.5	3.0	3.5	15.6m	12.6m	16.7m	13.7m

