


화랑대사거리(개선)

개선 사항

- 차선 및 안전지대 조정으로 시설전용 진입차로 신설
- 속도제한 표지판 신설(2개소)

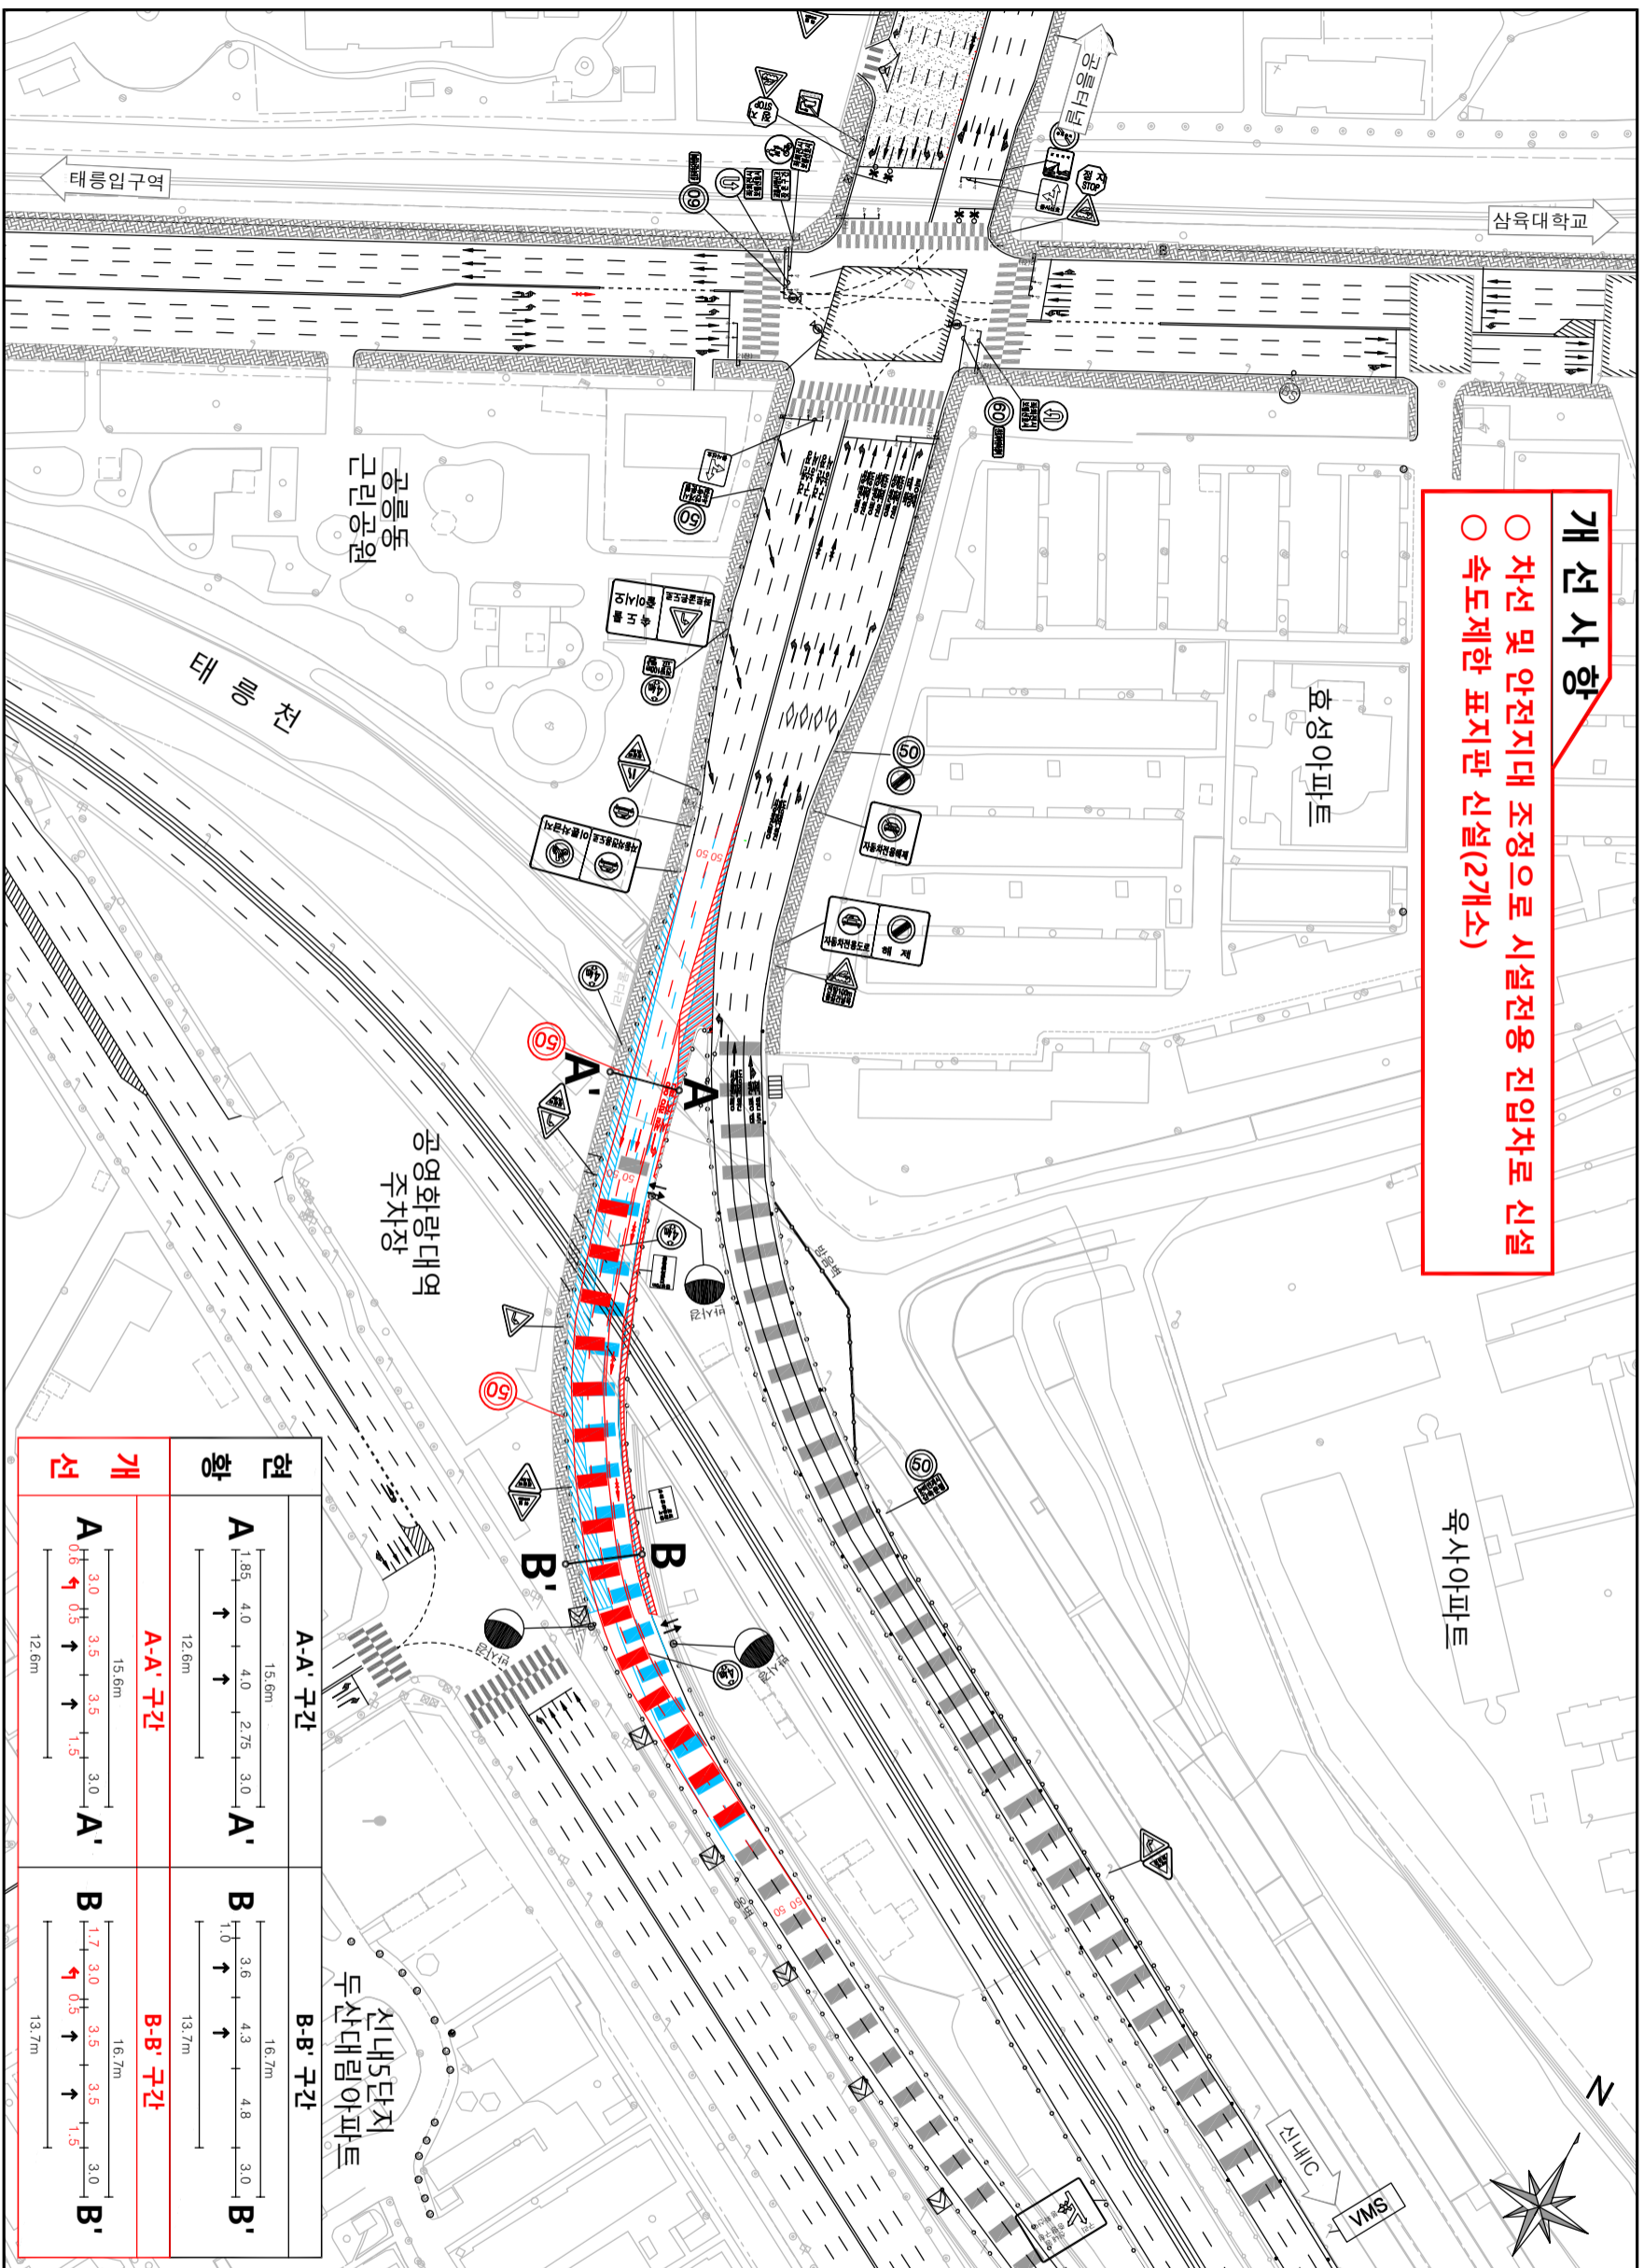

현황	A-A' 구간	B-B' 구간	
<b>개선</b>	<table border="1"> <tr> <td>A</td> <td>1.85</td> <td>4.0</td> <td>4.0</td> <td>2.75</td> <td>3.0</td> <td>A'</td> </tr> <tr> <td colspan="7">12.6m</td> </tr> <tr> <td colspan="7"><b>A-A' 구간</b></td> </tr> <tr> <td colspan="7">12.6m</td> </tr> </table>	A	1.85	4.0	4.0	2.75	3.0	A'	12.6m							<b>A-A' 구간</b>							A	0.8	3.0	3.5	3.5	3.0	A'	12.6m							<table border="1"> <tr> <td>B</td> <td>1.7</td> <td>3.0</td> <td>3.5</td> <td>3.5</td> <td>3.0</td> <td>B'</td> </tr> <tr> <td colspan="7">13.7m</td> </tr> <tr> <td colspan="7"><b>B-B' 구간</b></td> </tr> <tr> <td>B</td> <td>1.0</td> <td>3.6</td> <td>4.3</td> <td>4.8</td> <td>3.0</td> <td>B'</td> </tr> <tr> <td colspan="7">13.7m</td> </tr> </table>	B	1.7	3.0	3.5	3.5	3.0	B'	13.7m							<b>B-B' 구간</b>							B	1.0	3.6	4.3	4.8	3.0	B'	13.7m						

