


## 01-1. 잠수교 남단 횡단보도

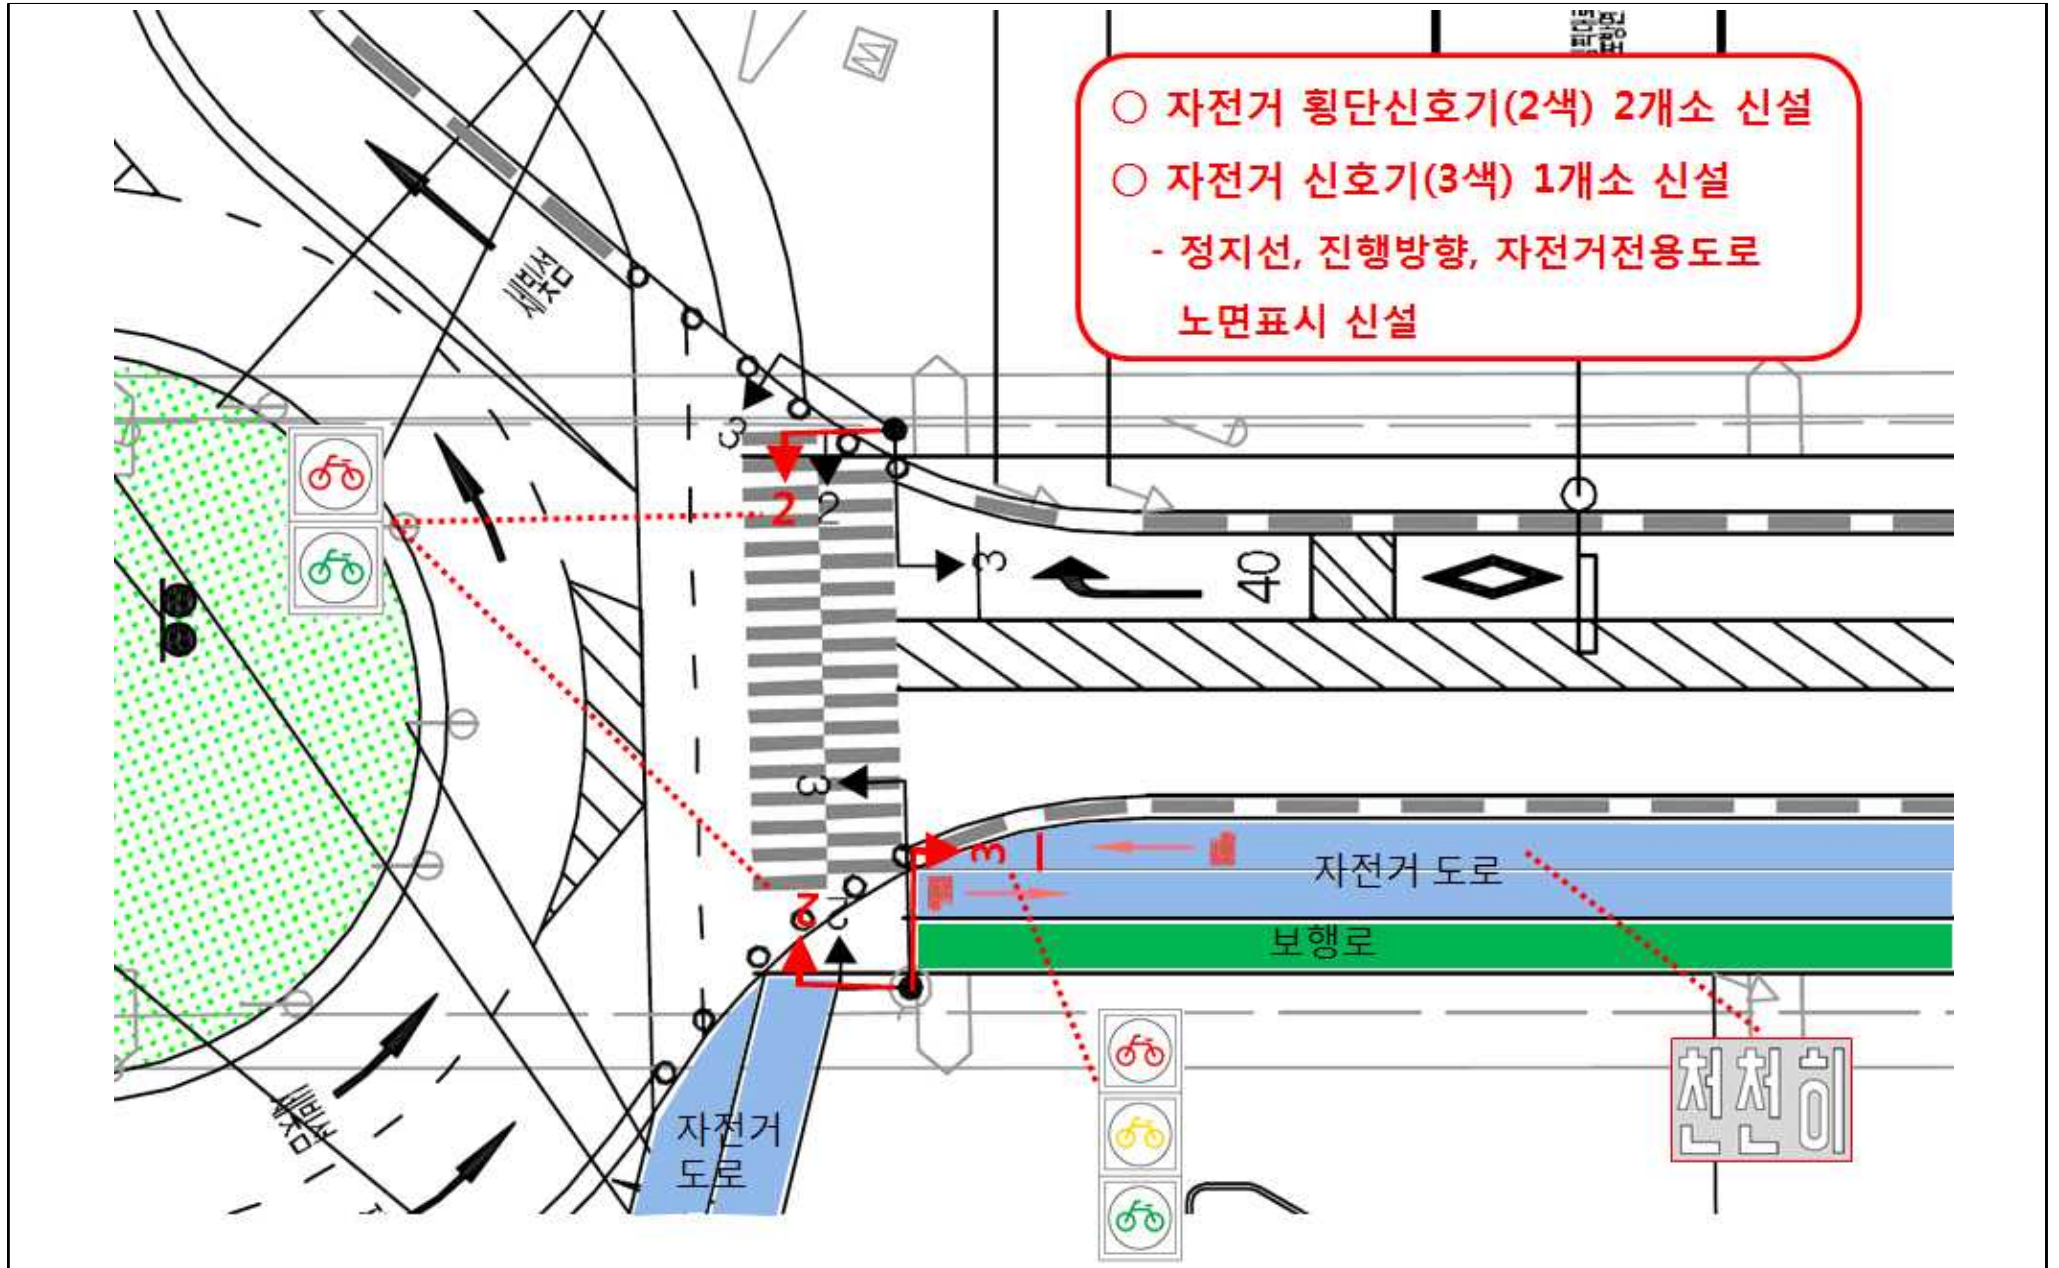


01-2. 잠수교 남단 횡단보도



#### 04. 서초동 1303-16 (서초4동 주민센터 임시청사) 앞



05. 서초동 1641-7 앞

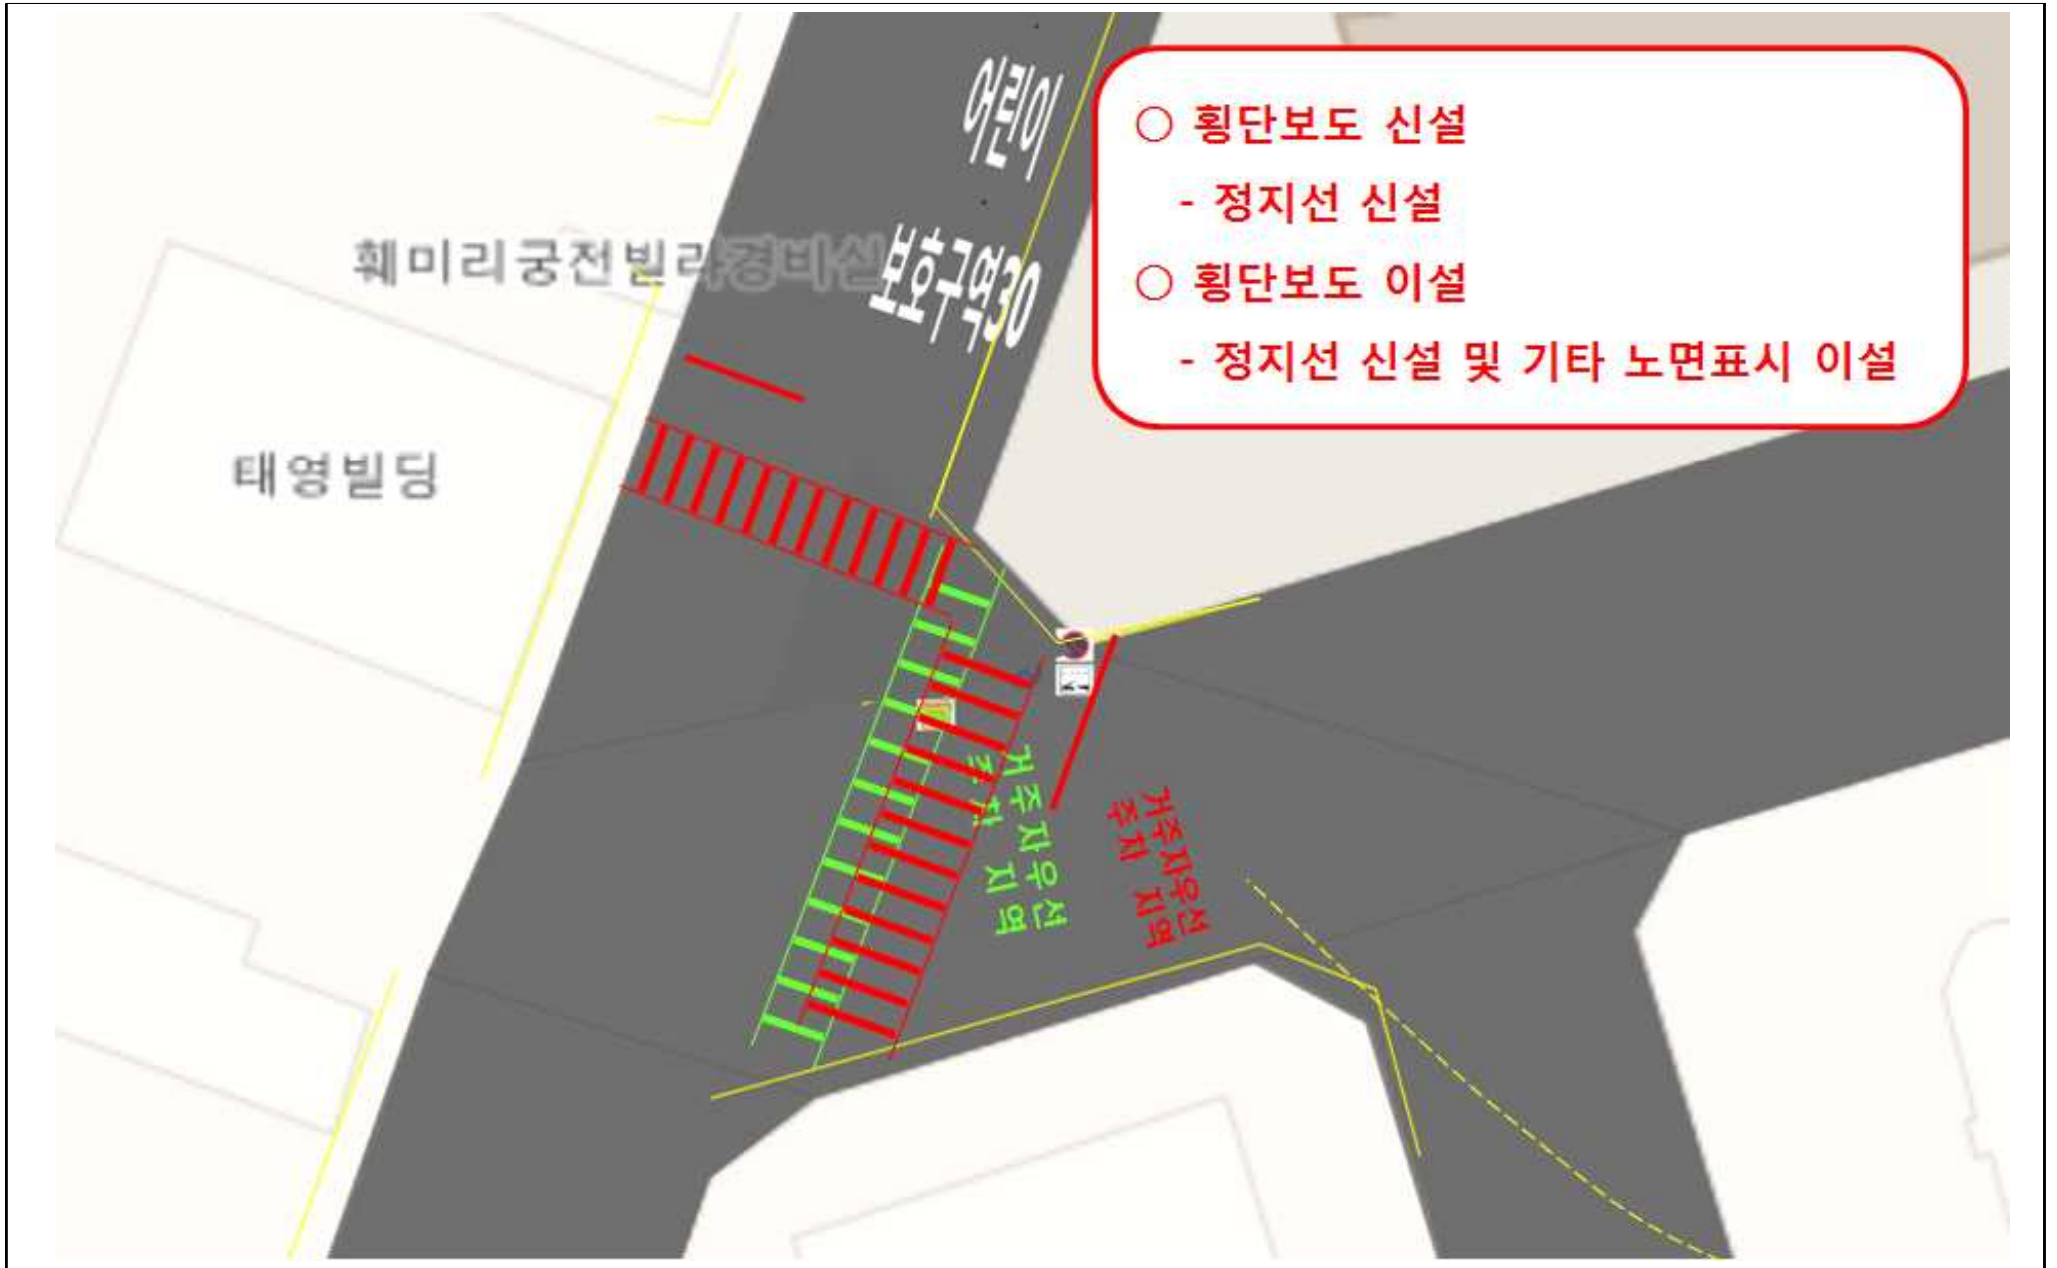


06. 서초동 1506-88 (현대 홈타운A) 앞



07. 우면동 18-1 (서초구 청소행정과 차고지) 앞



08. 우면동 142-1 (한국교총) 앞

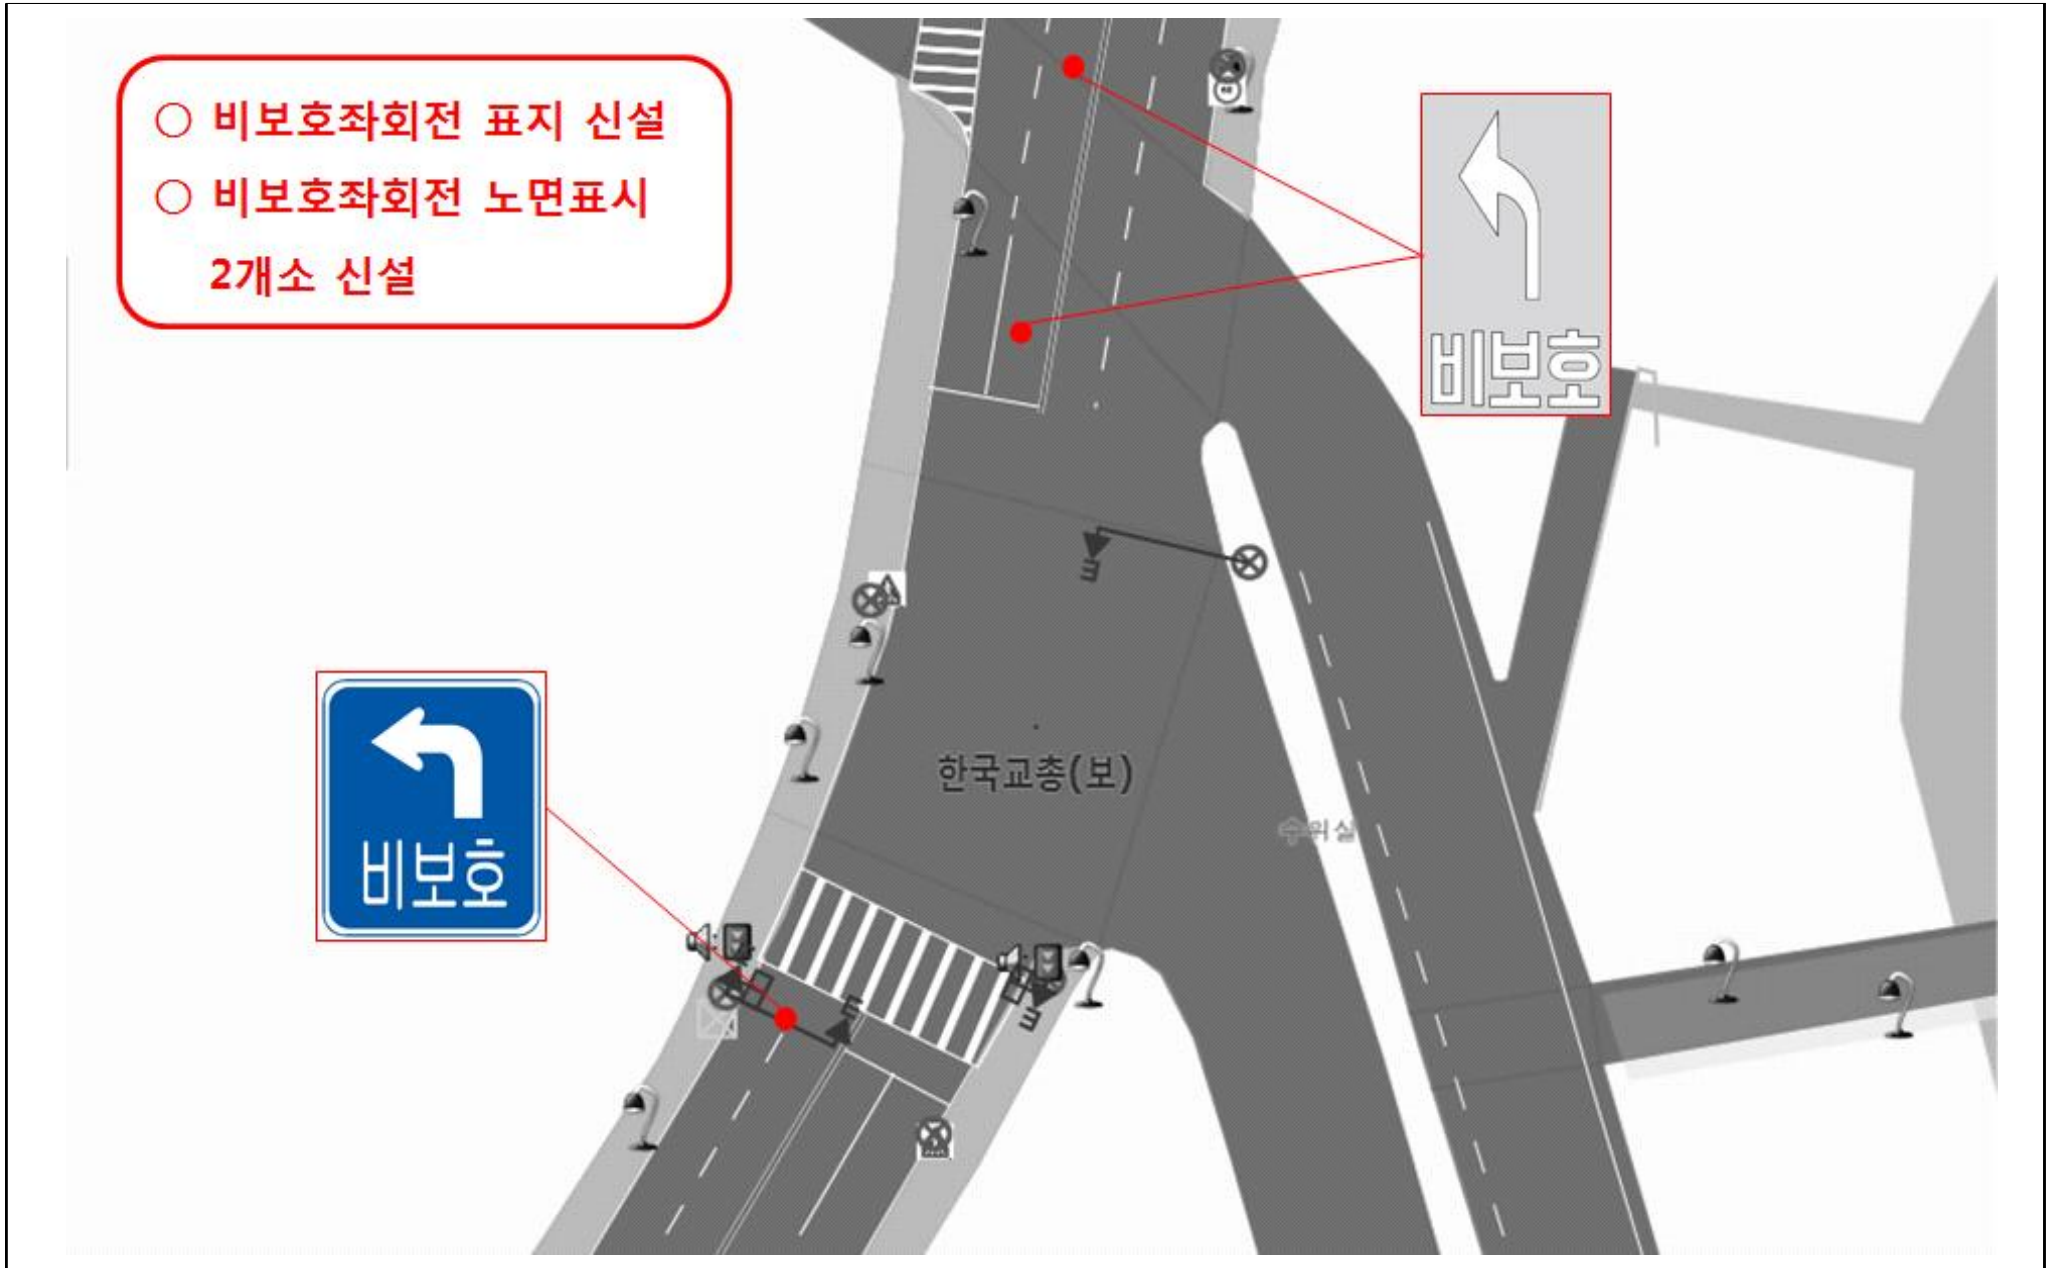

09. 양재동 2-8 앞







10. 양재동 377-3~392-10 (언남중고교) 주변



11. 내곡보금자리지구(A구간)-심의보류안건 재상정

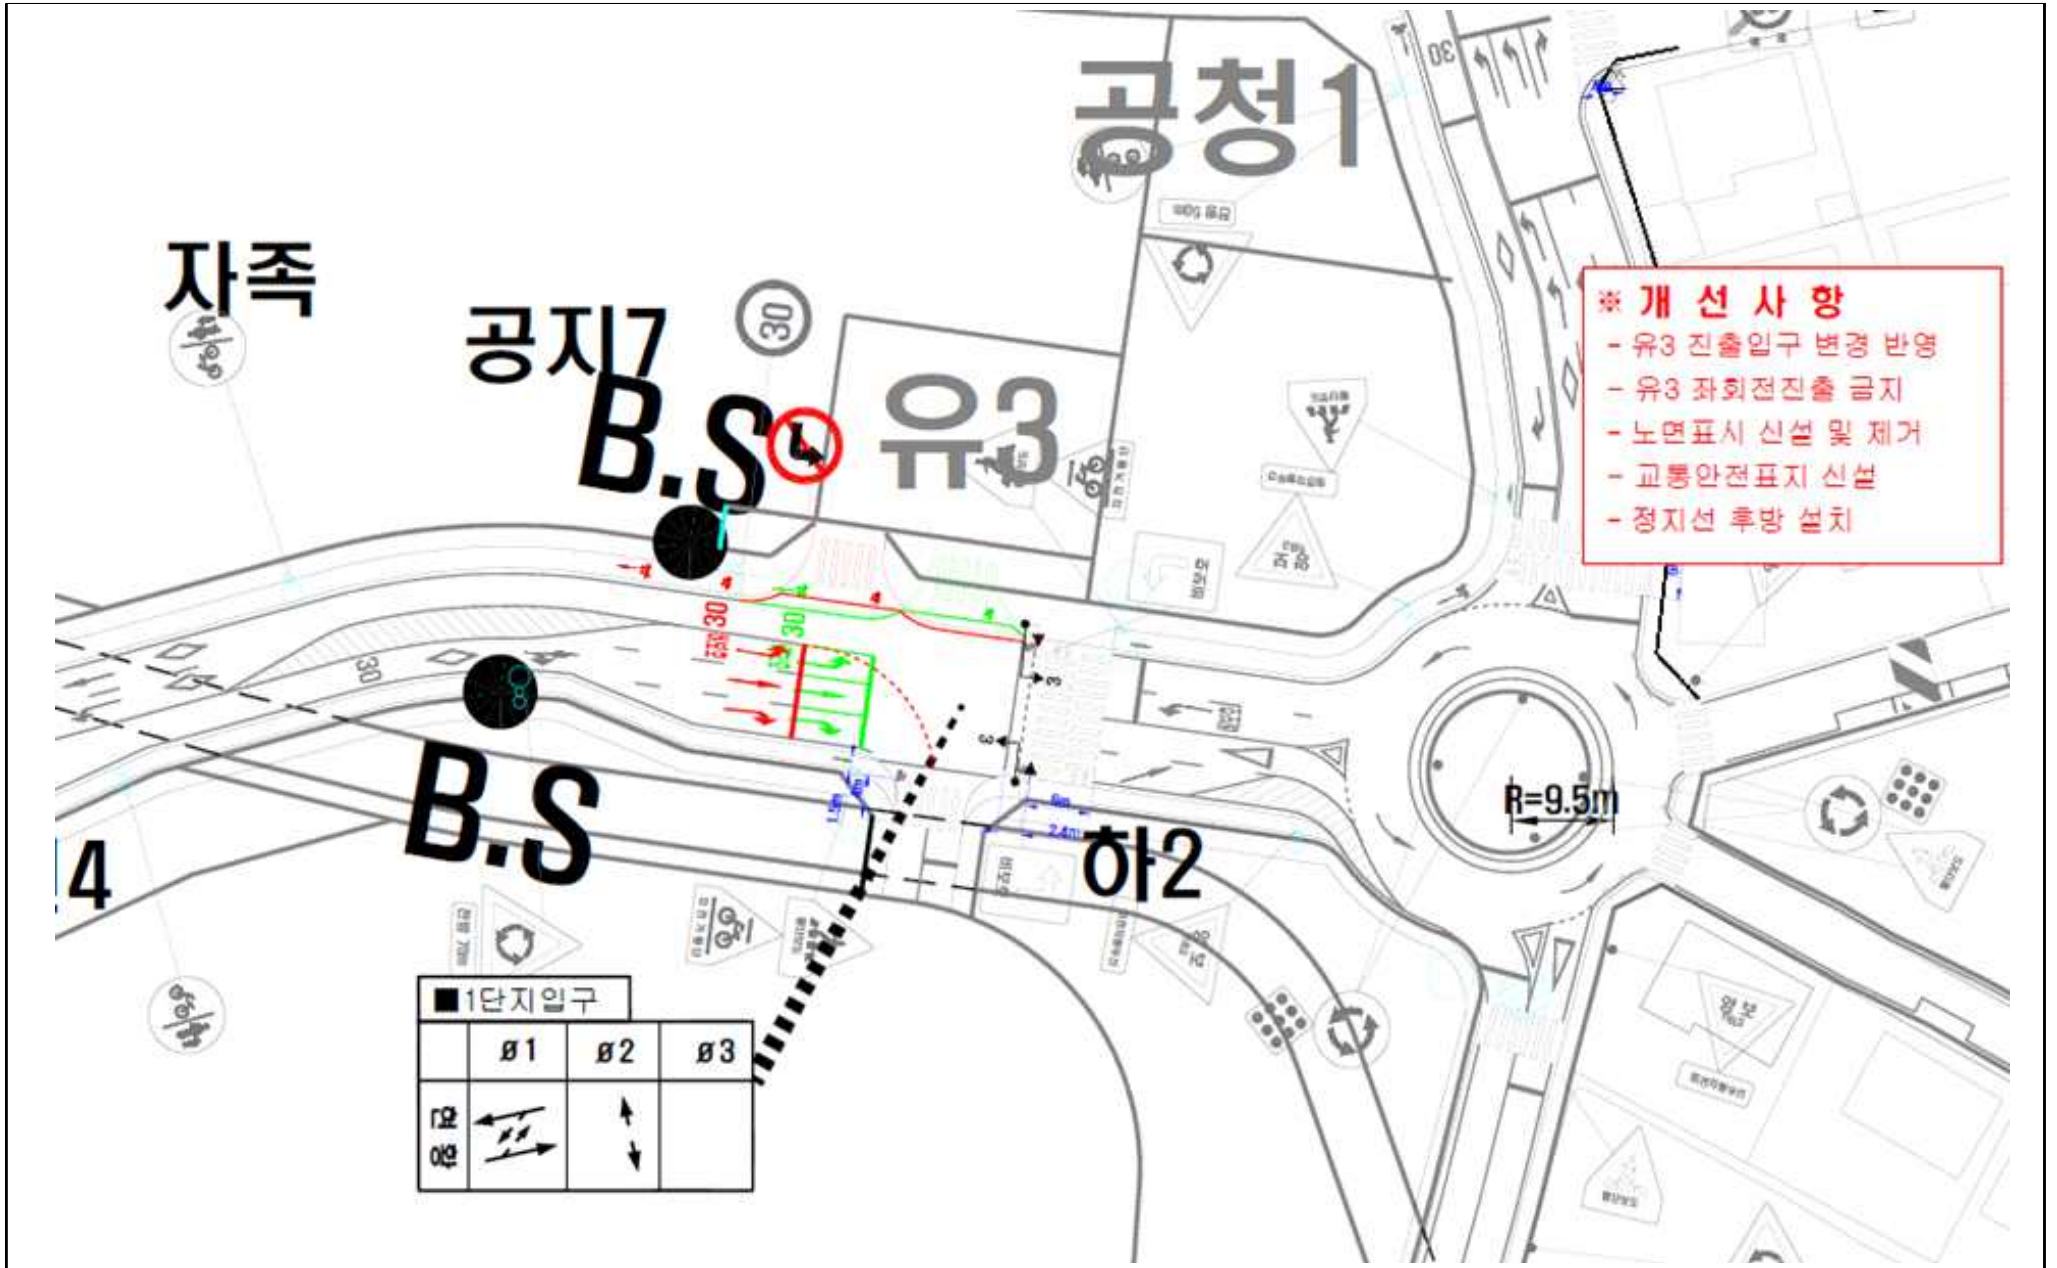


## 12. 내곡보금자리지구(B구간)

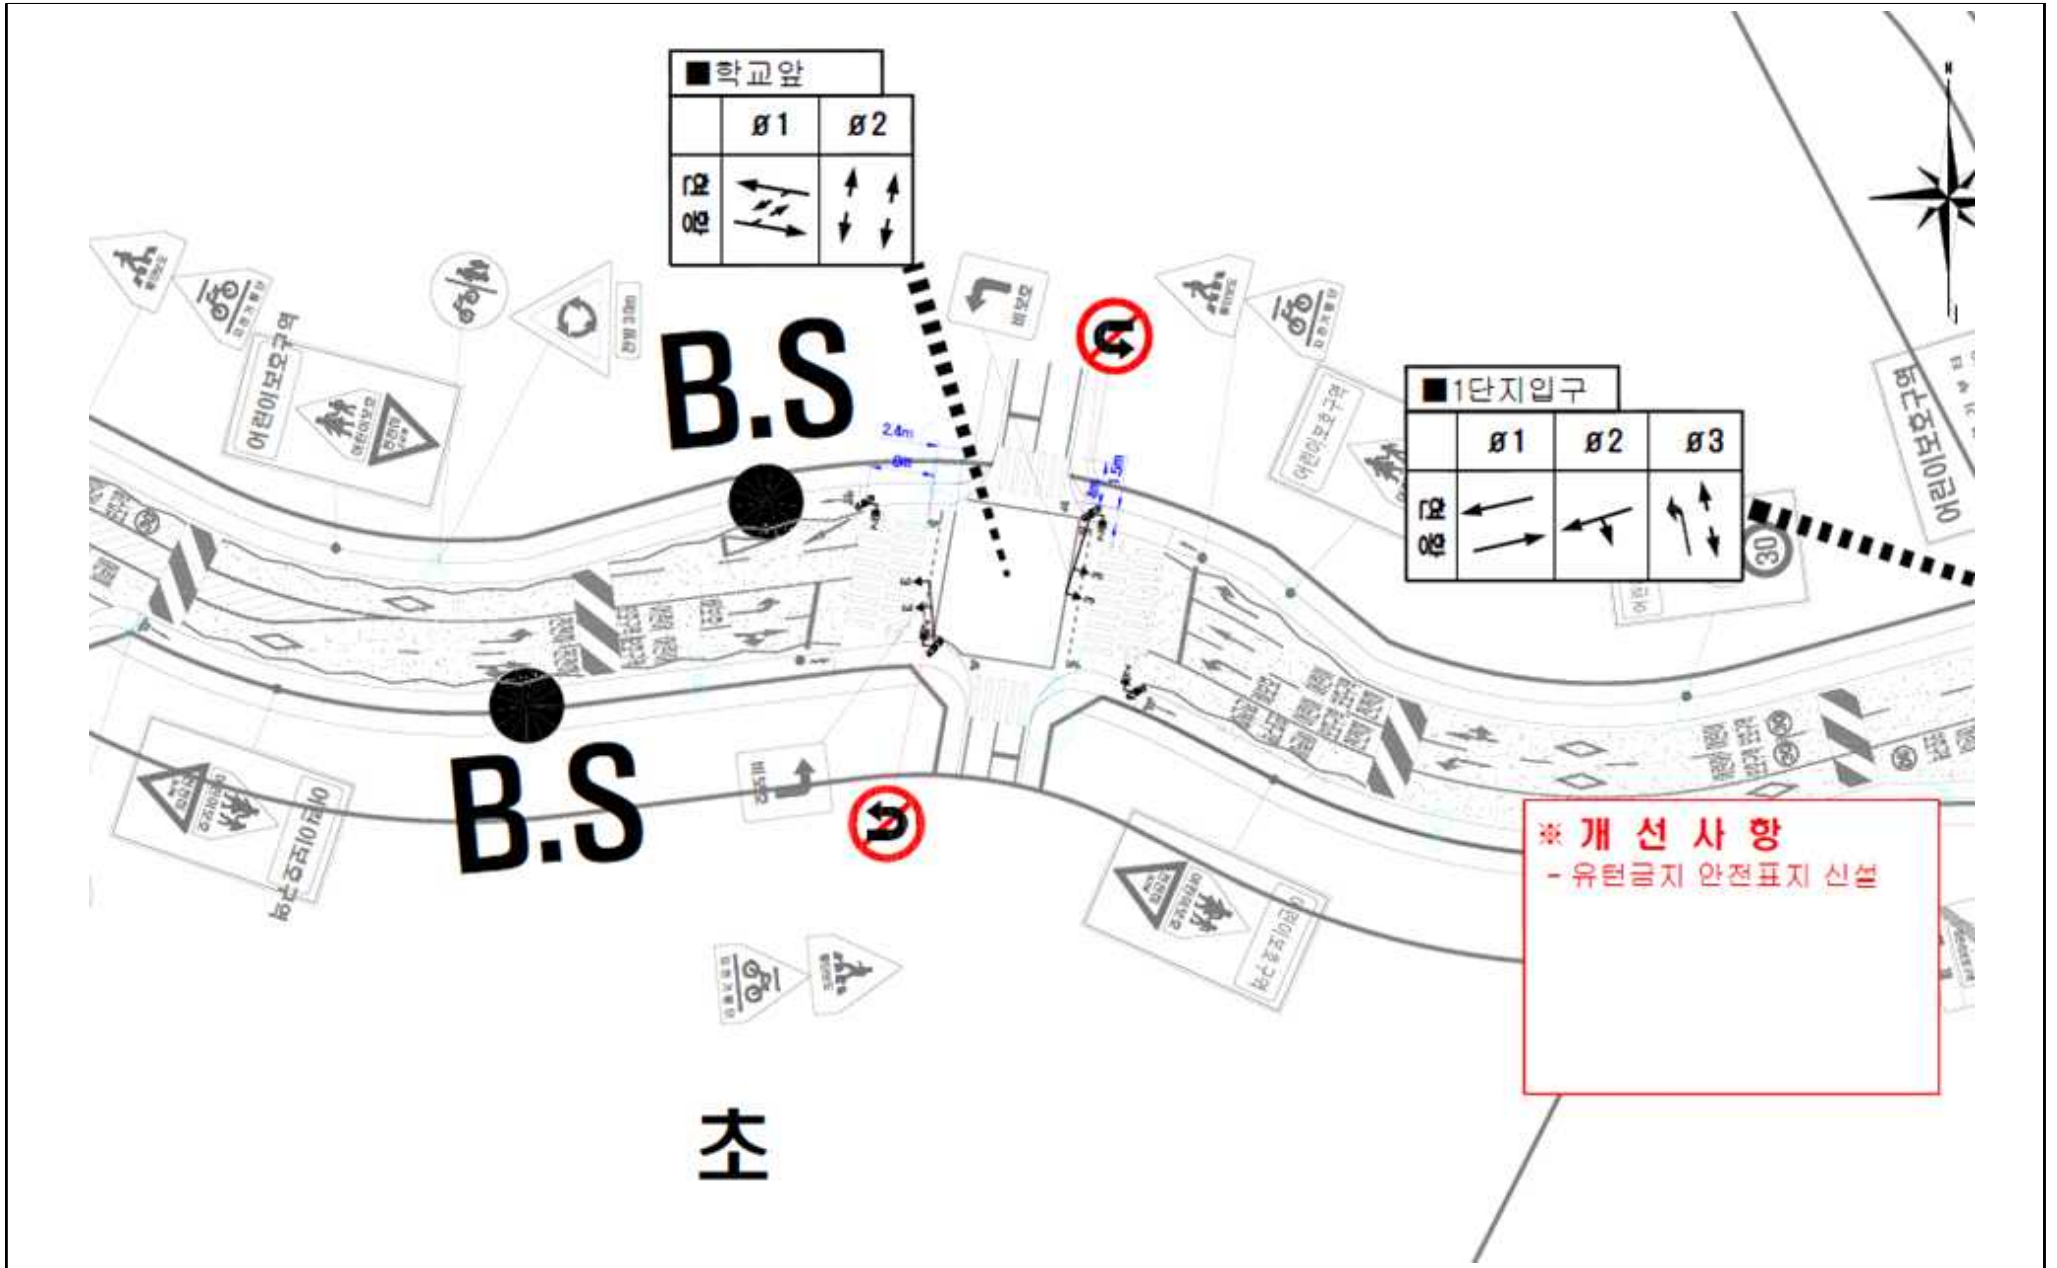


### 13. 내곡보금자리지구(C구간)



# 14. 내곡보금자리지구(D구간)

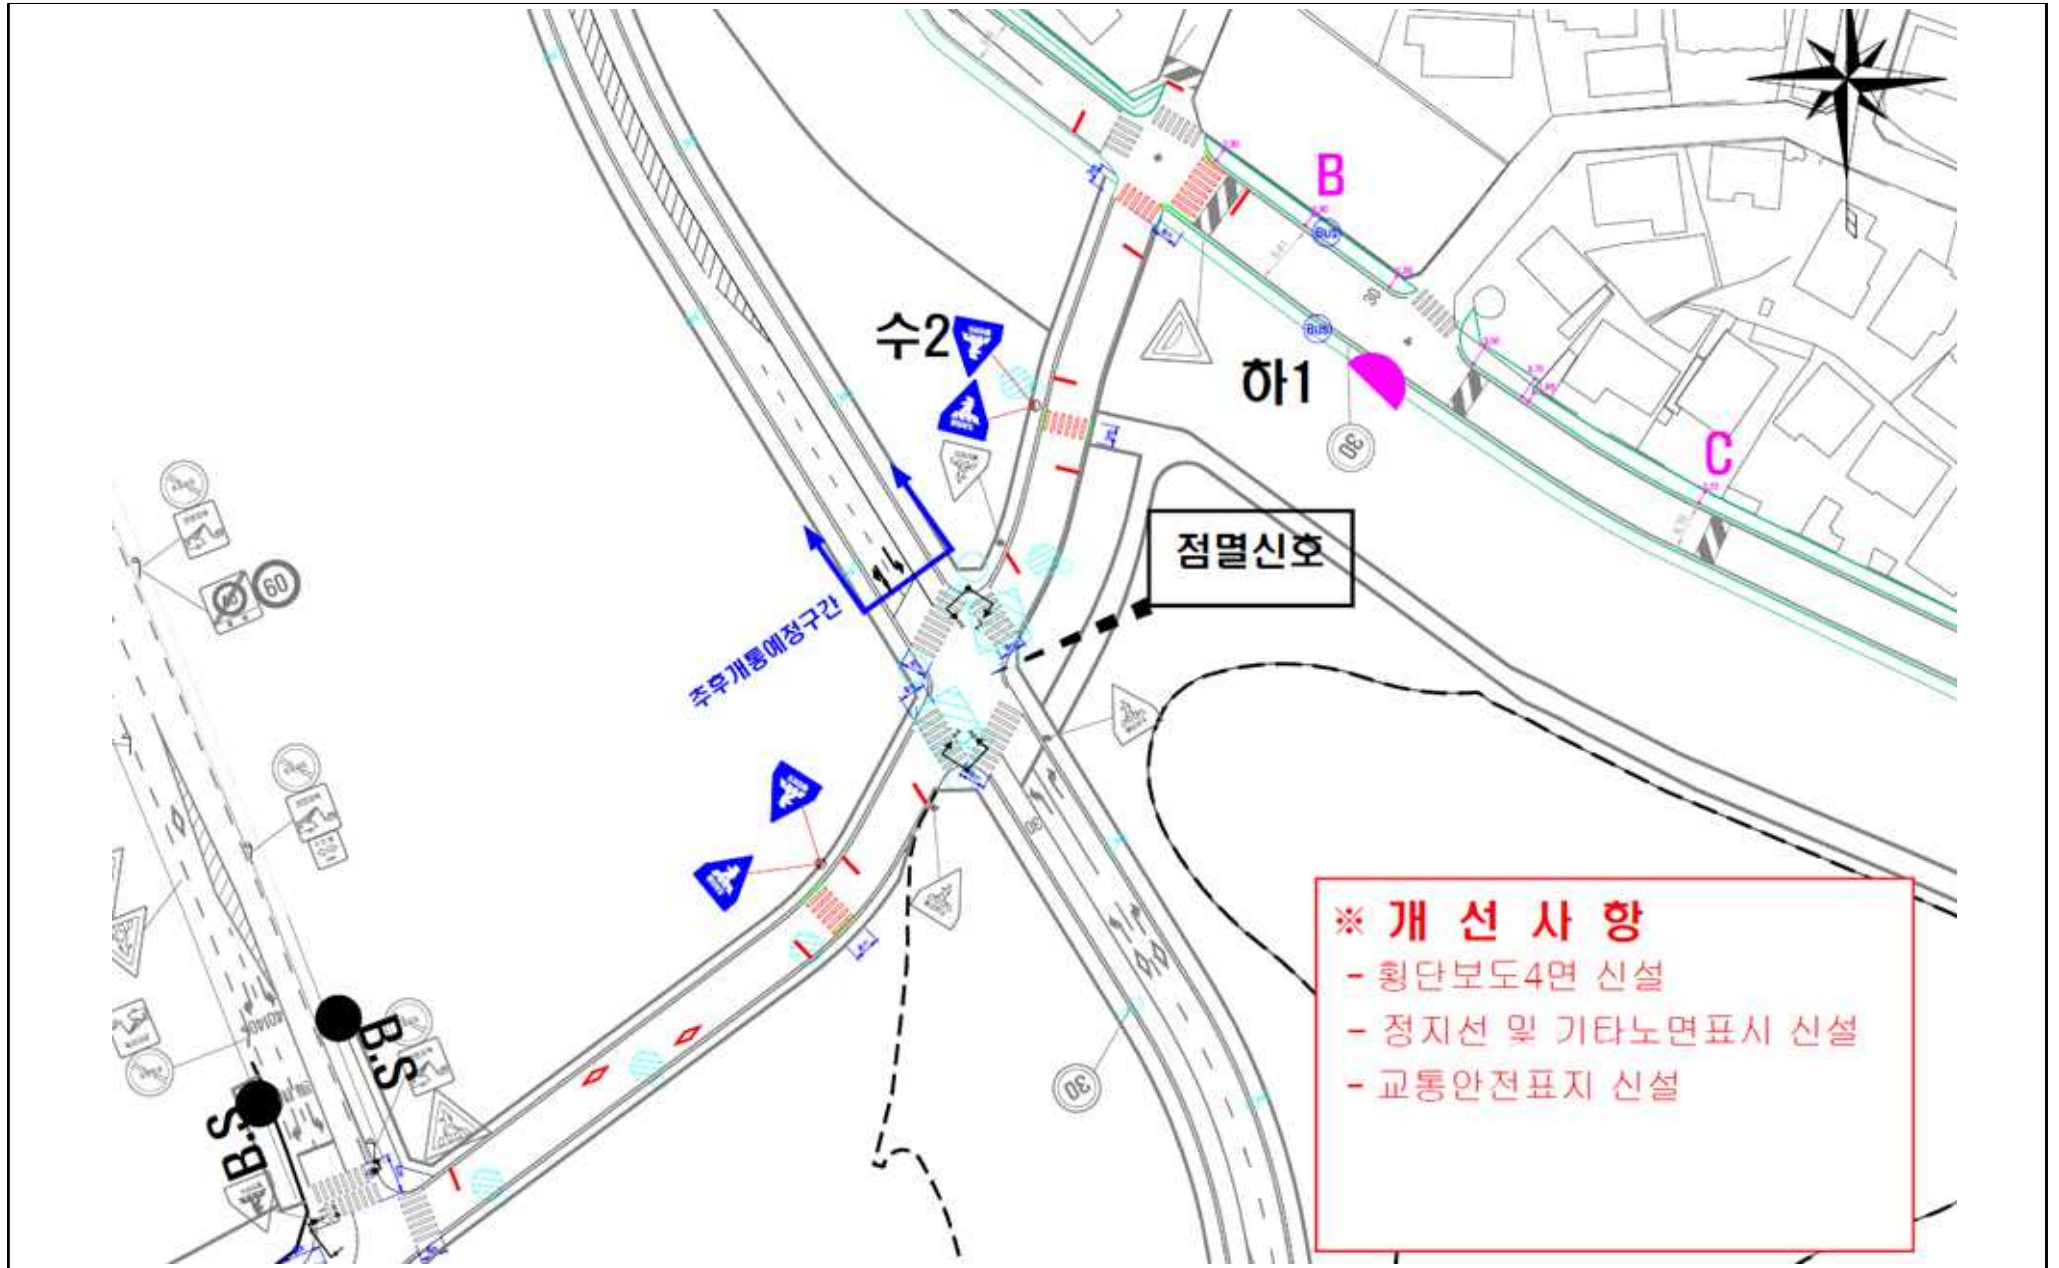

16. 내곡보금자리지구(F구간)

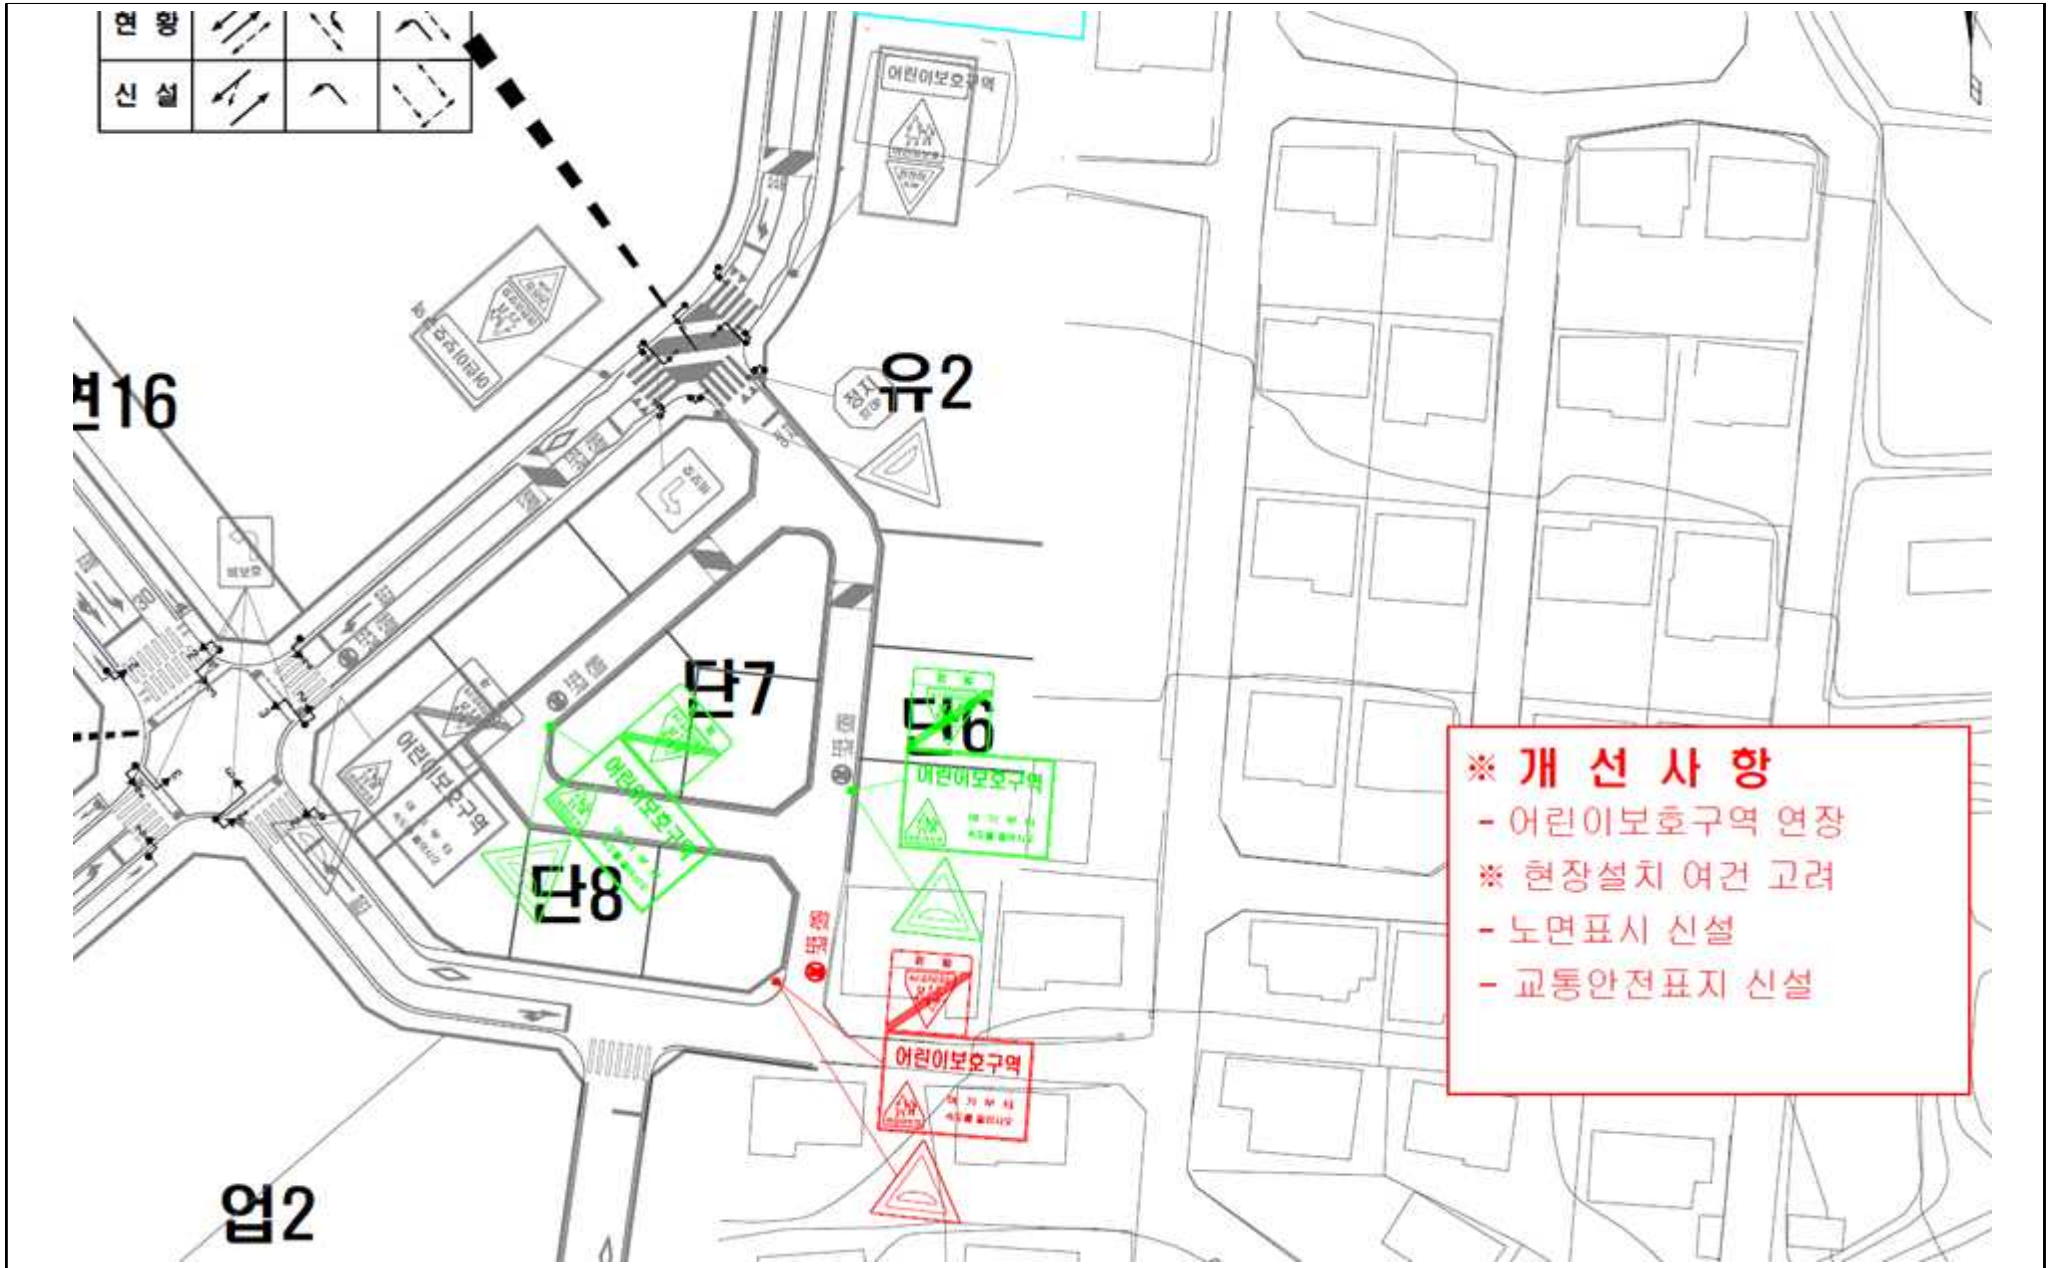

18. 신원동 271-21 (관광숙박시설 신축)

