

고 시

제 1994 - 290 호

관련도면

반경

아래노미리

유기권

노인경

157

158



신

신

창

신

신

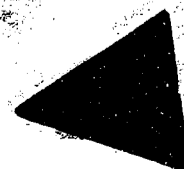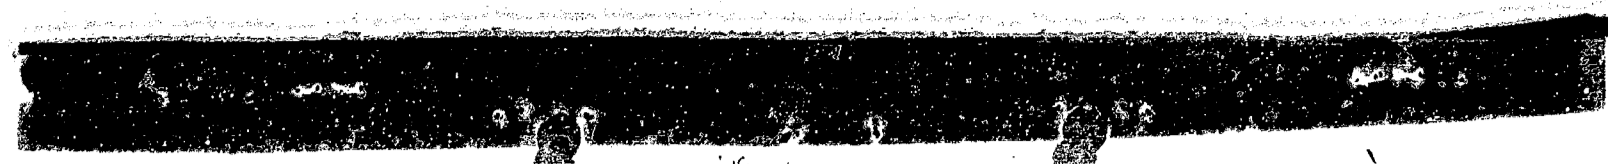

158

장

리

리

리

리

리

가

당초

040 157


유지권

039


041

157


159

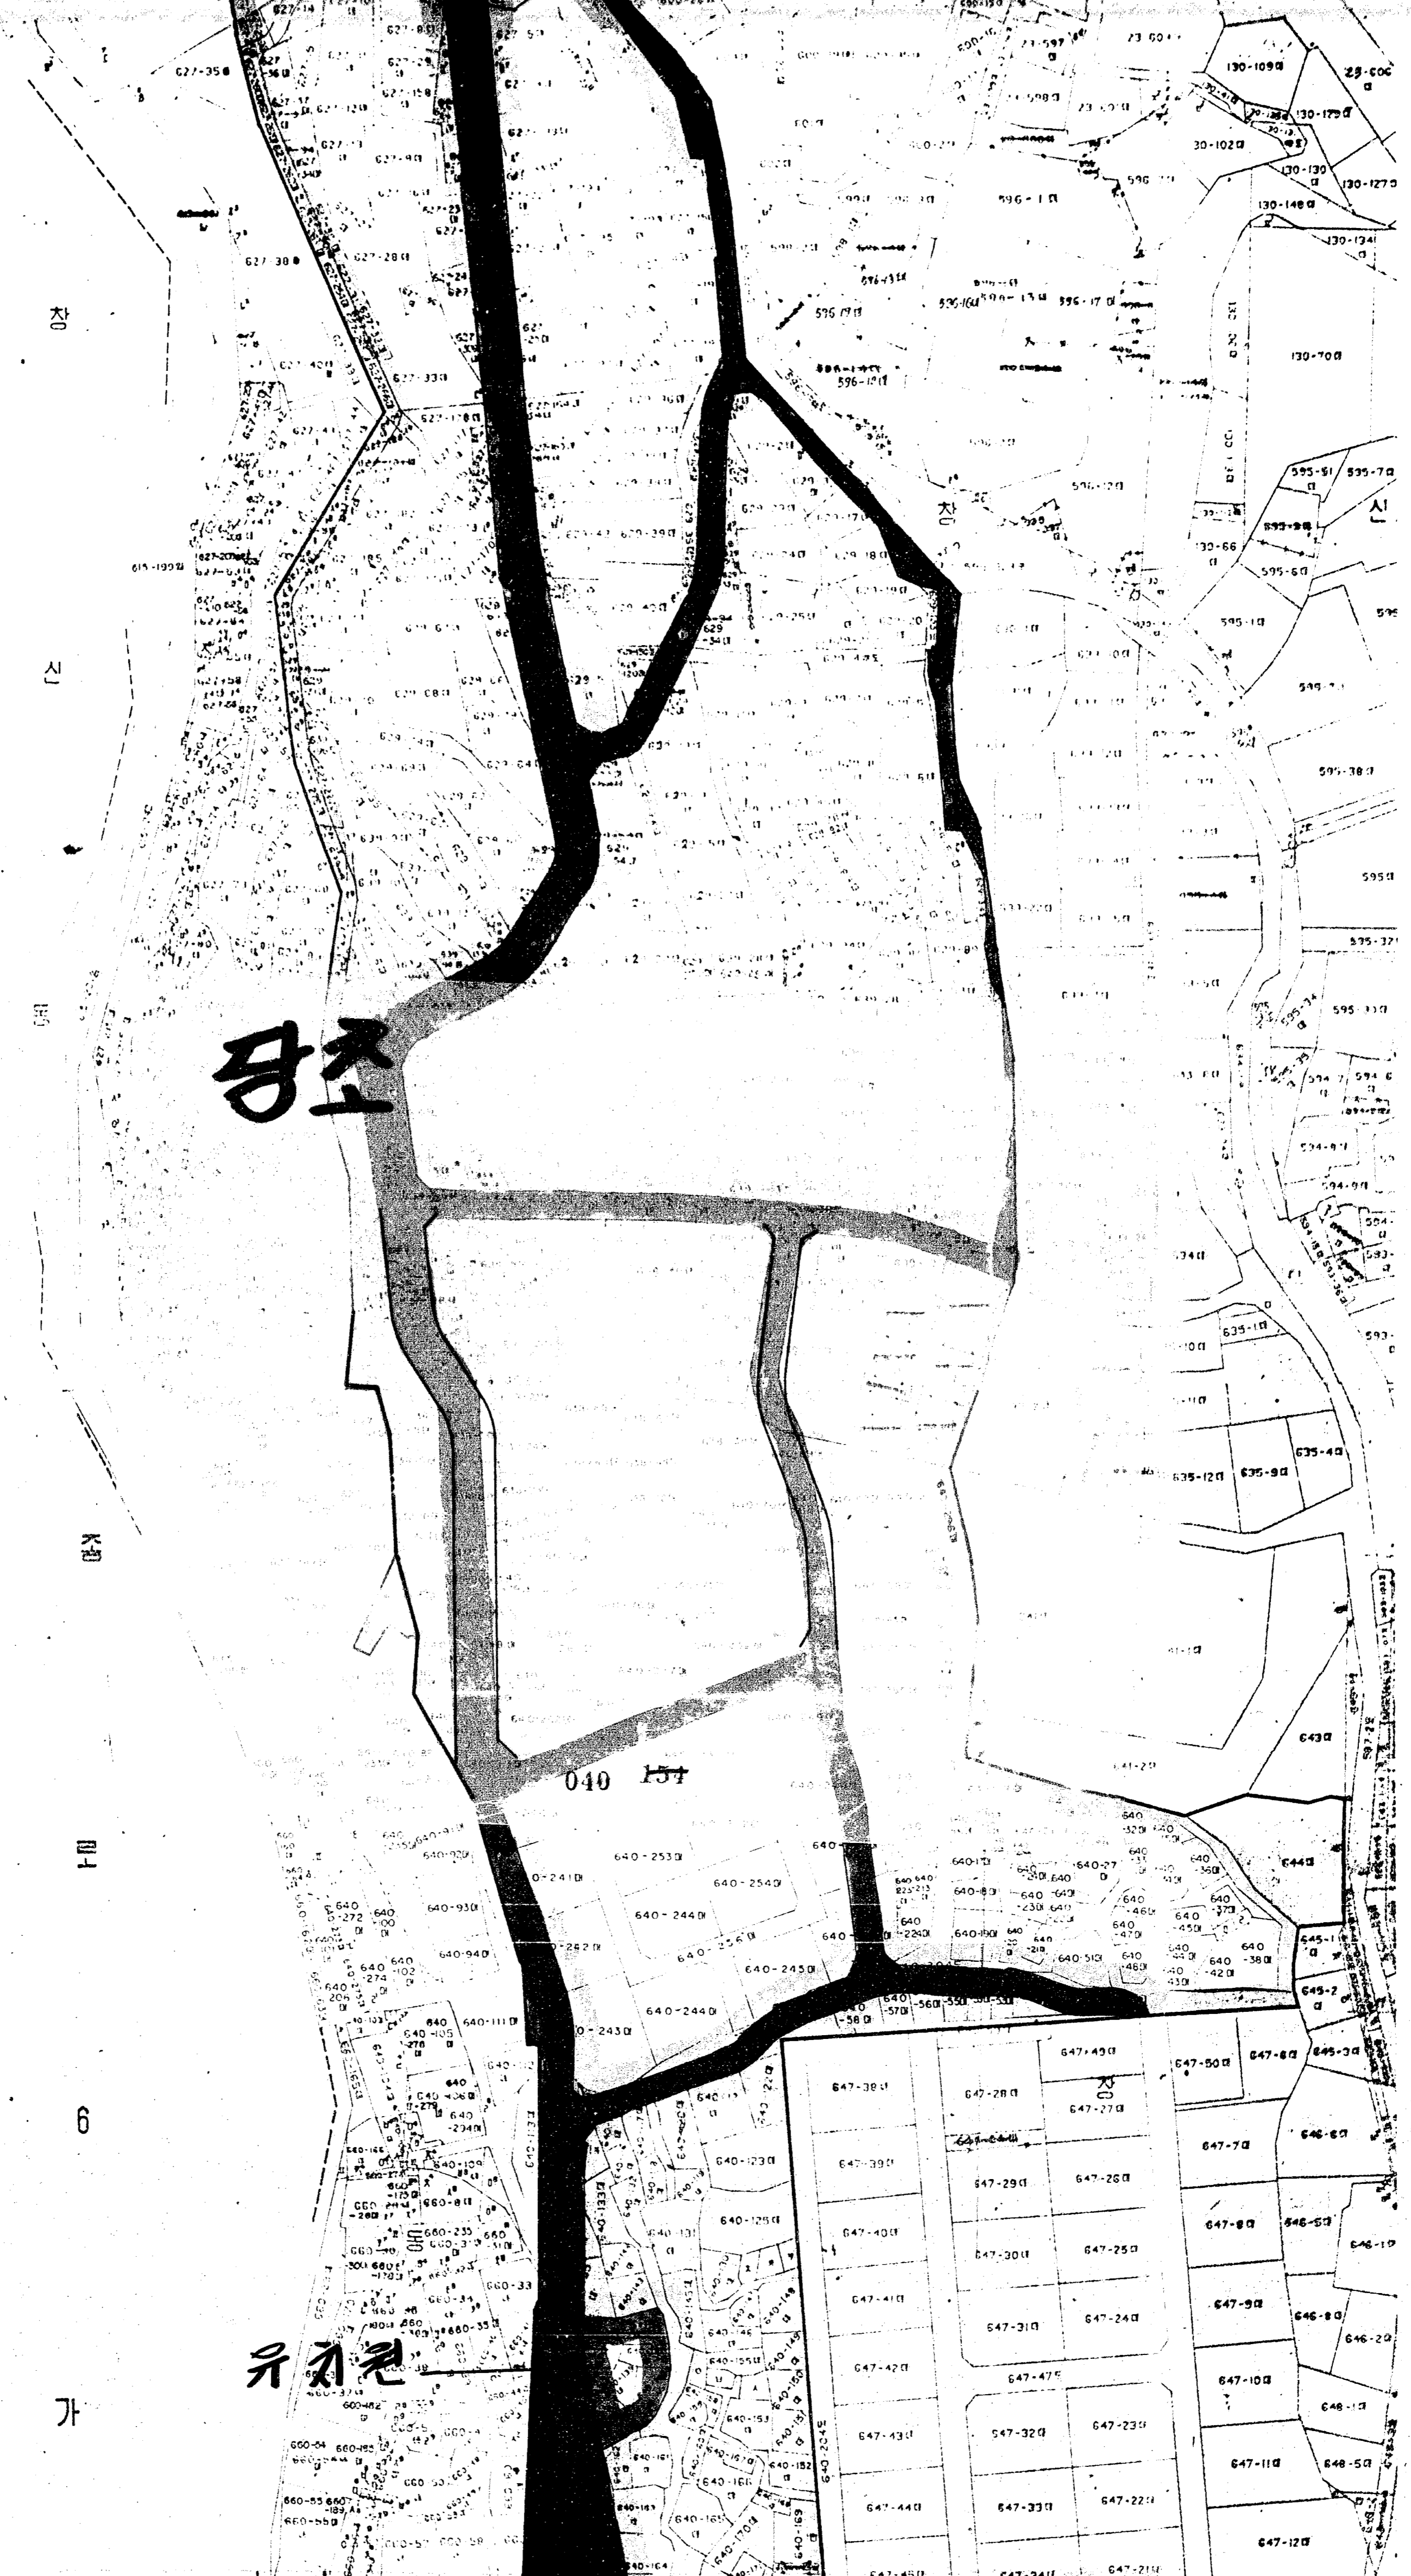

158

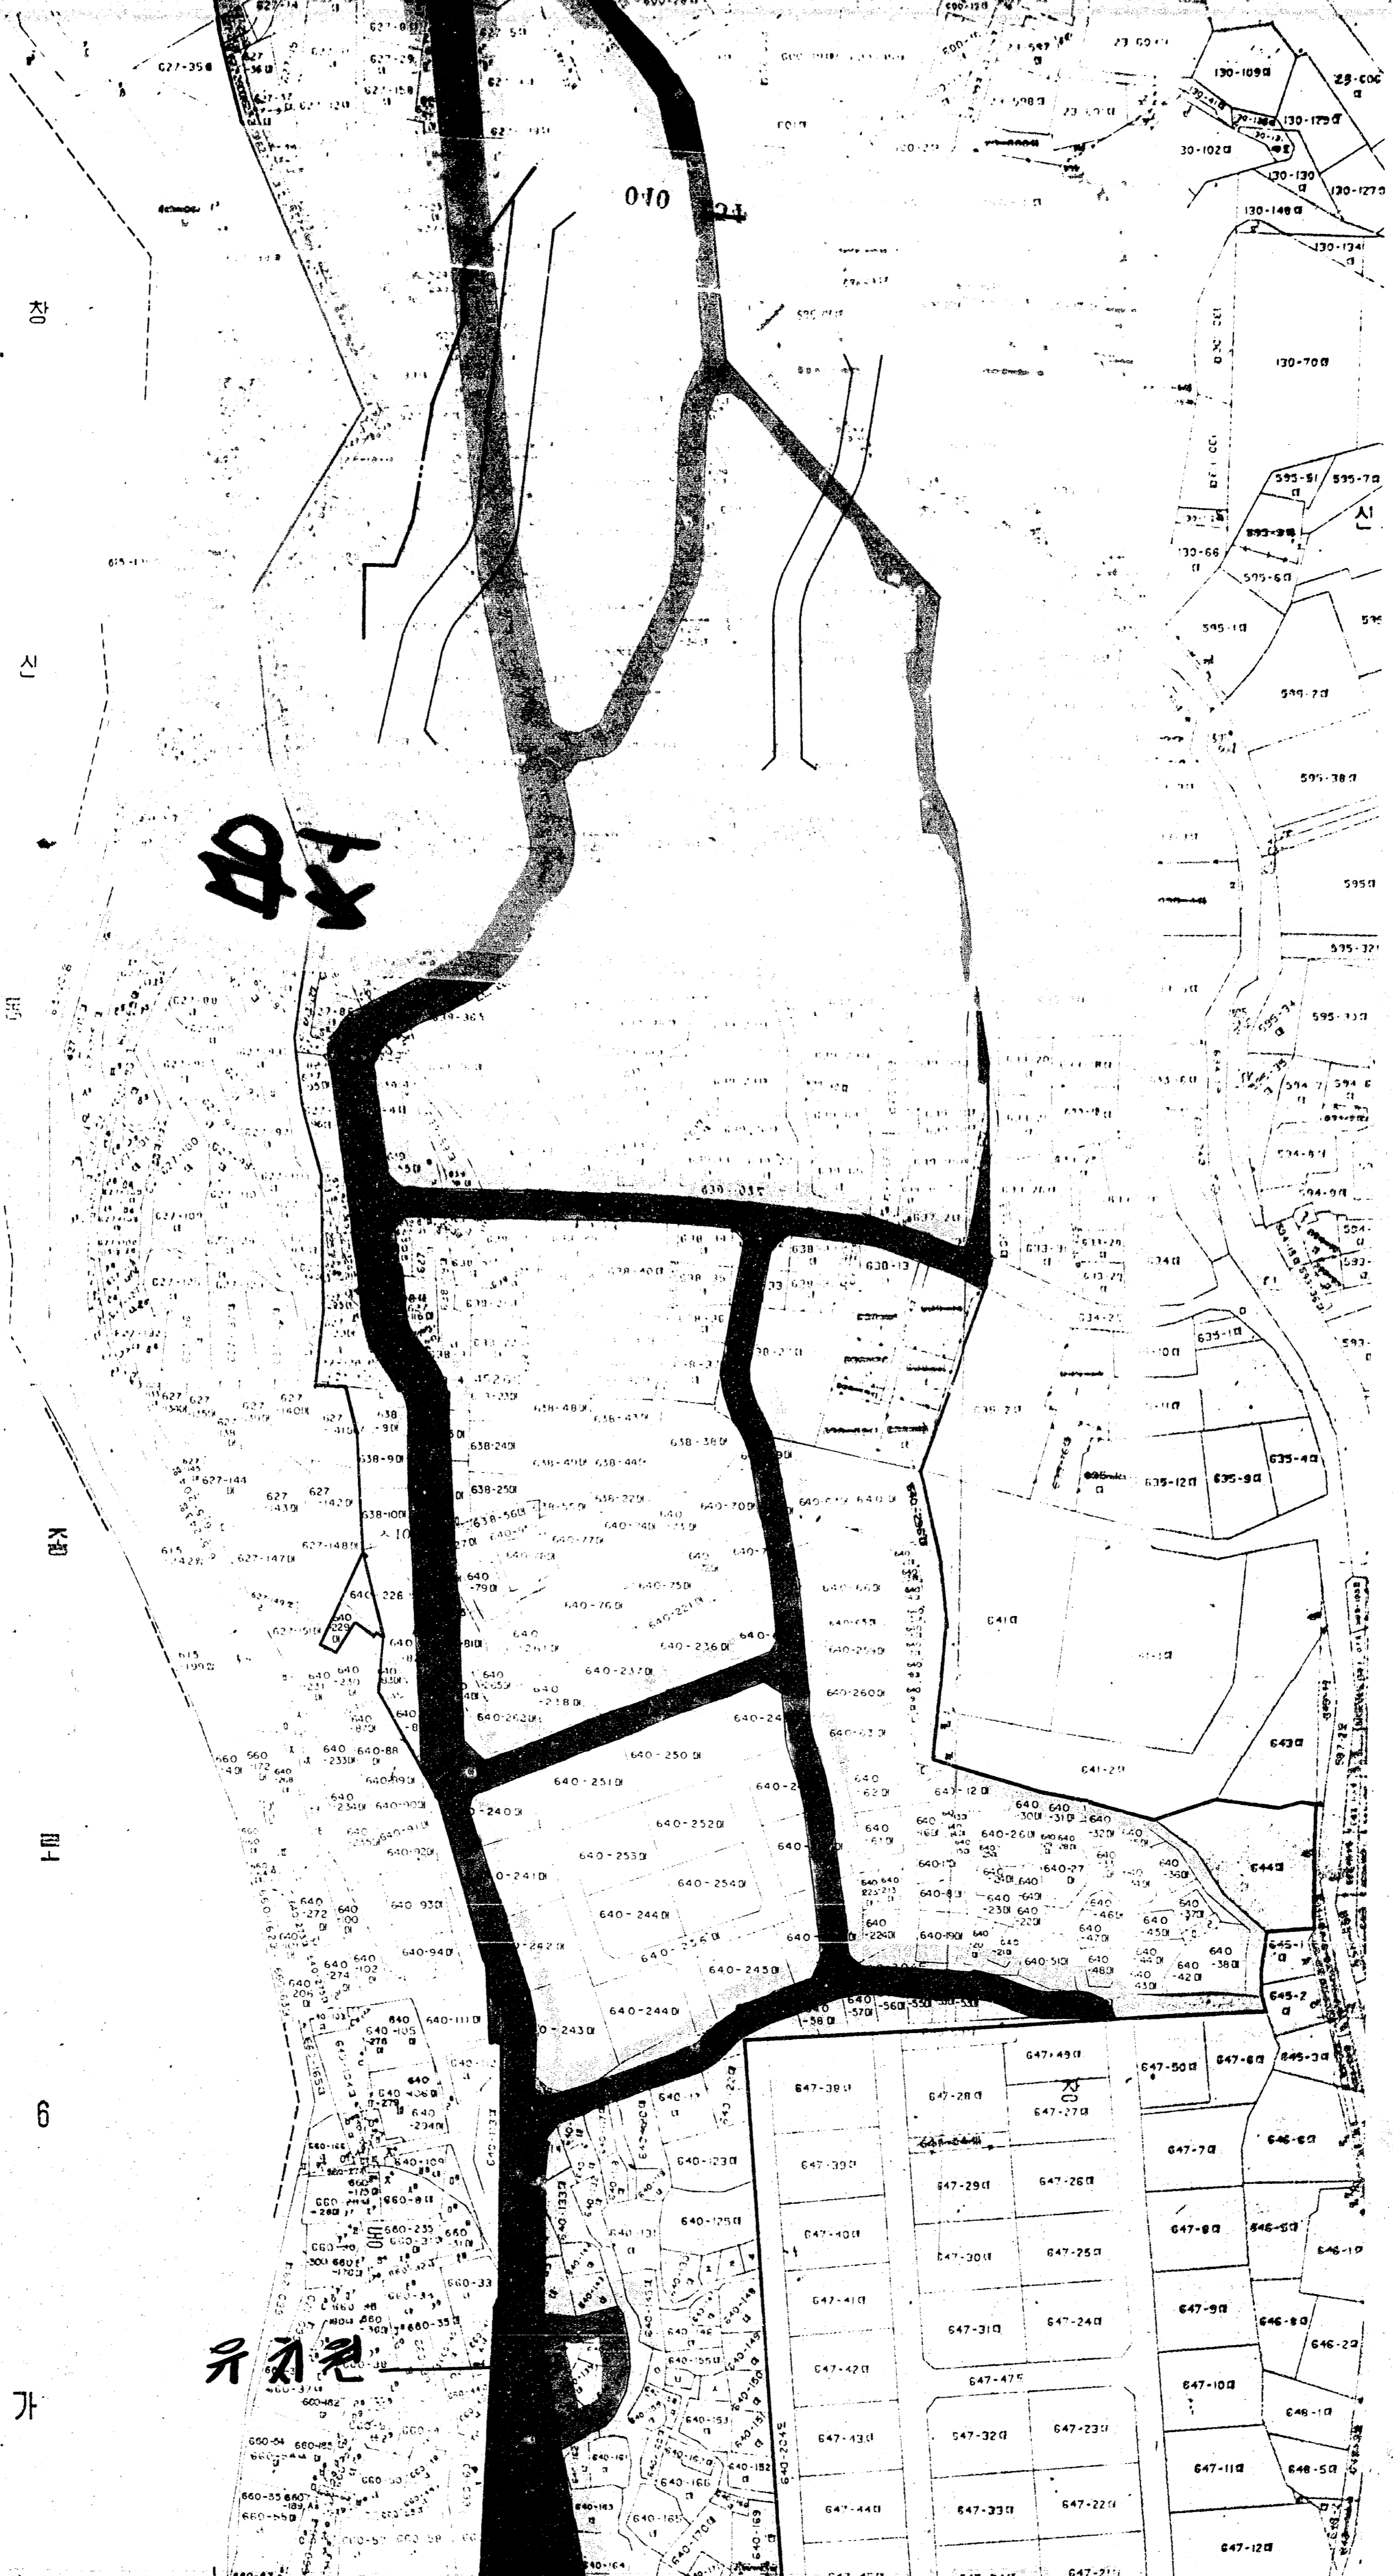

039

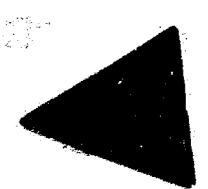

157

041



101

6

가

유치원

어린이 놀이장

마을크놀

K10

101

6

가

040 157

041

장

042

