



# 하수도관 이설 (D = 900mm)

위 치 : 가산동 319-7번지 앞

(매설현황)

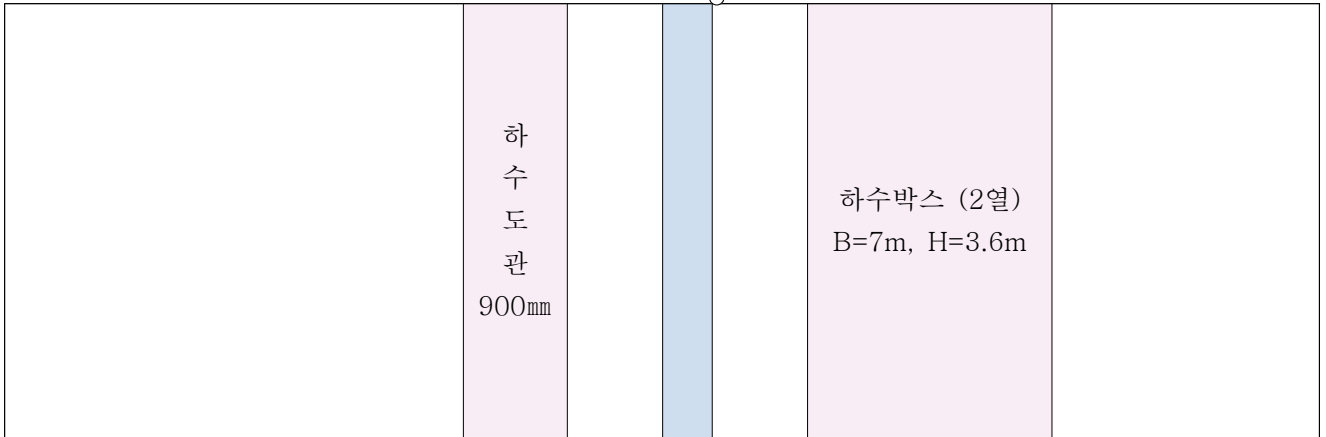

(임시폐쇄)

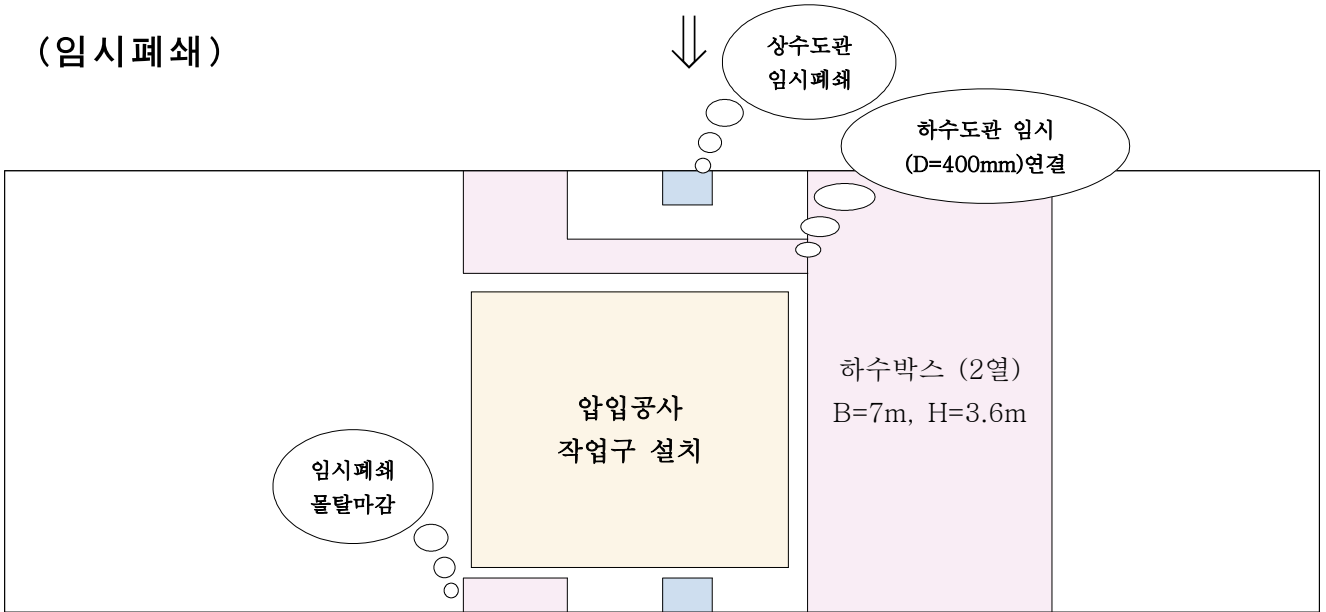

(원상복구)

