
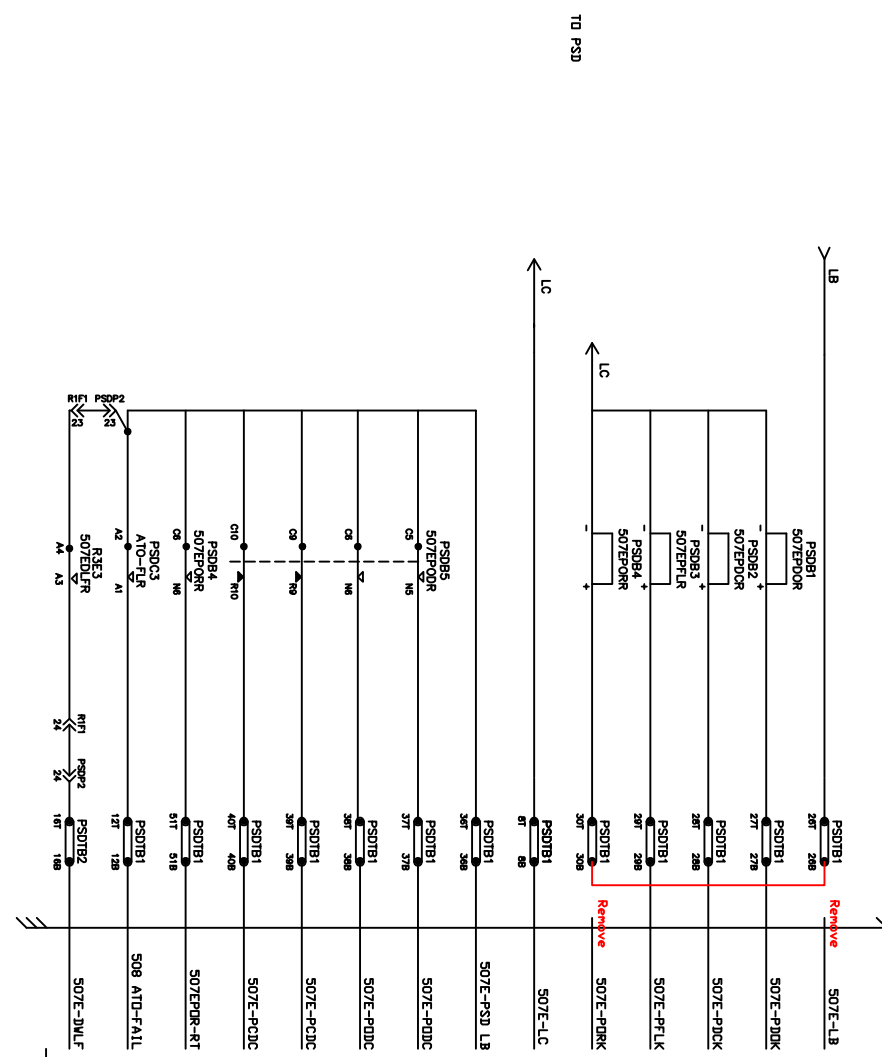



LINE CIRCUITS TO PSD

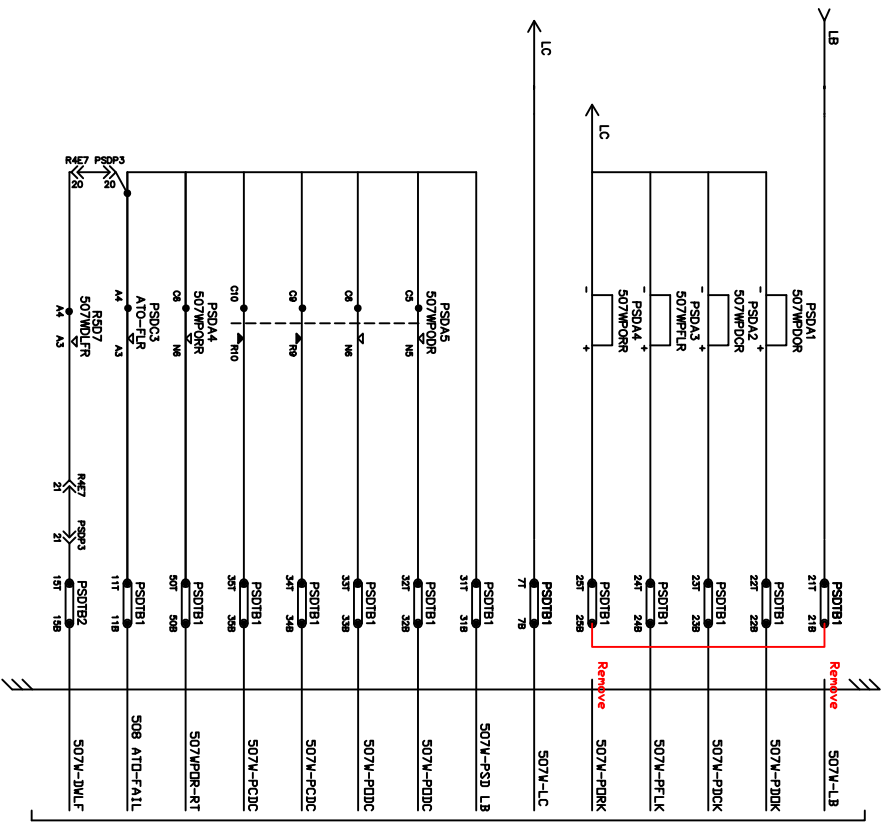

PDDK	PLATFORM SCREEN DOOR - DOOR OPEN INDICATION
PDDC	PLATFORM SCREEN DOOR - DOOR CLOSED INDICATION
PFLK	PLATFORM SCREEN DOOR - FAILURE INDICATION
PDRK	PLATFORM SCREEN DOOR - OVER RIDE INDICATION
PDDC	PLATFORM SCREEN DOOR - OPEN DOOR CONTROL
PDDC	PLATFORM SCREEN DOOR - CLOSED DOOR CONTROL

NOTE: ALL WIRES #18 UNLESS OTHERWISE NOTED.

공사명	서울특별시도시철도공사	시공	삼성에스디에스	날짜	계정서명	최종확인	삼성SSS	공사감독	시공차수	도면명칭	LINE CIRCUITS TO PSD
	5호선 양재역등 2개역 승강장 스크린도어 제작 구체설치(부대공사포함) - 신중공사		삼성에스디에스		계정번호		최종확인			도면번호	508-159
									날짜	2008. 12. 22	04074141
									날짜		508-160
											508FSD-0006.dwg

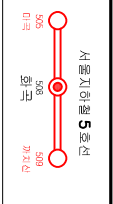

서울지하철 5호선
508
509
508
방향