


변경전 S=1:1200

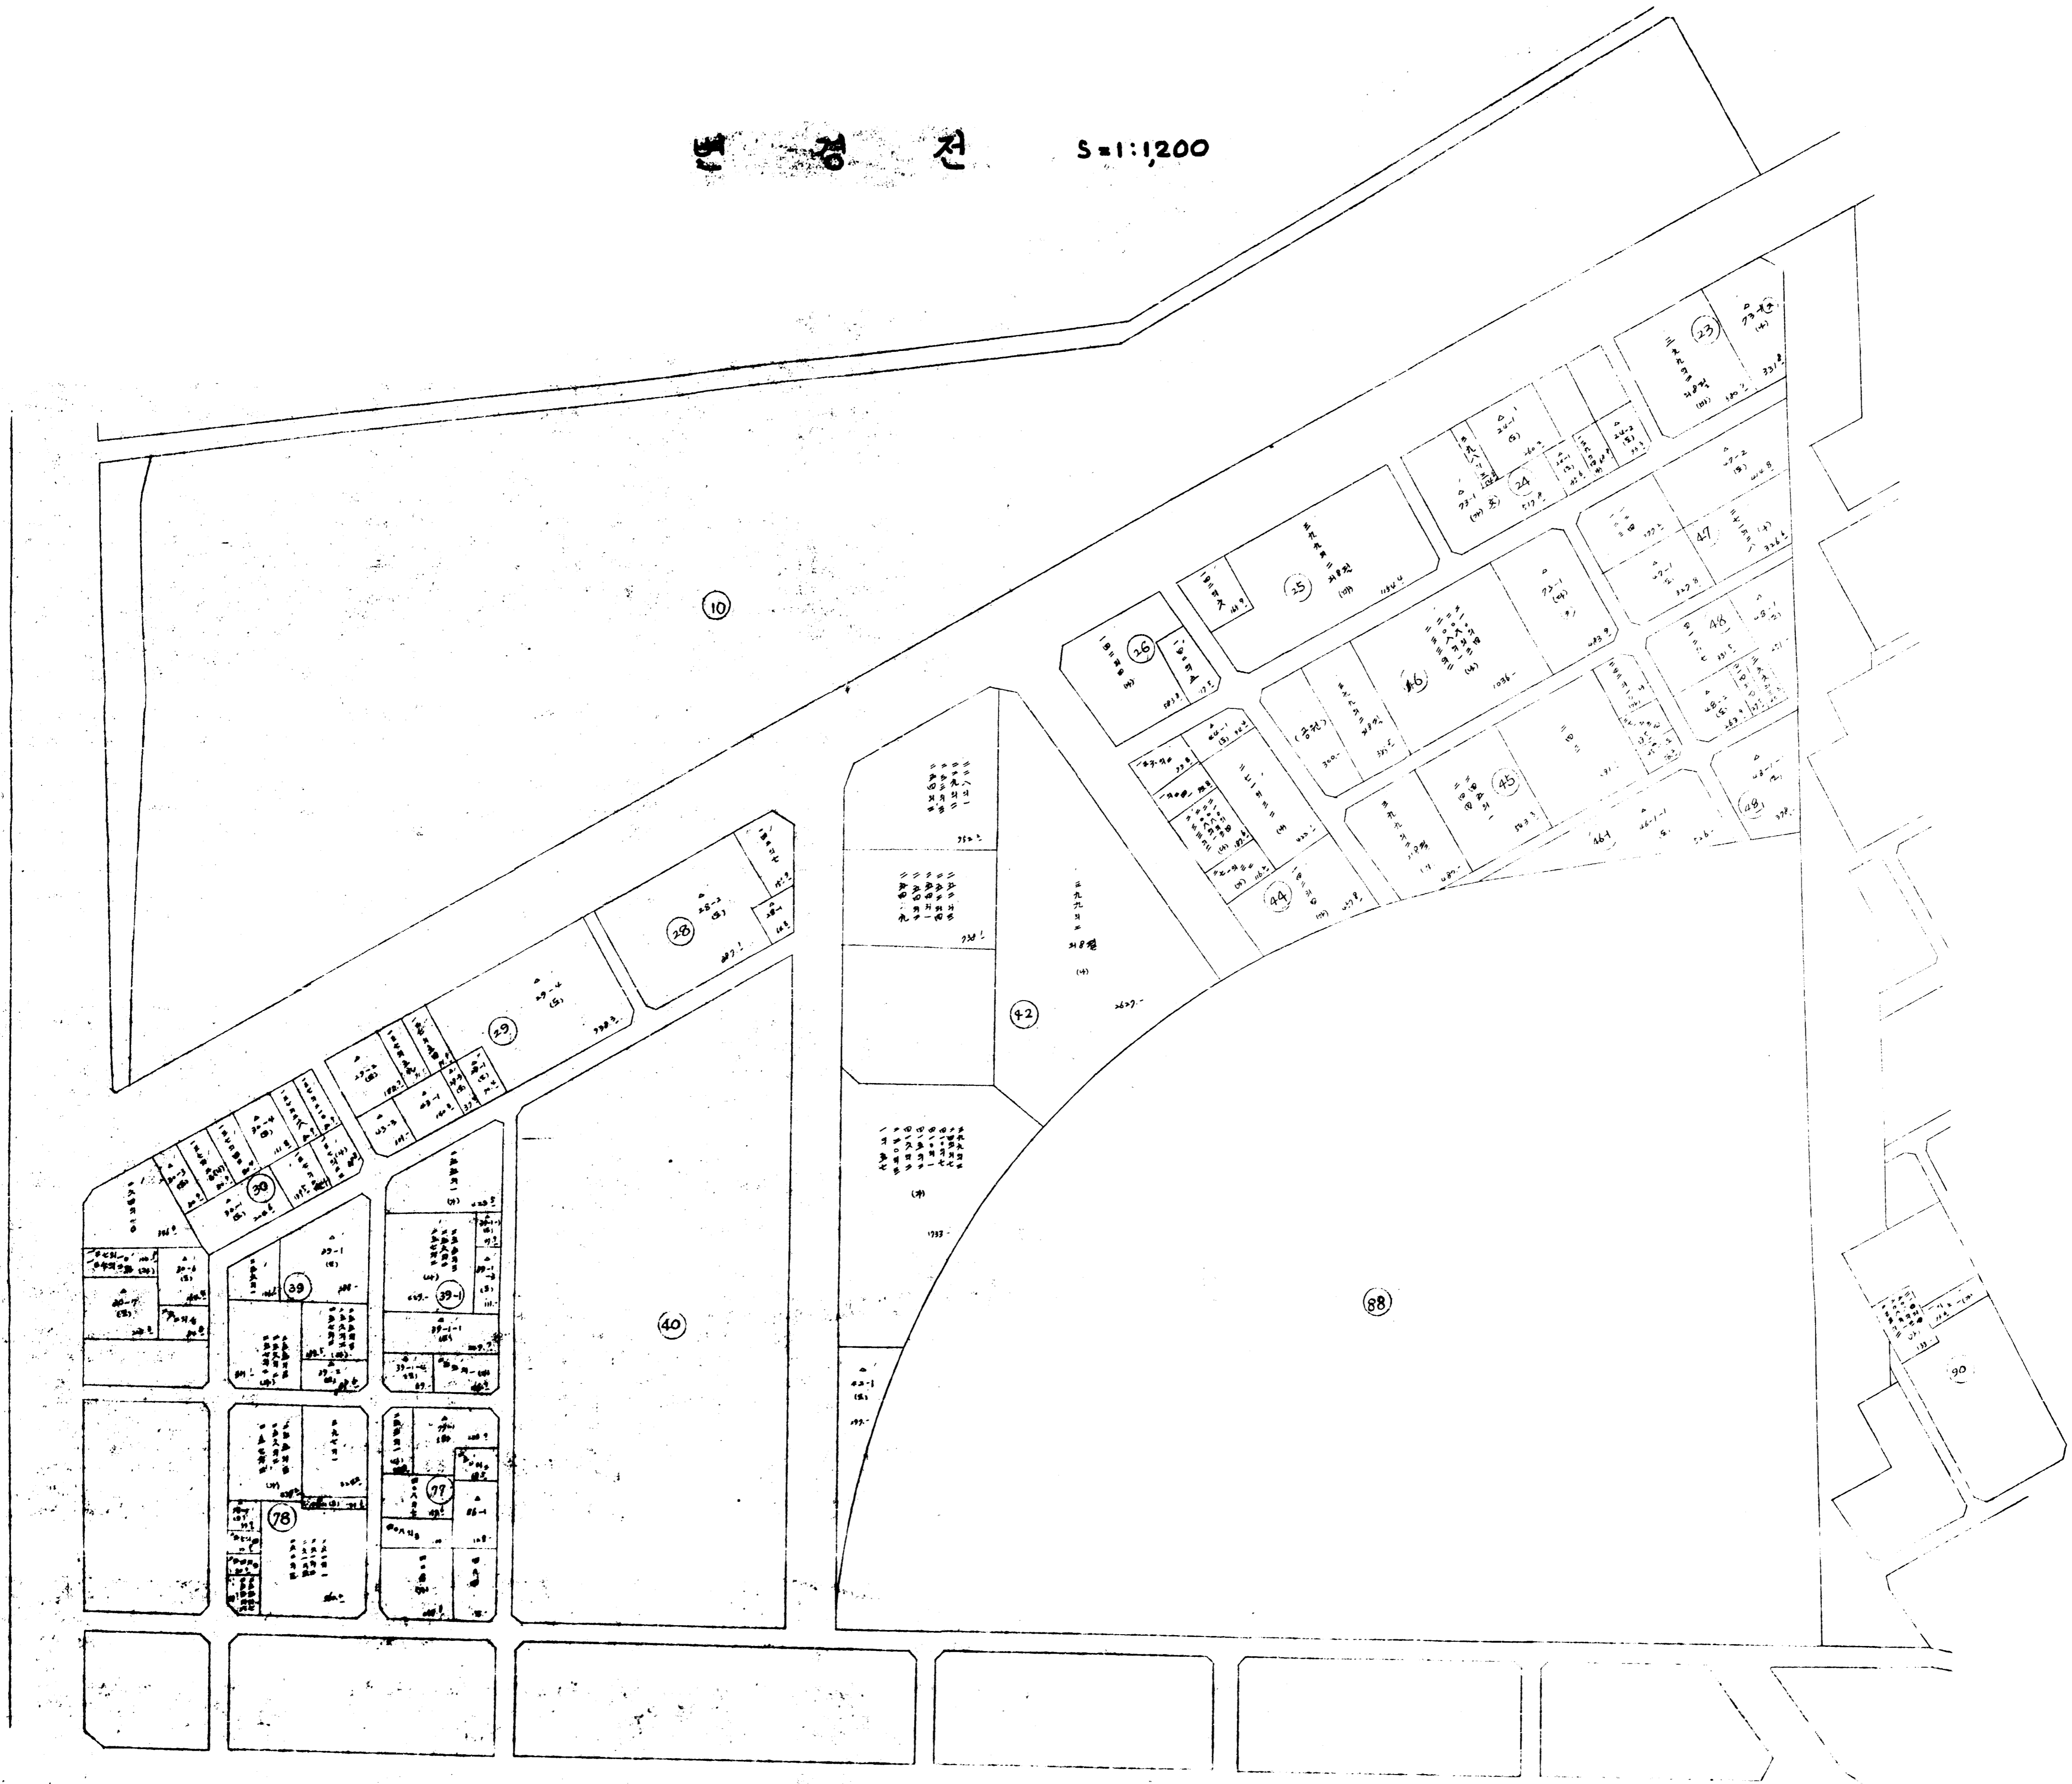

단 경 후 S=1:1,200

